


SEE 4-0-019-L

1105.37D.
1106

See New plat Sacc
Void This sheet

6931
APPROVED
LORAIN CO.
MAP DEPT.
DATE 4-25-73
4-00-030 F
BY L.H. Hall

040
~~008~~
~~26.43 F.~~
25.66 AC

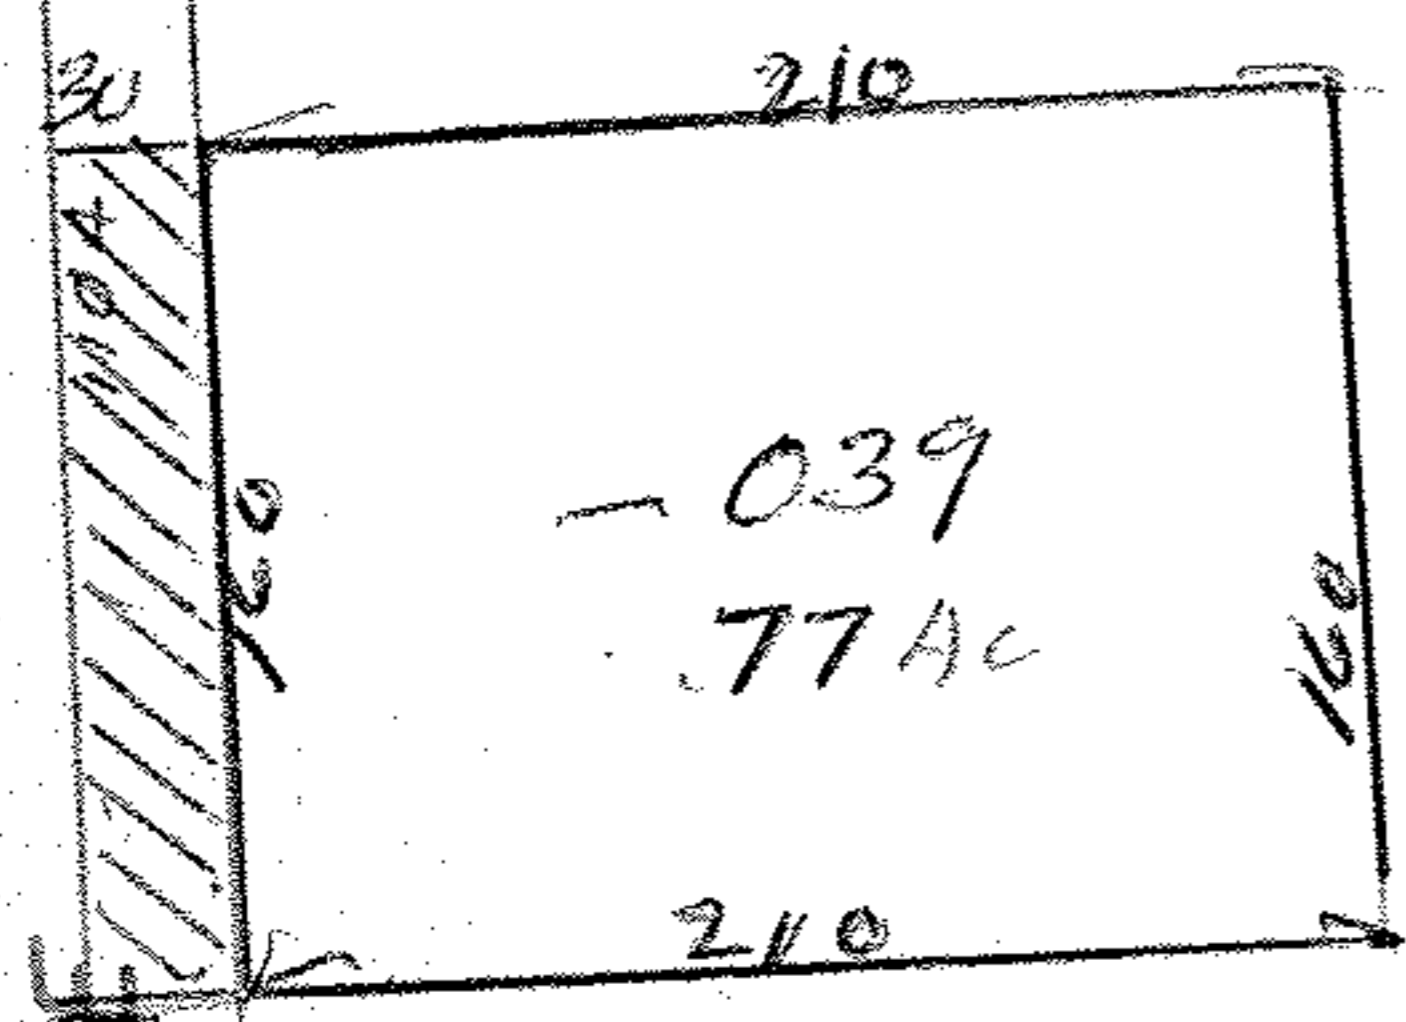

10
+ 160
33,600 sqft = .77 AC
43560

"Special"

Note This Land Division approved
subject to presentation of
a Deed conveying area cross hatched

160
30
4800 sqft = .11 AC L.H. Hall
43560

343.00
LEAF NAGLE

9376
43 50

86
EAS WALKER
43