

6931

040
~~008~~
~~26.43A.~~
25.55Ac


+
C' M - 0

P.R.S.

6931
APPROVED
LORAIN CO.
MAP DEPT.
DATE 4-25-73
4-00-030E
BY L W Hall

Pg 4-00-030E

LEARNAGLE
100 1104
3.00

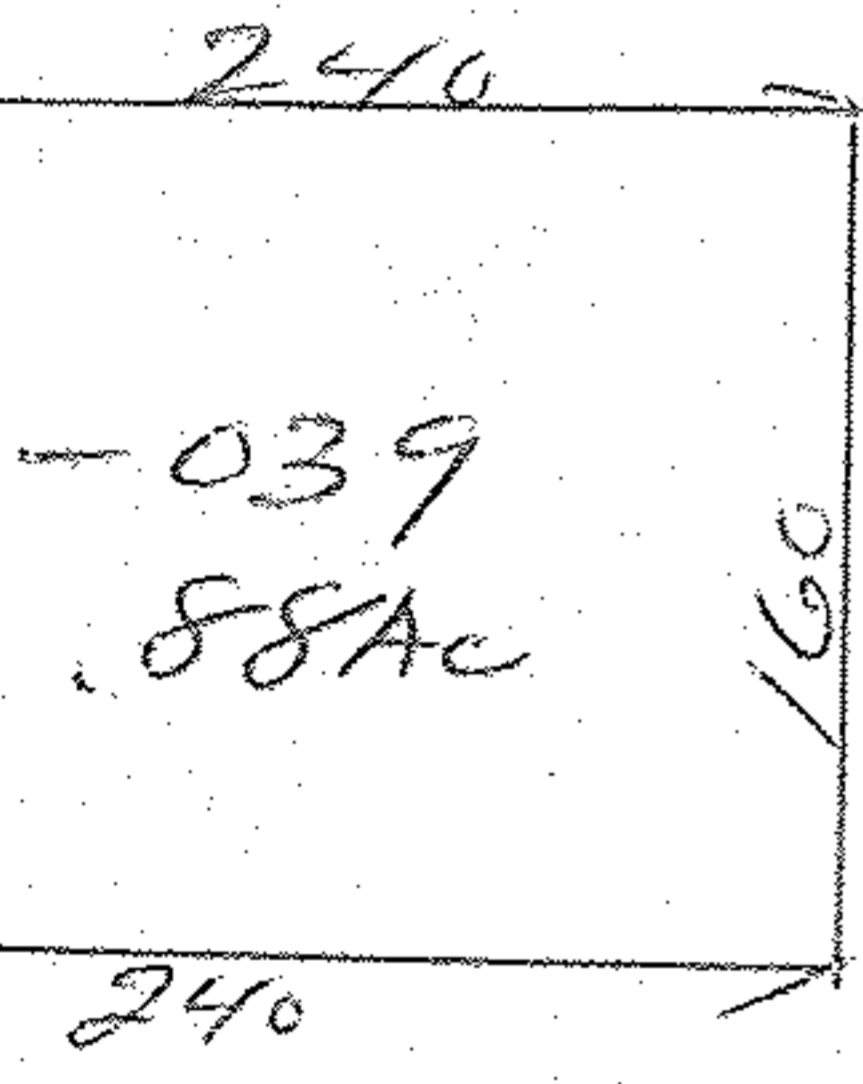

WALKER

SEE 4-L

AVON LAKE VILLAGE

SCALE: 1" = 100'