

SEE 4-00- '9-L

1105.37D.  
1106


6931

Void This Map  
but save  
LH Hall

6931

APPROVED  
LORAIN CO.  
MAP DEPT.  
DATE 4-25-73  
4-00-030A  
BY LH Hall

040  
~~008~~  
~~26.43A.~~  
25.66 AC

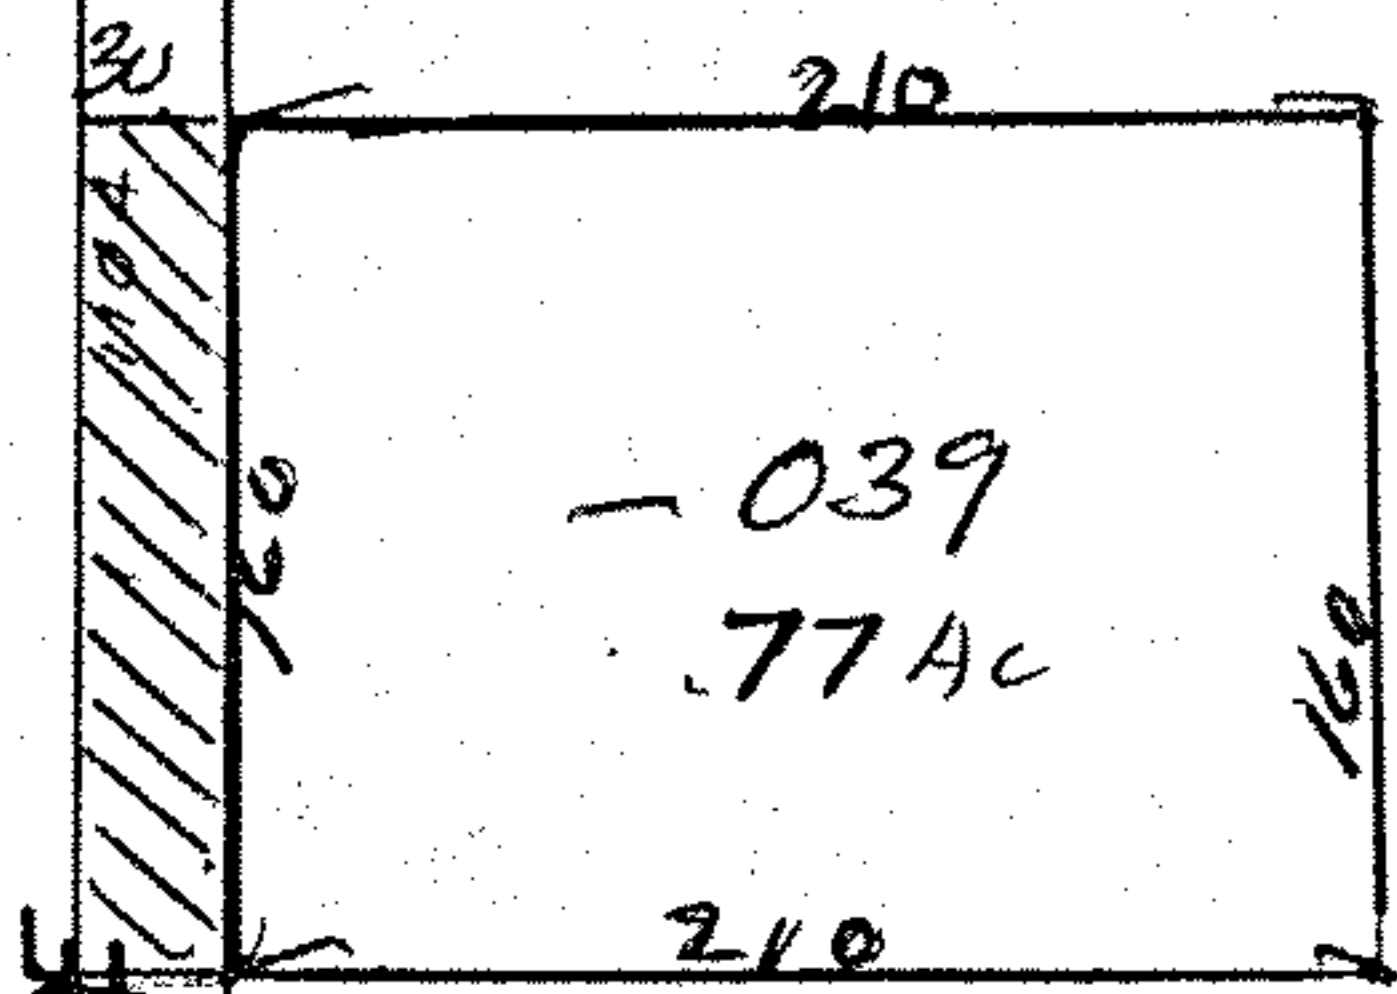

210  
x 160  
33,600 sqft = .77 AC  
43560

"Special"

Note This Land Division approved  
subject to presentation of  
a Deed conveying area cross hatched

160  
30  
4800 sqft = .11 AC LH Hall  
43560

343.00  
LEAR NAGLE

86 WALKER

SE