


6942

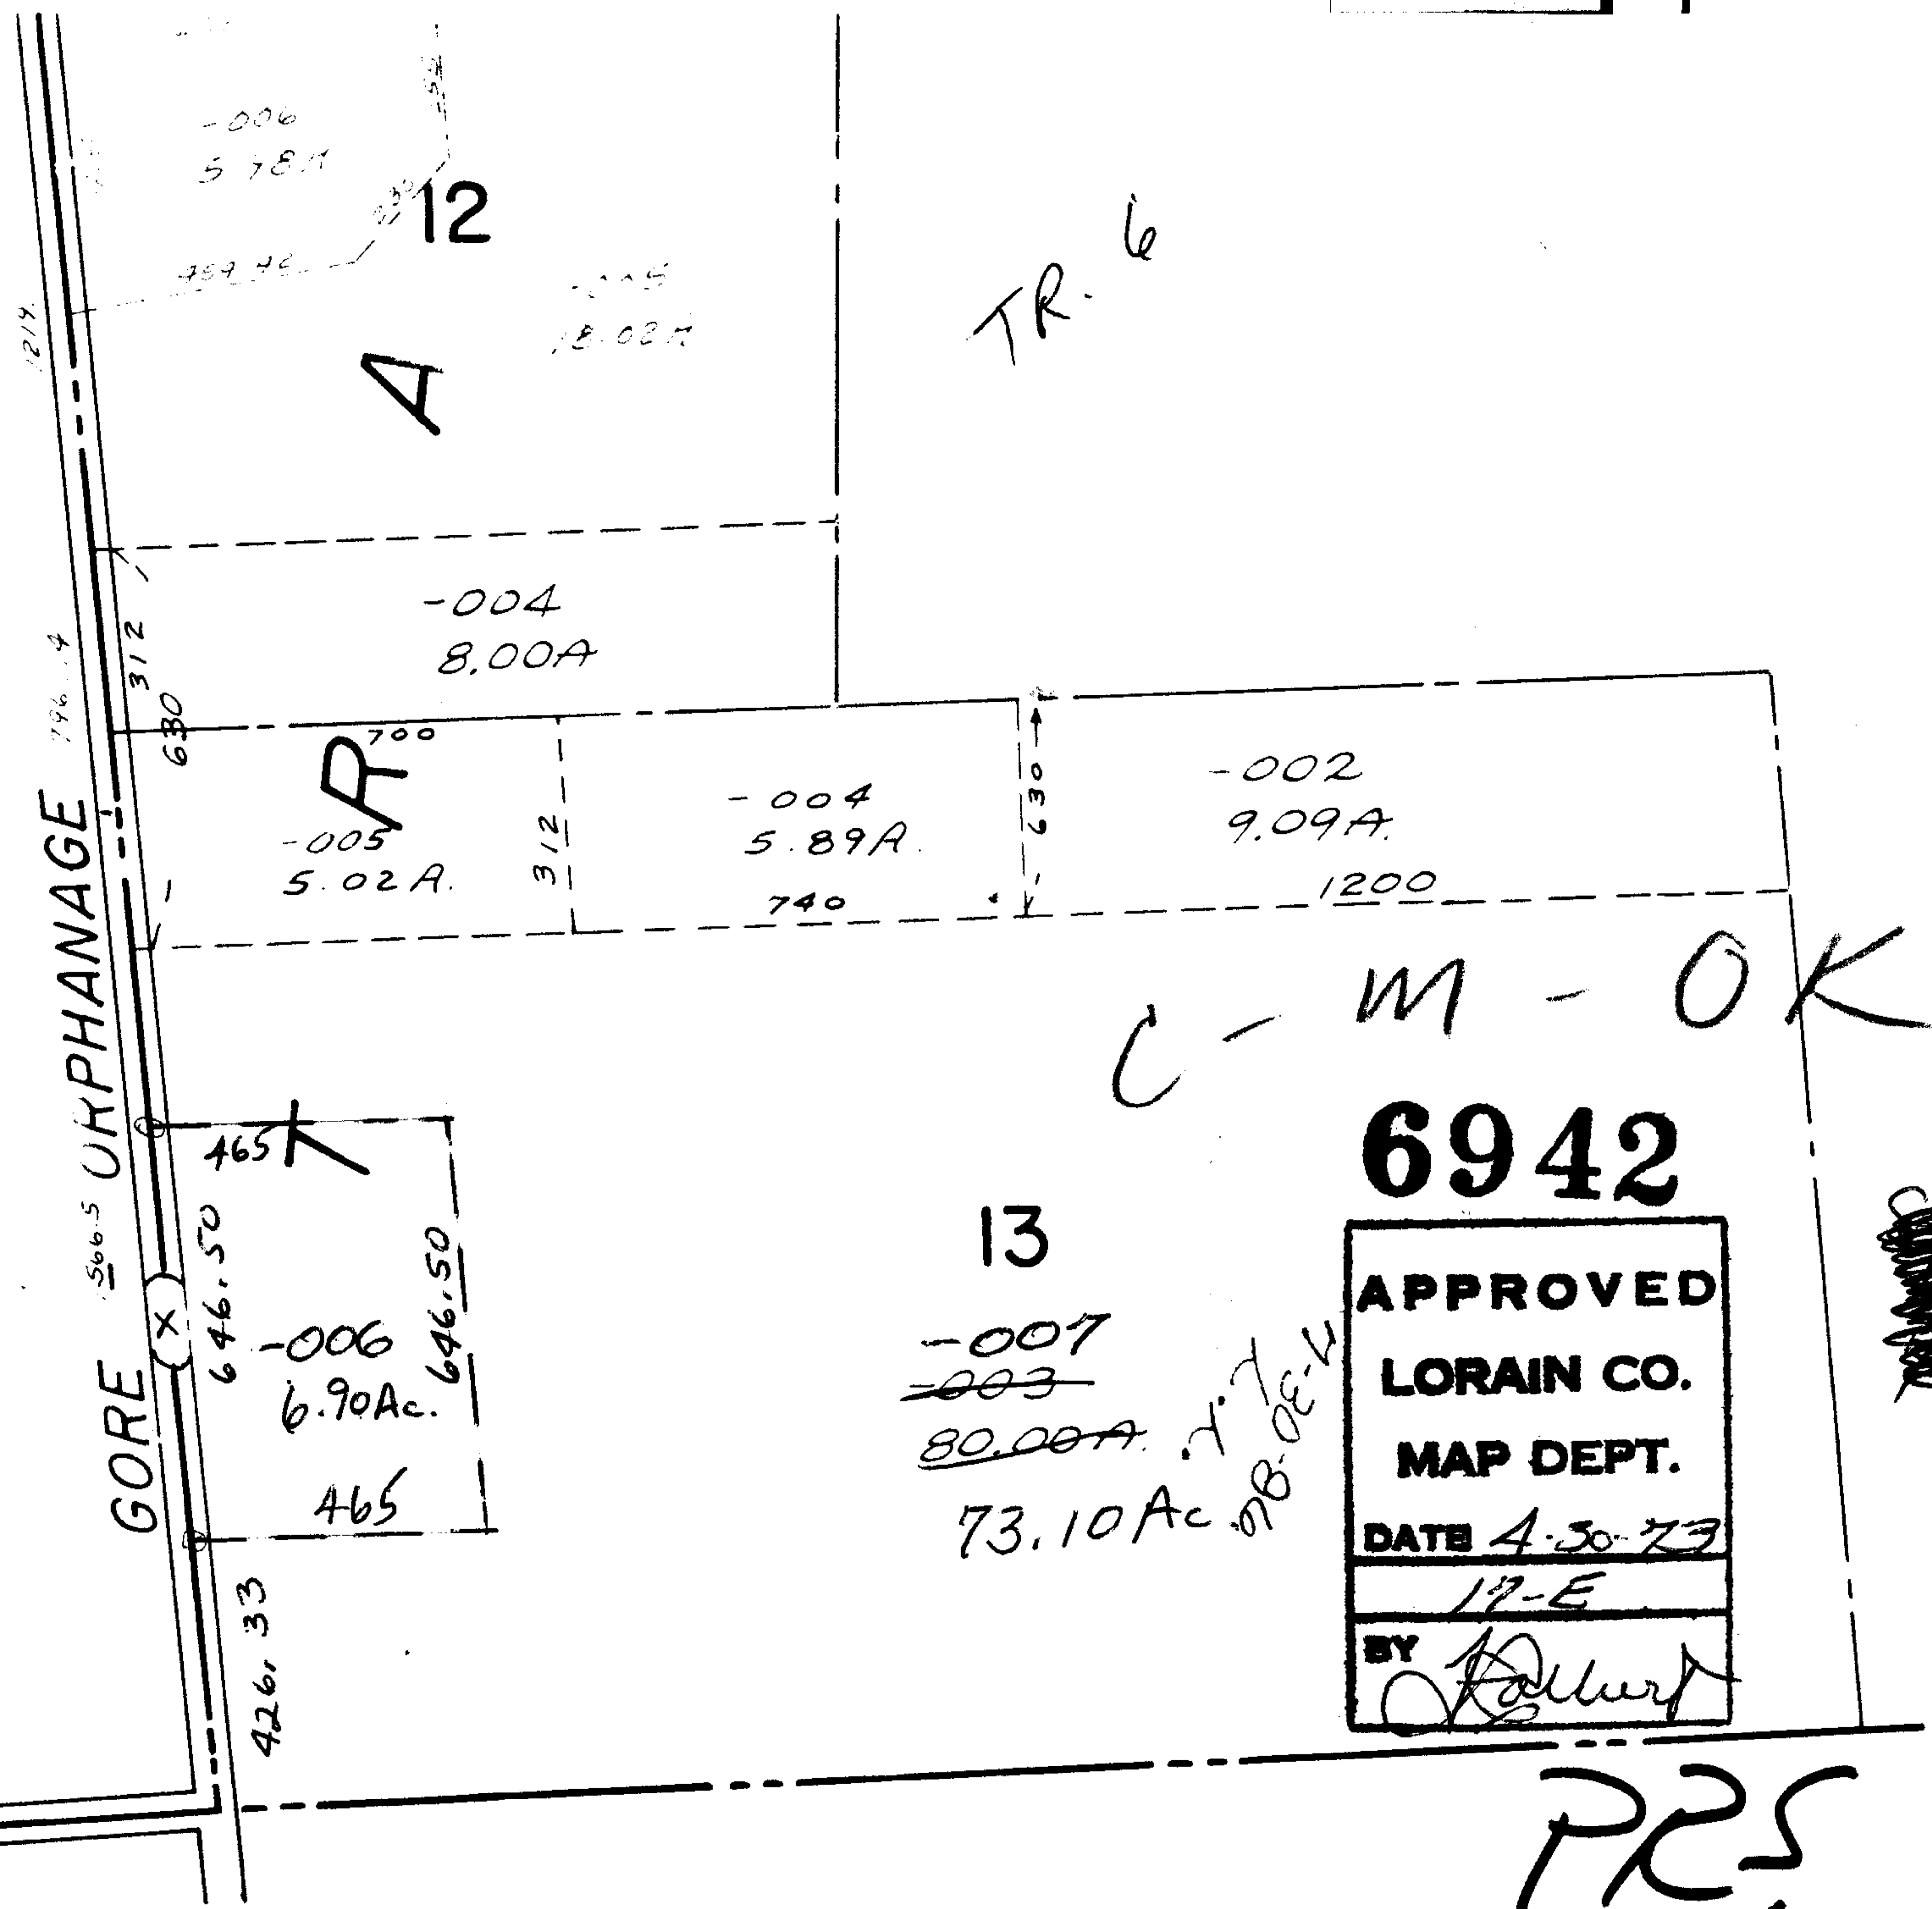

C-M-OK

6942

APPROVED
 LORAIN CO.
 MAP DEPT.
 DATE 4-30-73
 17-E
 BY *[Signature]*



PRS

204
50

2067 75

WP.

GORE STRIP LOTS 15, 16, & SLY.
 TRACT " " 1, 4, 5, 8, 12