

TR. 6.

17-G

(VERMIL)

-003
90.00A.

-001
20.00A.

P.R.S.


19
C.M. + OK

6944

-004
~~-002~~
~~91.27A.~~
86.27

APPROVED
LORAIN CO.
MAP DEPT.
DATE 4-30-73
176
BY L.W. Hall

7-30-86
L.H.

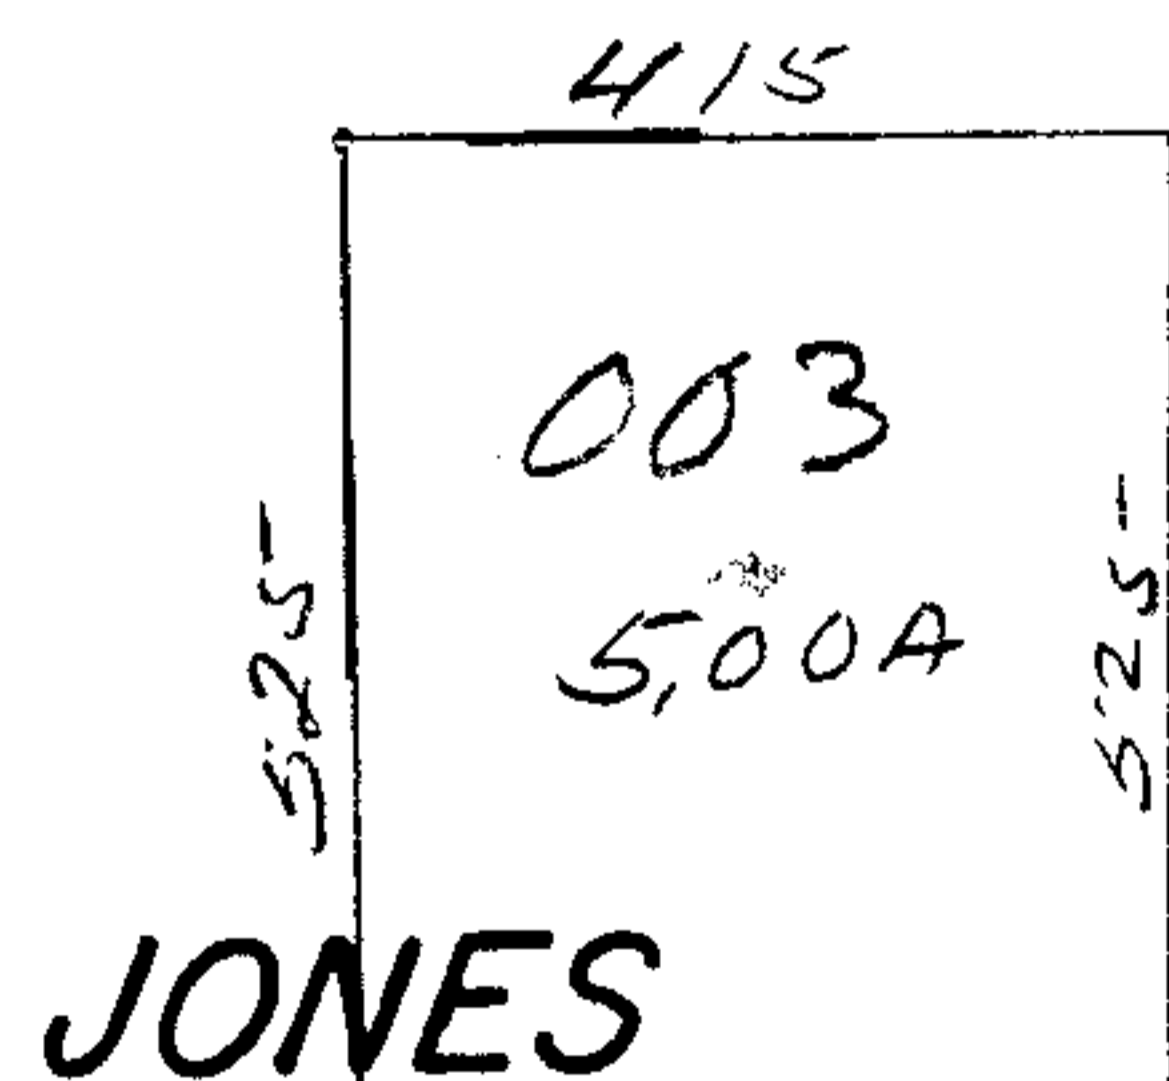


532.81

633.00

415

(X)

71.150.00
303.44

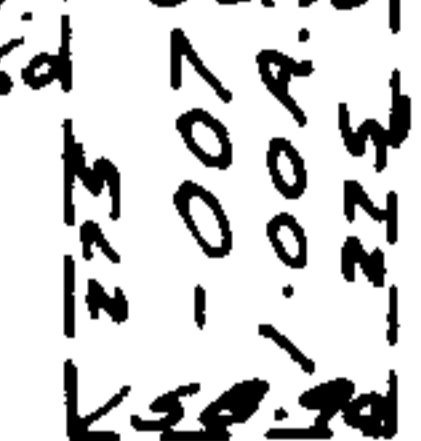

-003
51.25A.

-008
12.75A.

6944