


6946

236.62  
30  
266.62

267.96  
266.62  
01.34

P.R.S.

WONSTER AVENUE LAKE

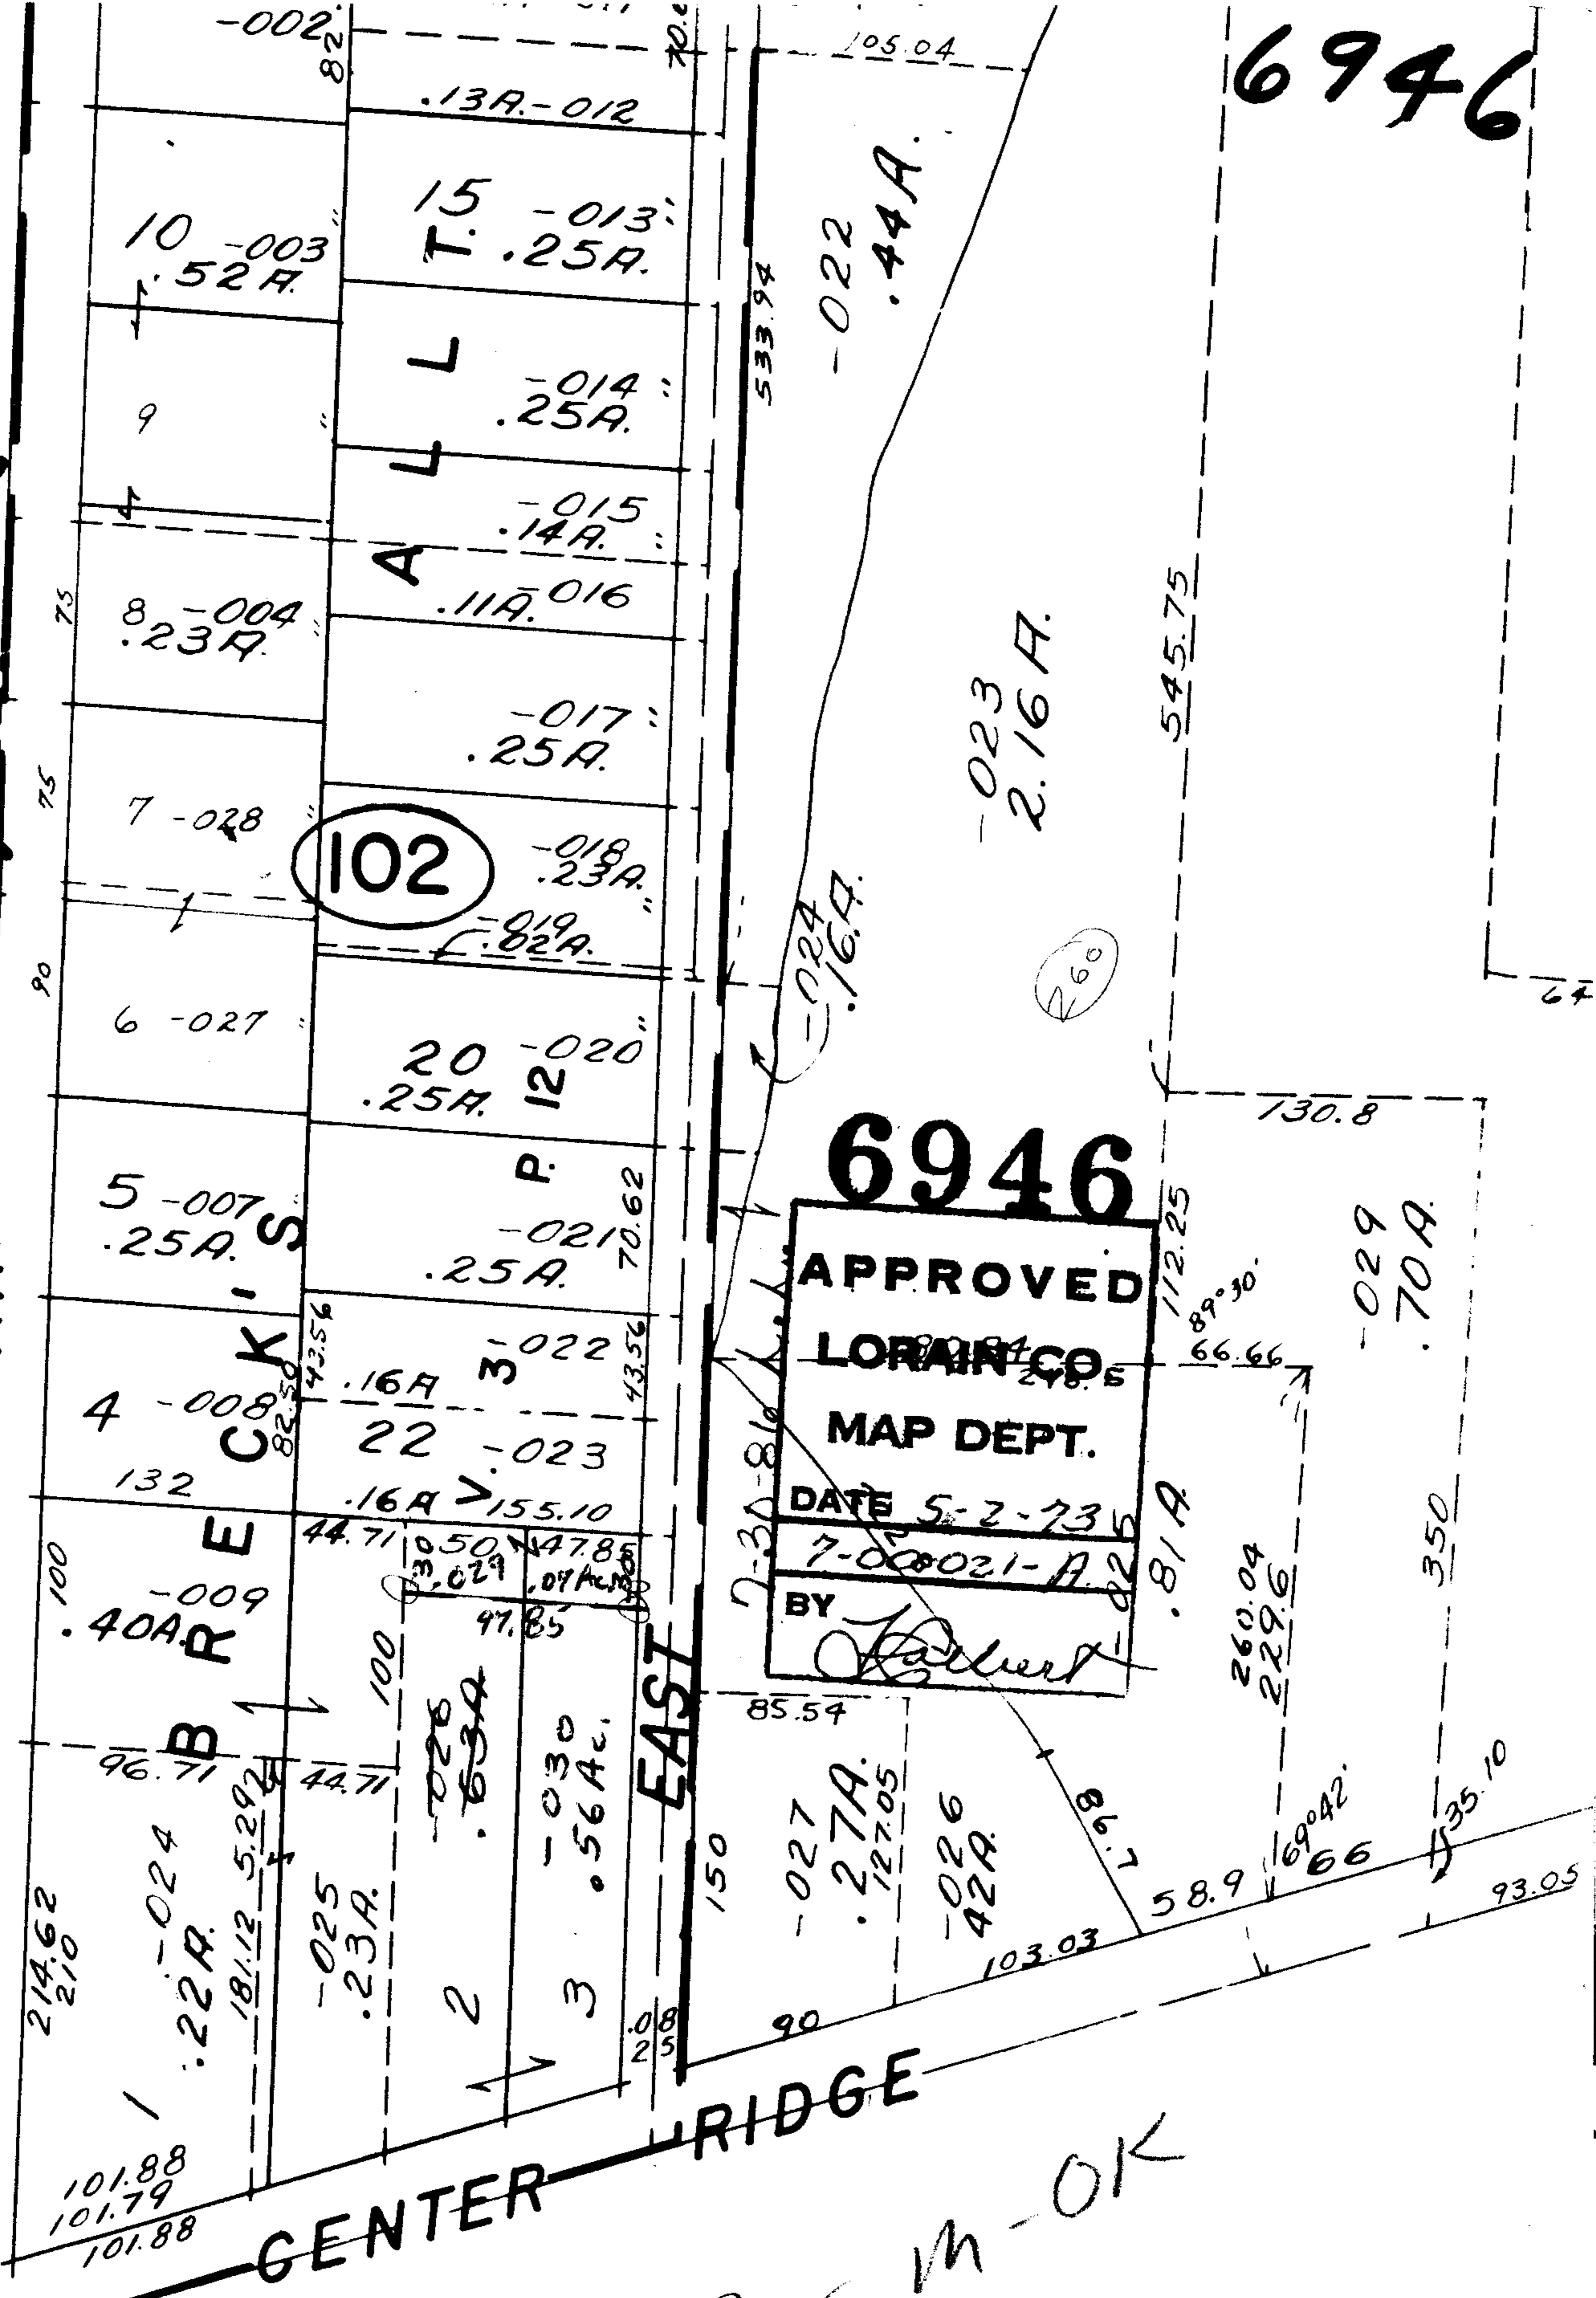

**6946**  
**APPROVED**  
**LORAIN CO.**  
**MAP DEPT.**  
**DATE 5-2-73**  
**7-00-021-A**  
**BY** *[Signature]*

C-M-OK

Pg. 7-00-021-A