

6985

NO

6985

APPROVED
LORAIN CO.
MAP DEPT.

DATE 5-14-73


3-00-070-A

BY *Hollard*

[Handwritten signature]

Measurement

~~629 72~~

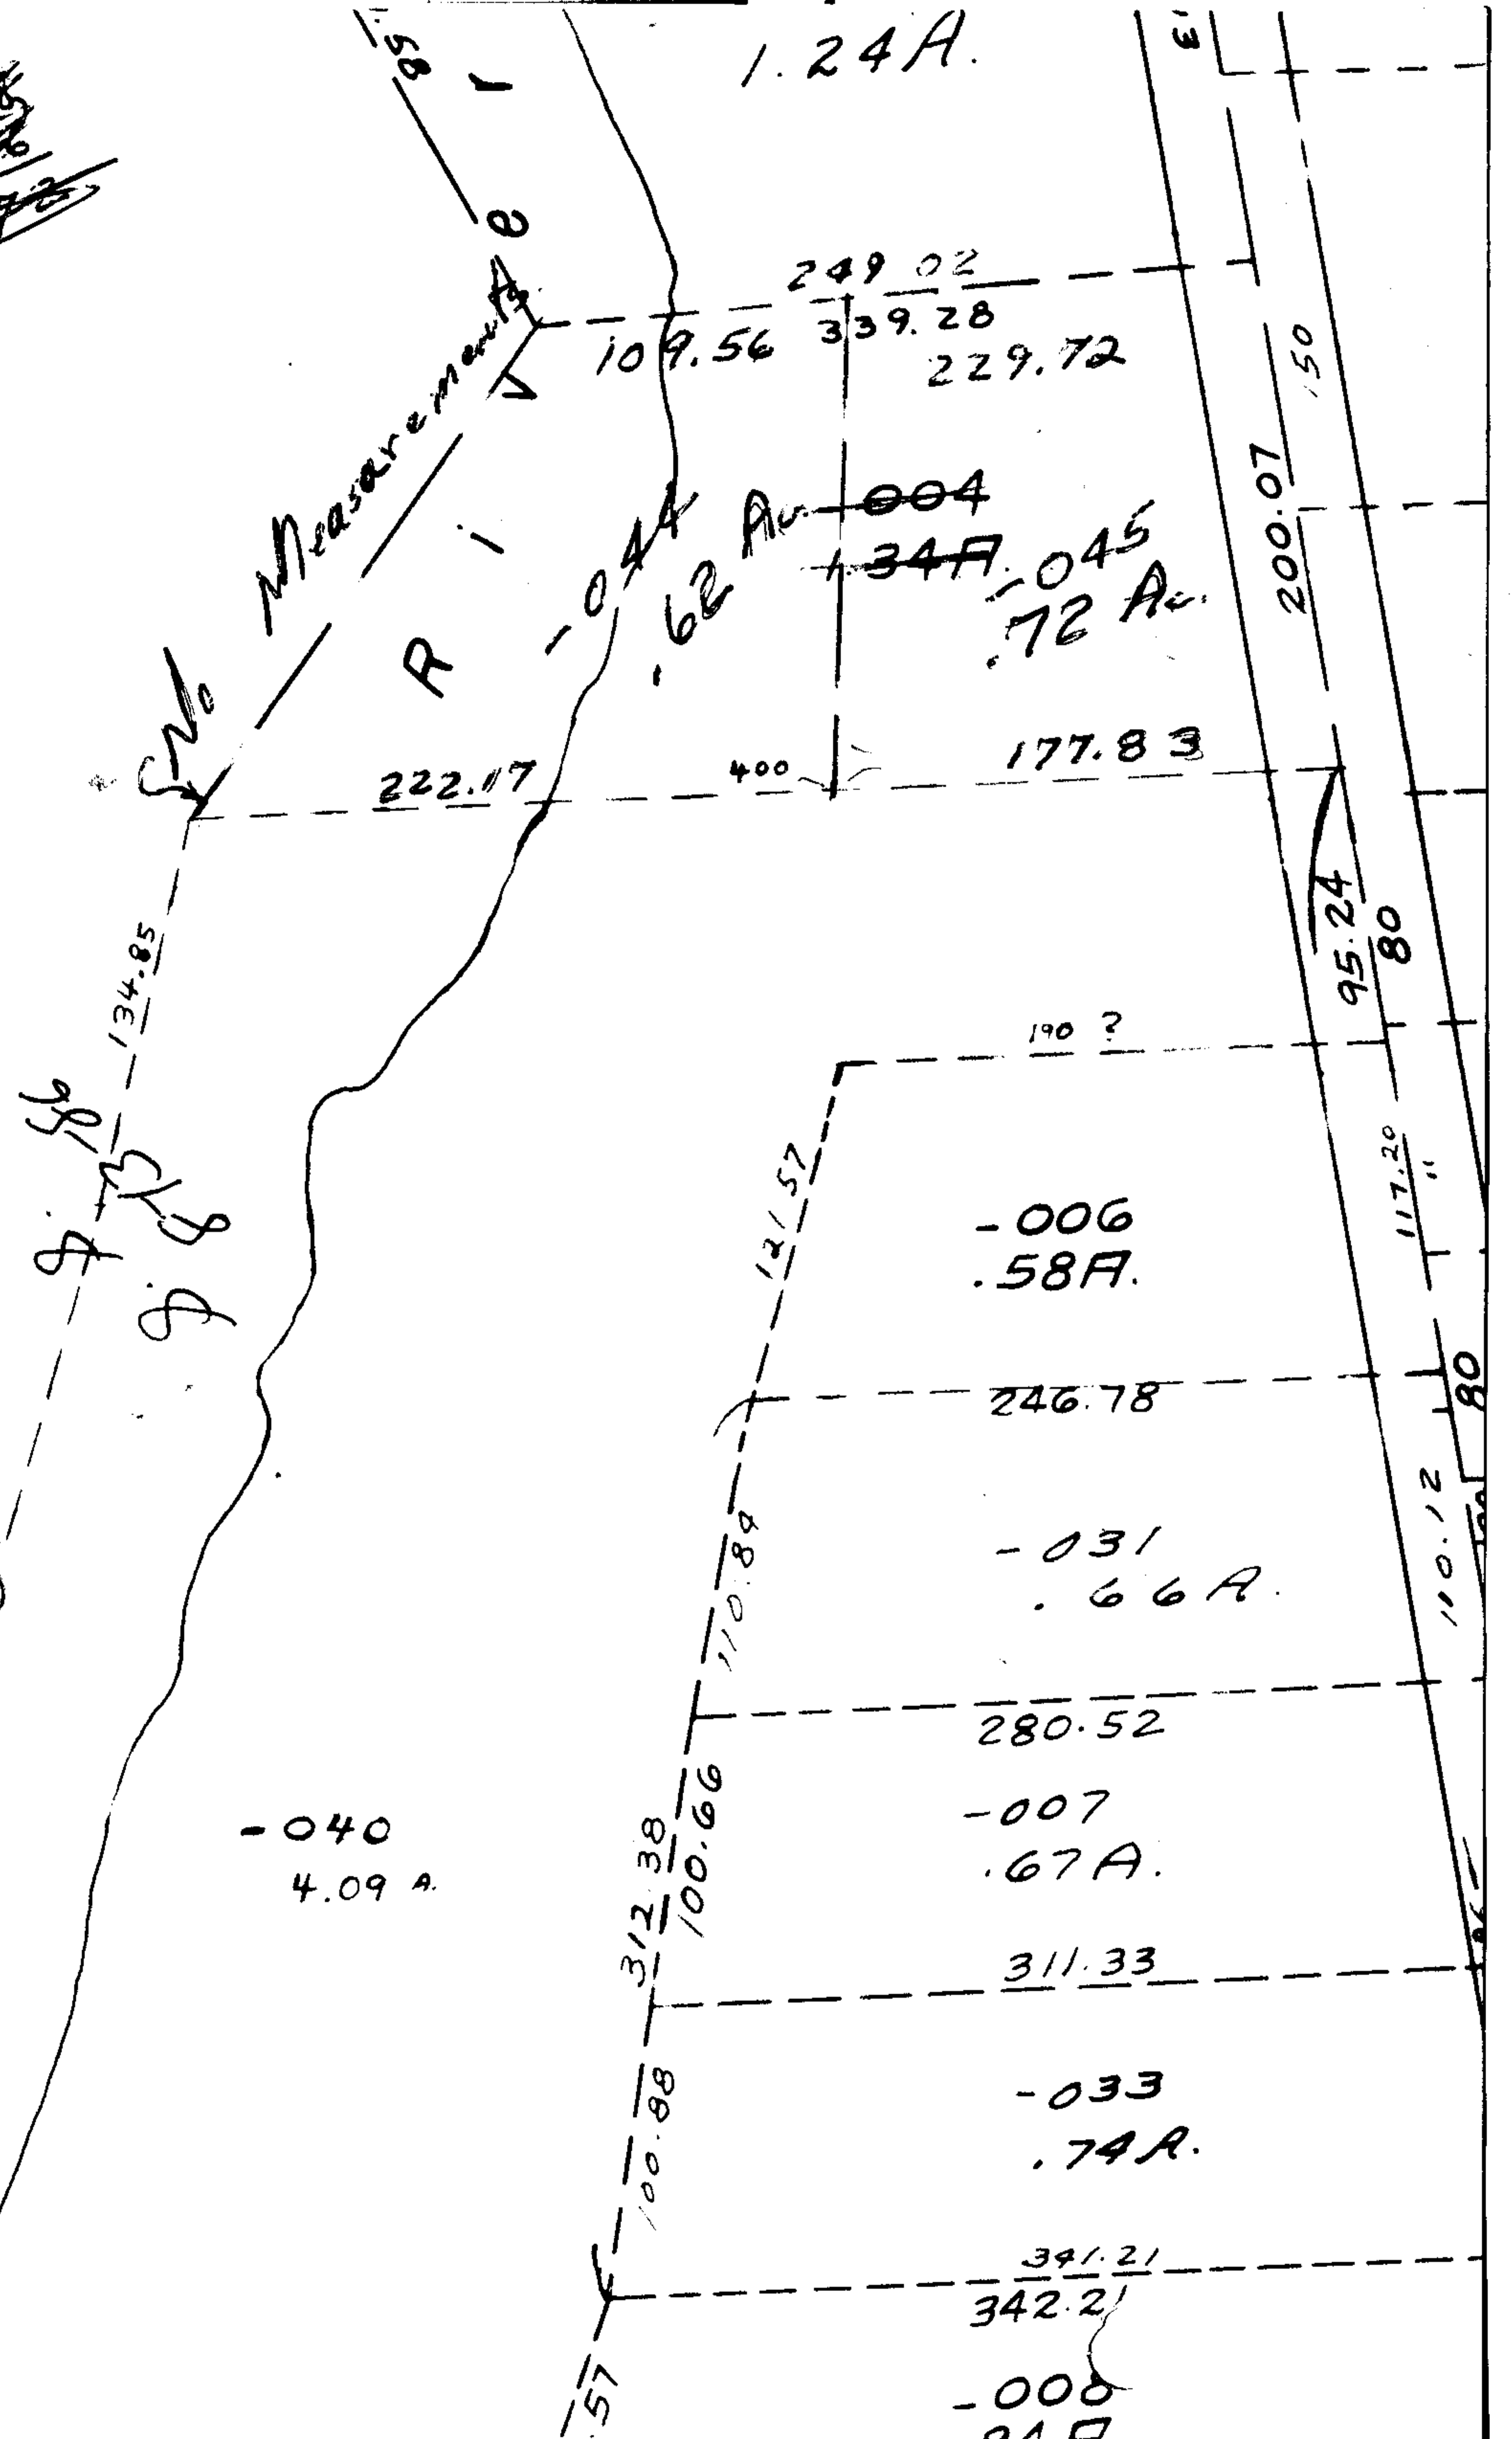

1.24 A.

249 02

109.56

339.28

229.72

222.07

400

177.83

190 ?

-006
.58A.

246.78

-031
.66A.

280.52

-007
.67A.

311.33

-033
.79A.

341.21
342.21

-008
.21A.

200.07

95.24

80

117.20

80

110.12

80

80

