


Pg 9.C

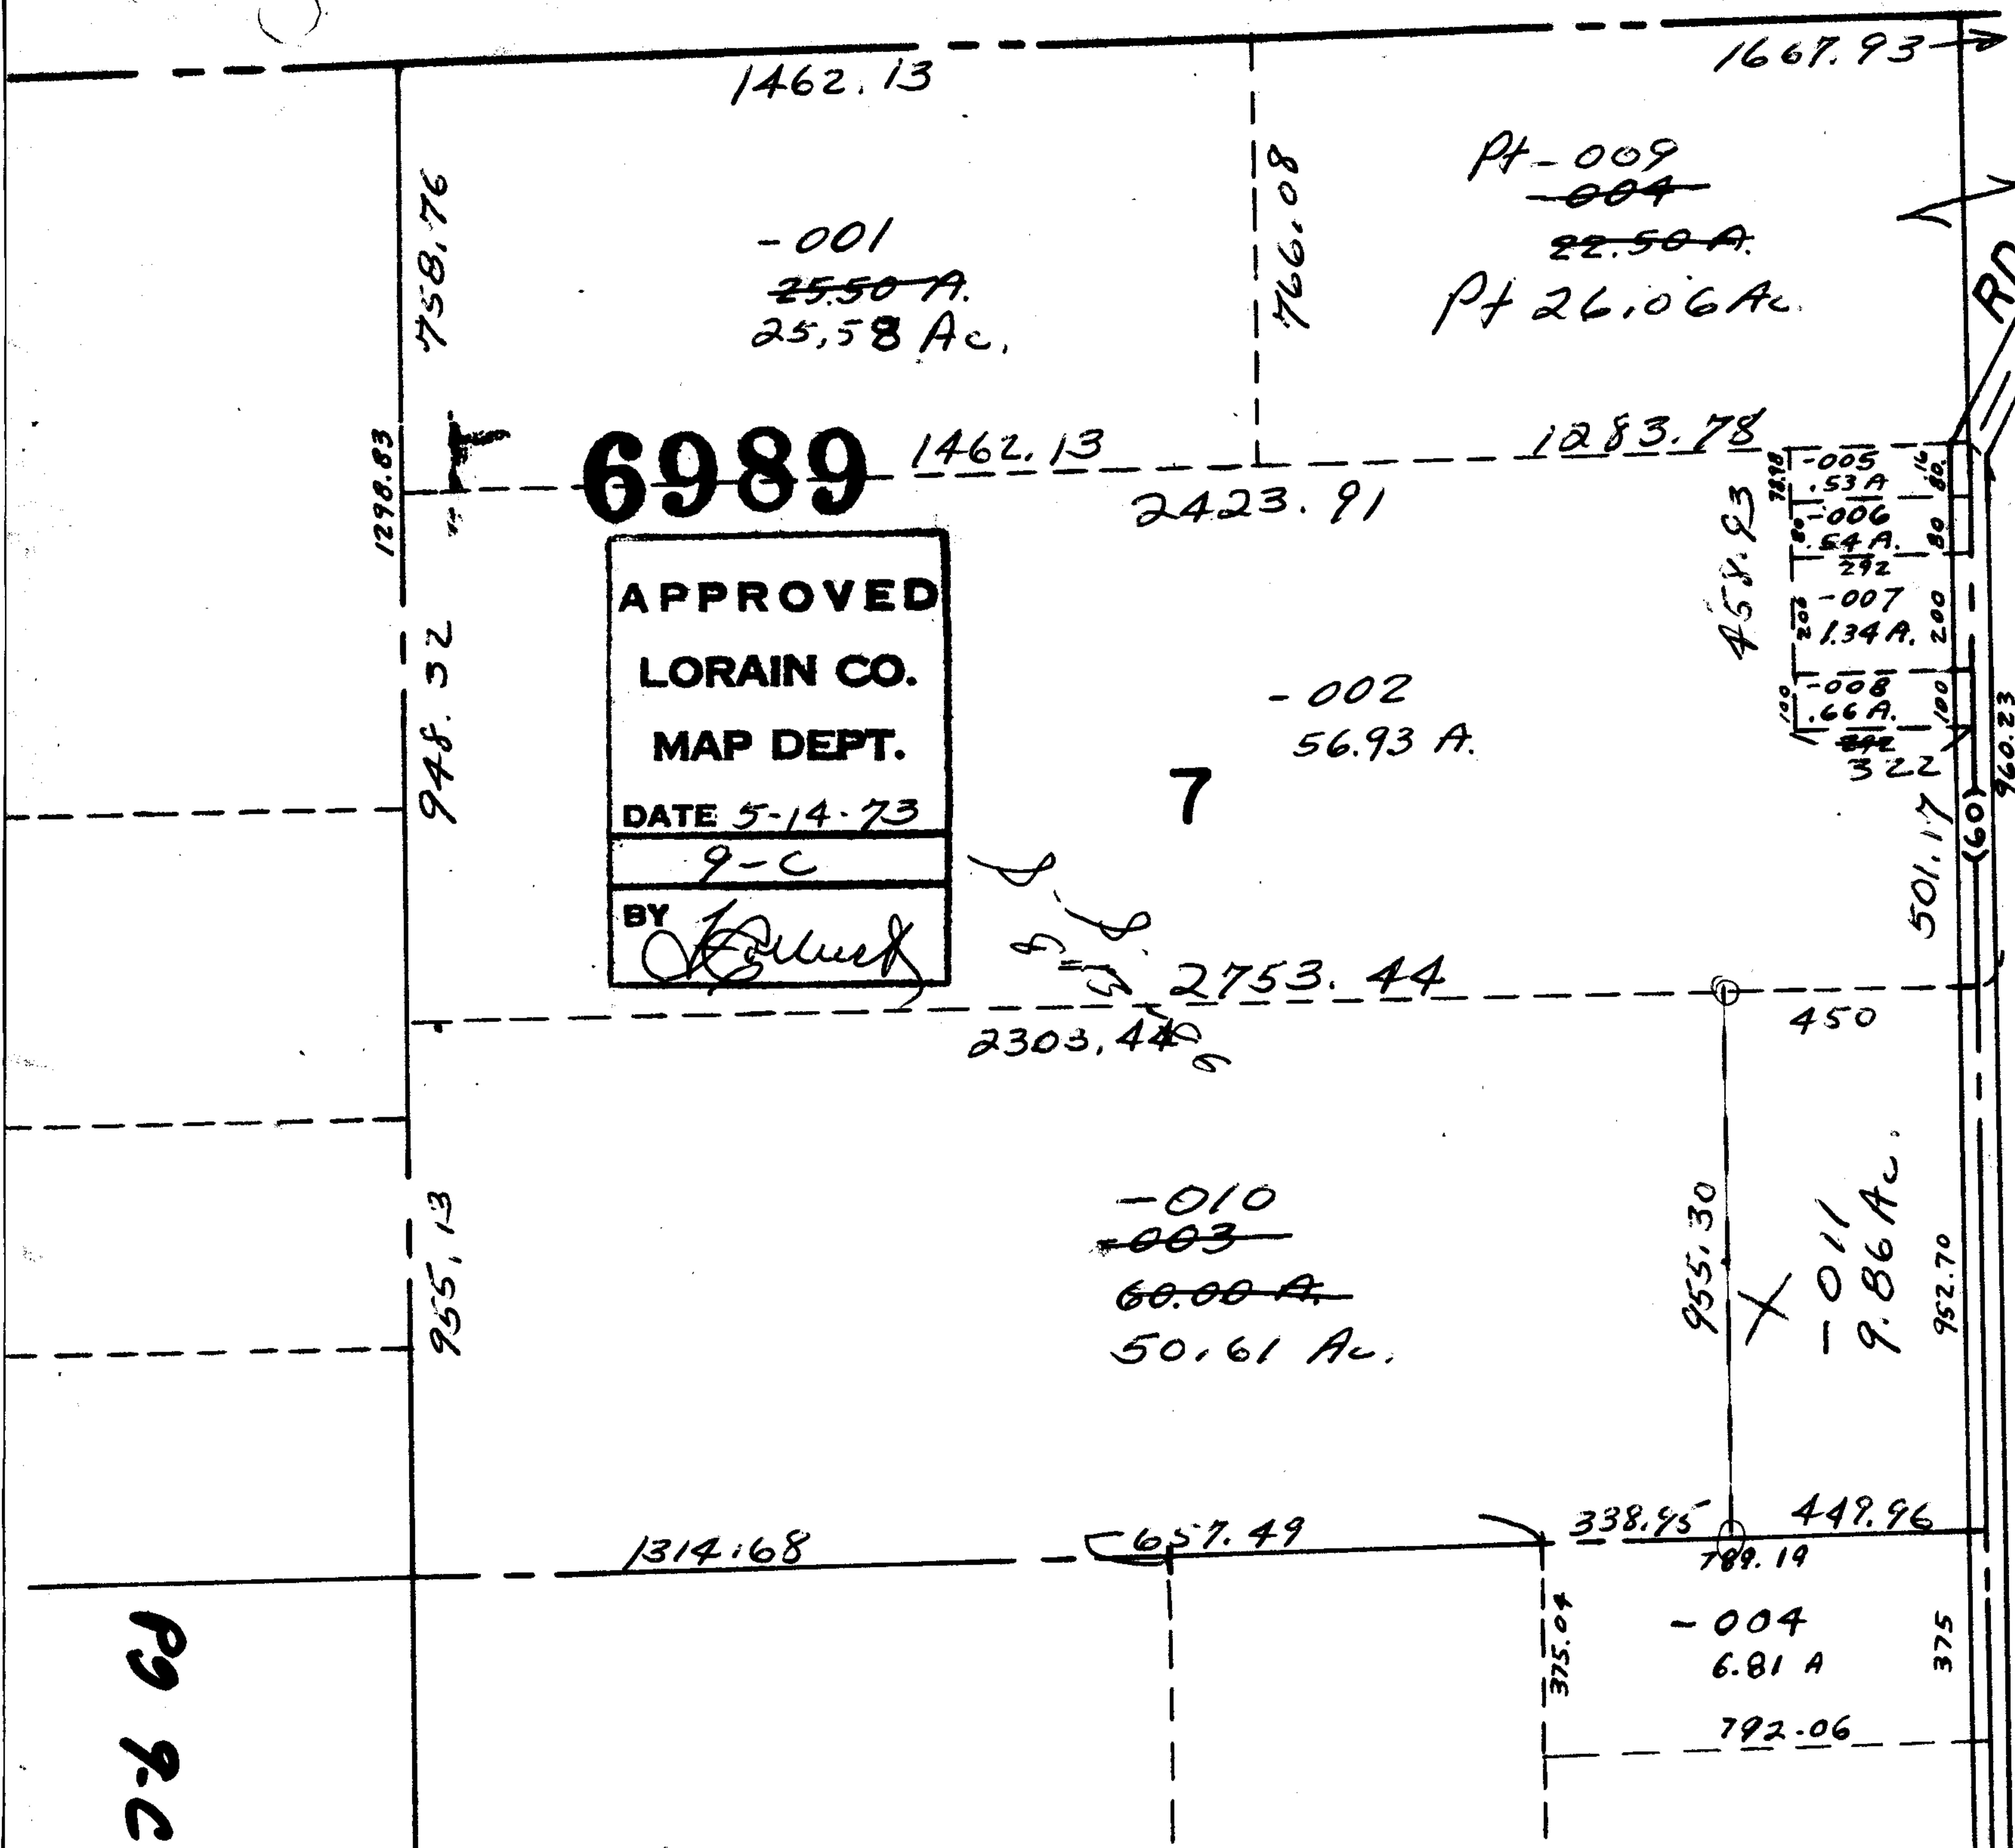

6989

APPROVED
LORAIN CO.
MAP DEPT.
DATE 5-14-73
9-C
BY *[Signature]*

Del Summary

Pres

2/2

6869