


6995

6995

*225*

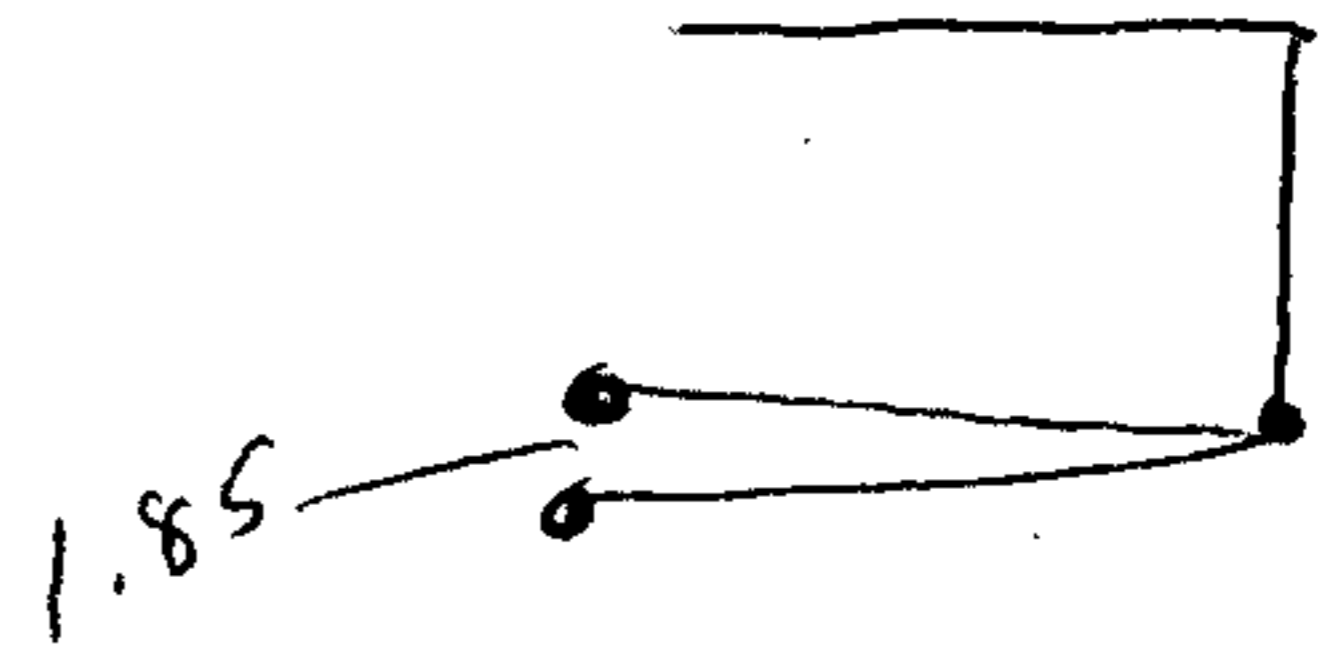

~~-006~~  
~~-001~~  
154.00 A.  
153.00 A.

24

6995

APPROVED  
LORAIN CO.  
MAP DEPT.

DATE 5-17-23

15-B

BY *[Signature]*

*7-30-86 L.L.*

*C-M-OK*

BIGGS

(60)

242.04  
360  
-003  
2.00 A.  
360  
-004  
1.00 A.  
180  
242.04

150  
400  
-008  
1.38 A.  
150  
400  
-006  
1.38 A.  
300  
400  
-004  
2.75 A.  
300

1188

$\frac{696.08}{208.72}$   
904.80

-009  
71.09 A.

-002  
40.00 A.

27

15-B

$\frac{906.65}{904.80}$   
1.85  
208.72  
210.57

$\frac{906.65}{904.80}$   
1.85

790  
91

906.65

208.72  
208.72  
-002  
1.00 A.  
208.72  
208.72  
208.72  
208.72

696.08