


6999

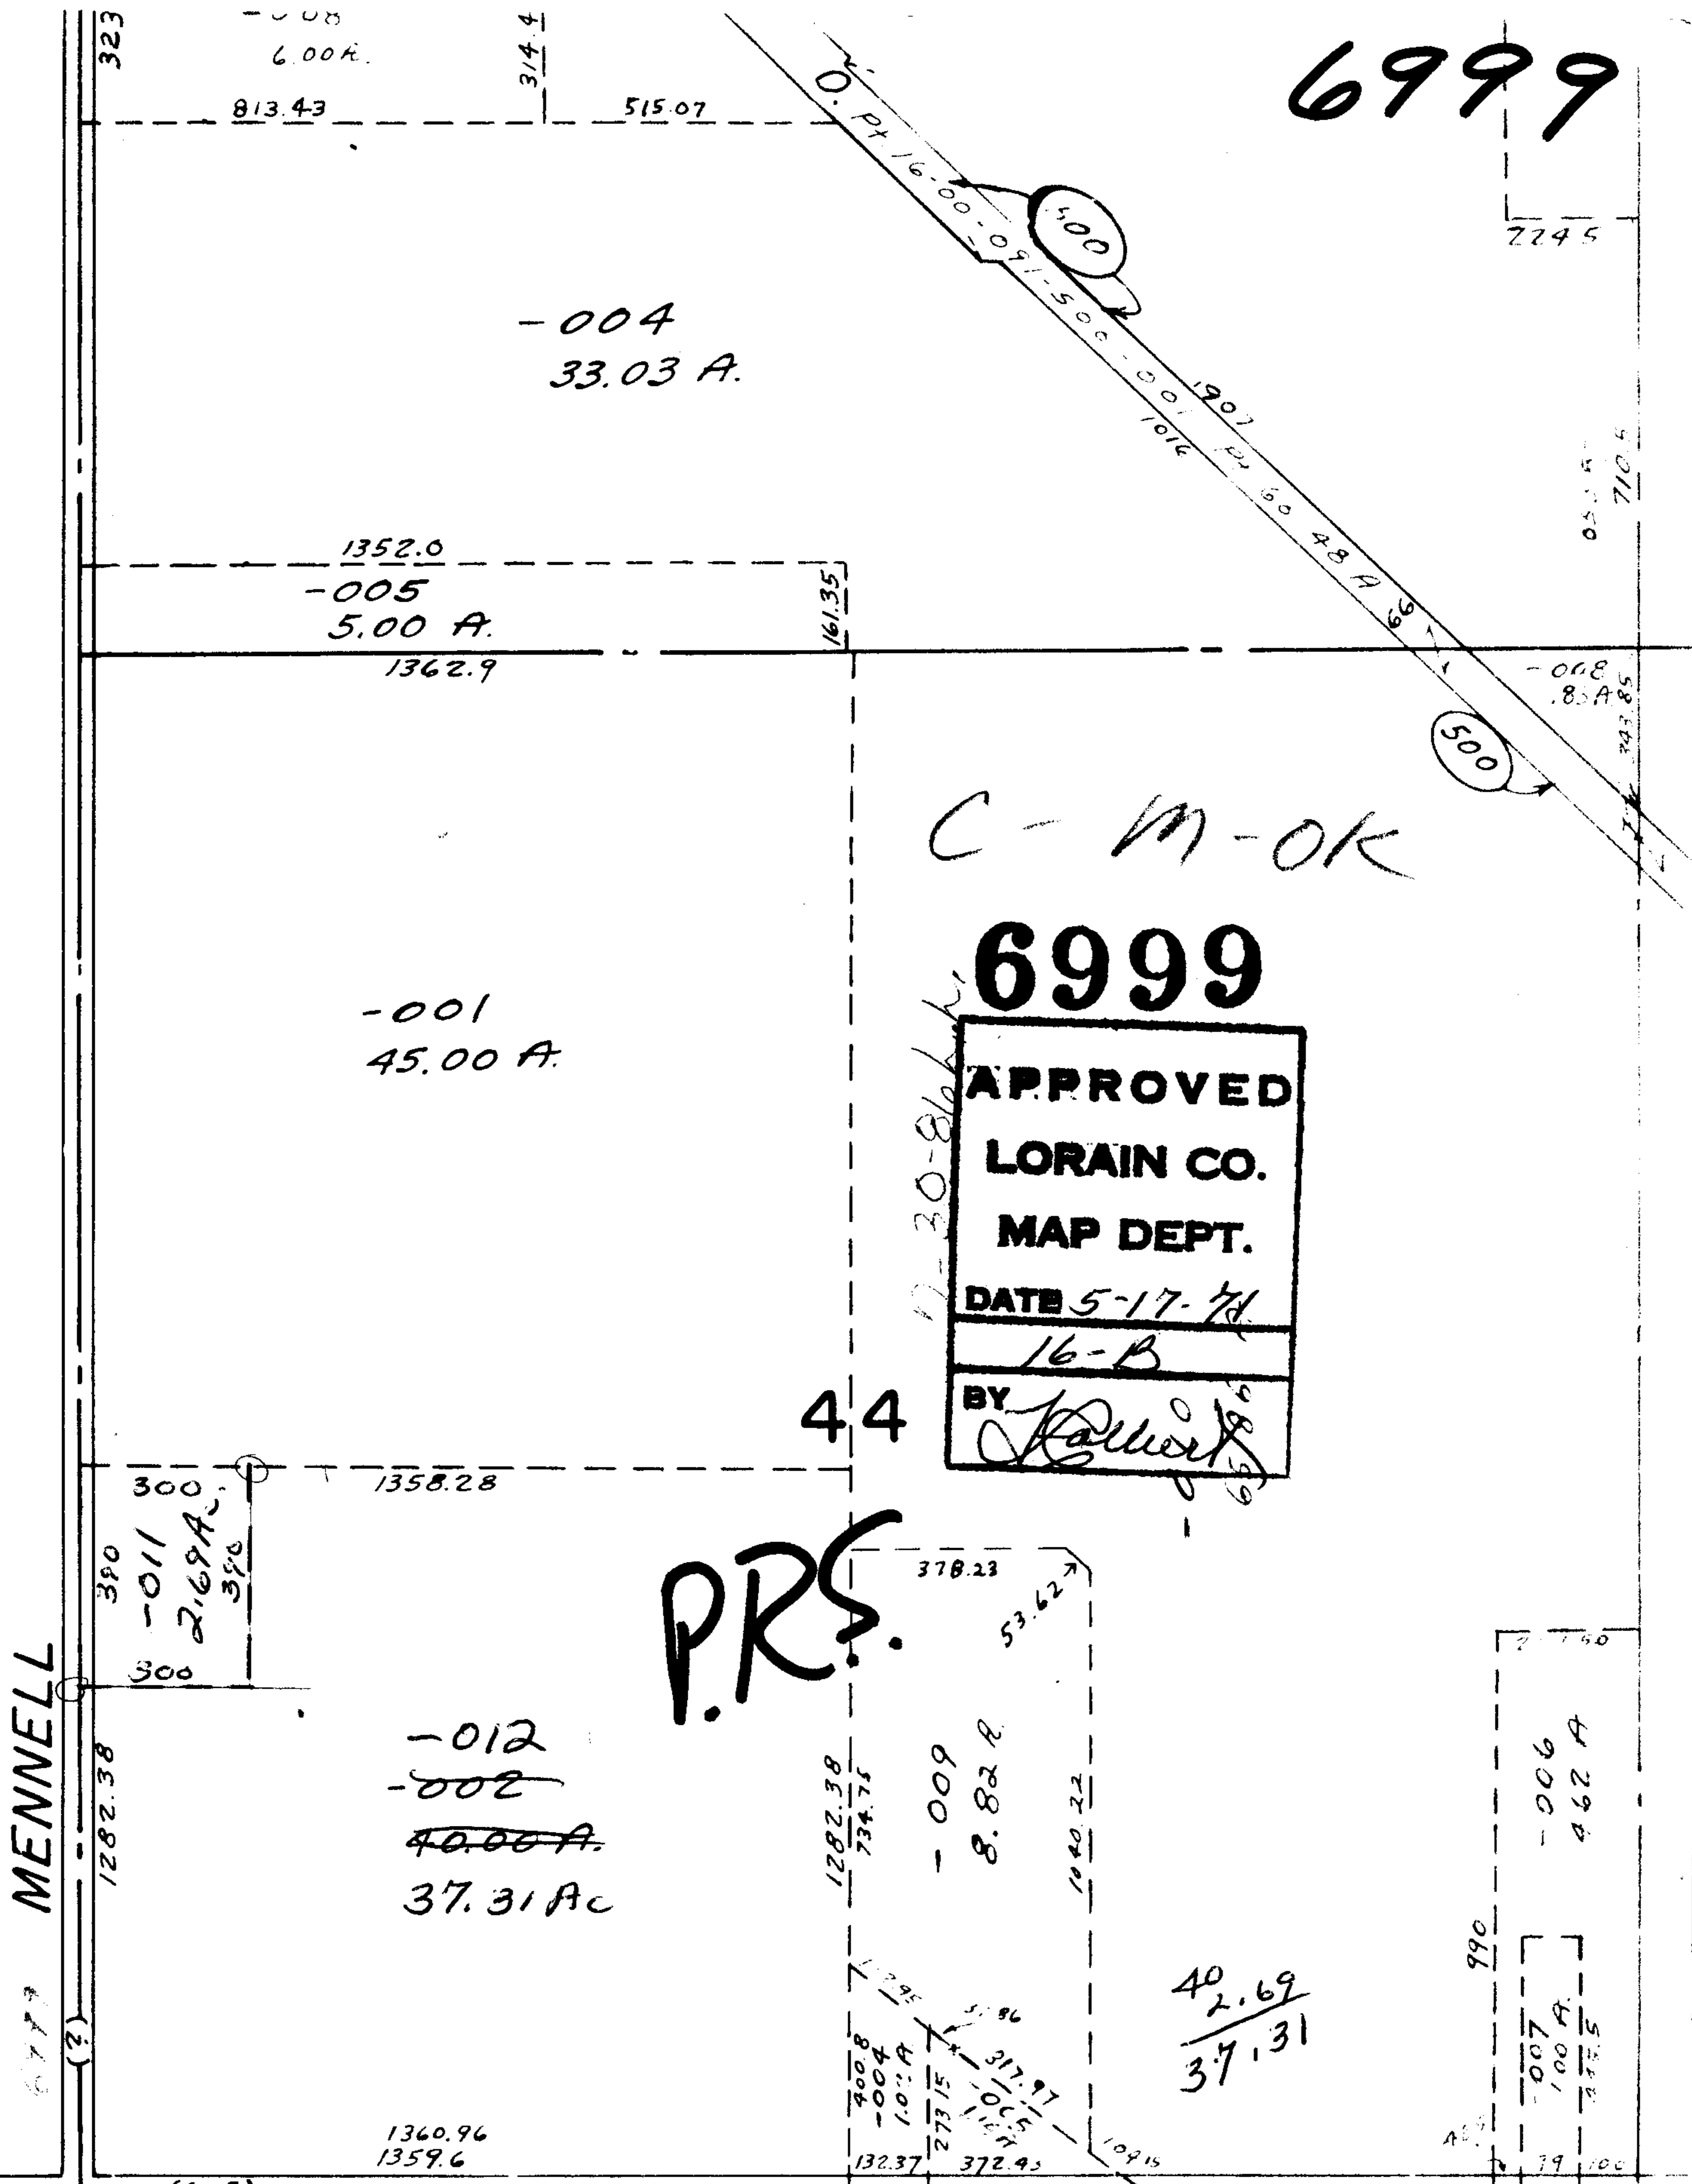

-004
33.03 A.

-005
5.00 A.

-001
45.00 A.

-012
~~40.00 A.~~
37.31 A.

C-M-OK

6999

APPROVED
 LORAIN CO.
 MAP DEPT.
 DATE 5-17-74
 16-B
 BY *[Signature]*

17-30-81

44

P.R.S.

40
2.69
37.31

MENNELL

303

WAKEMAN - LAGRANGE - RICHFIELD

GRAFTON TWP.

SCALE: 1" = 400'

LOTS