


SEE SURVEY # 7000

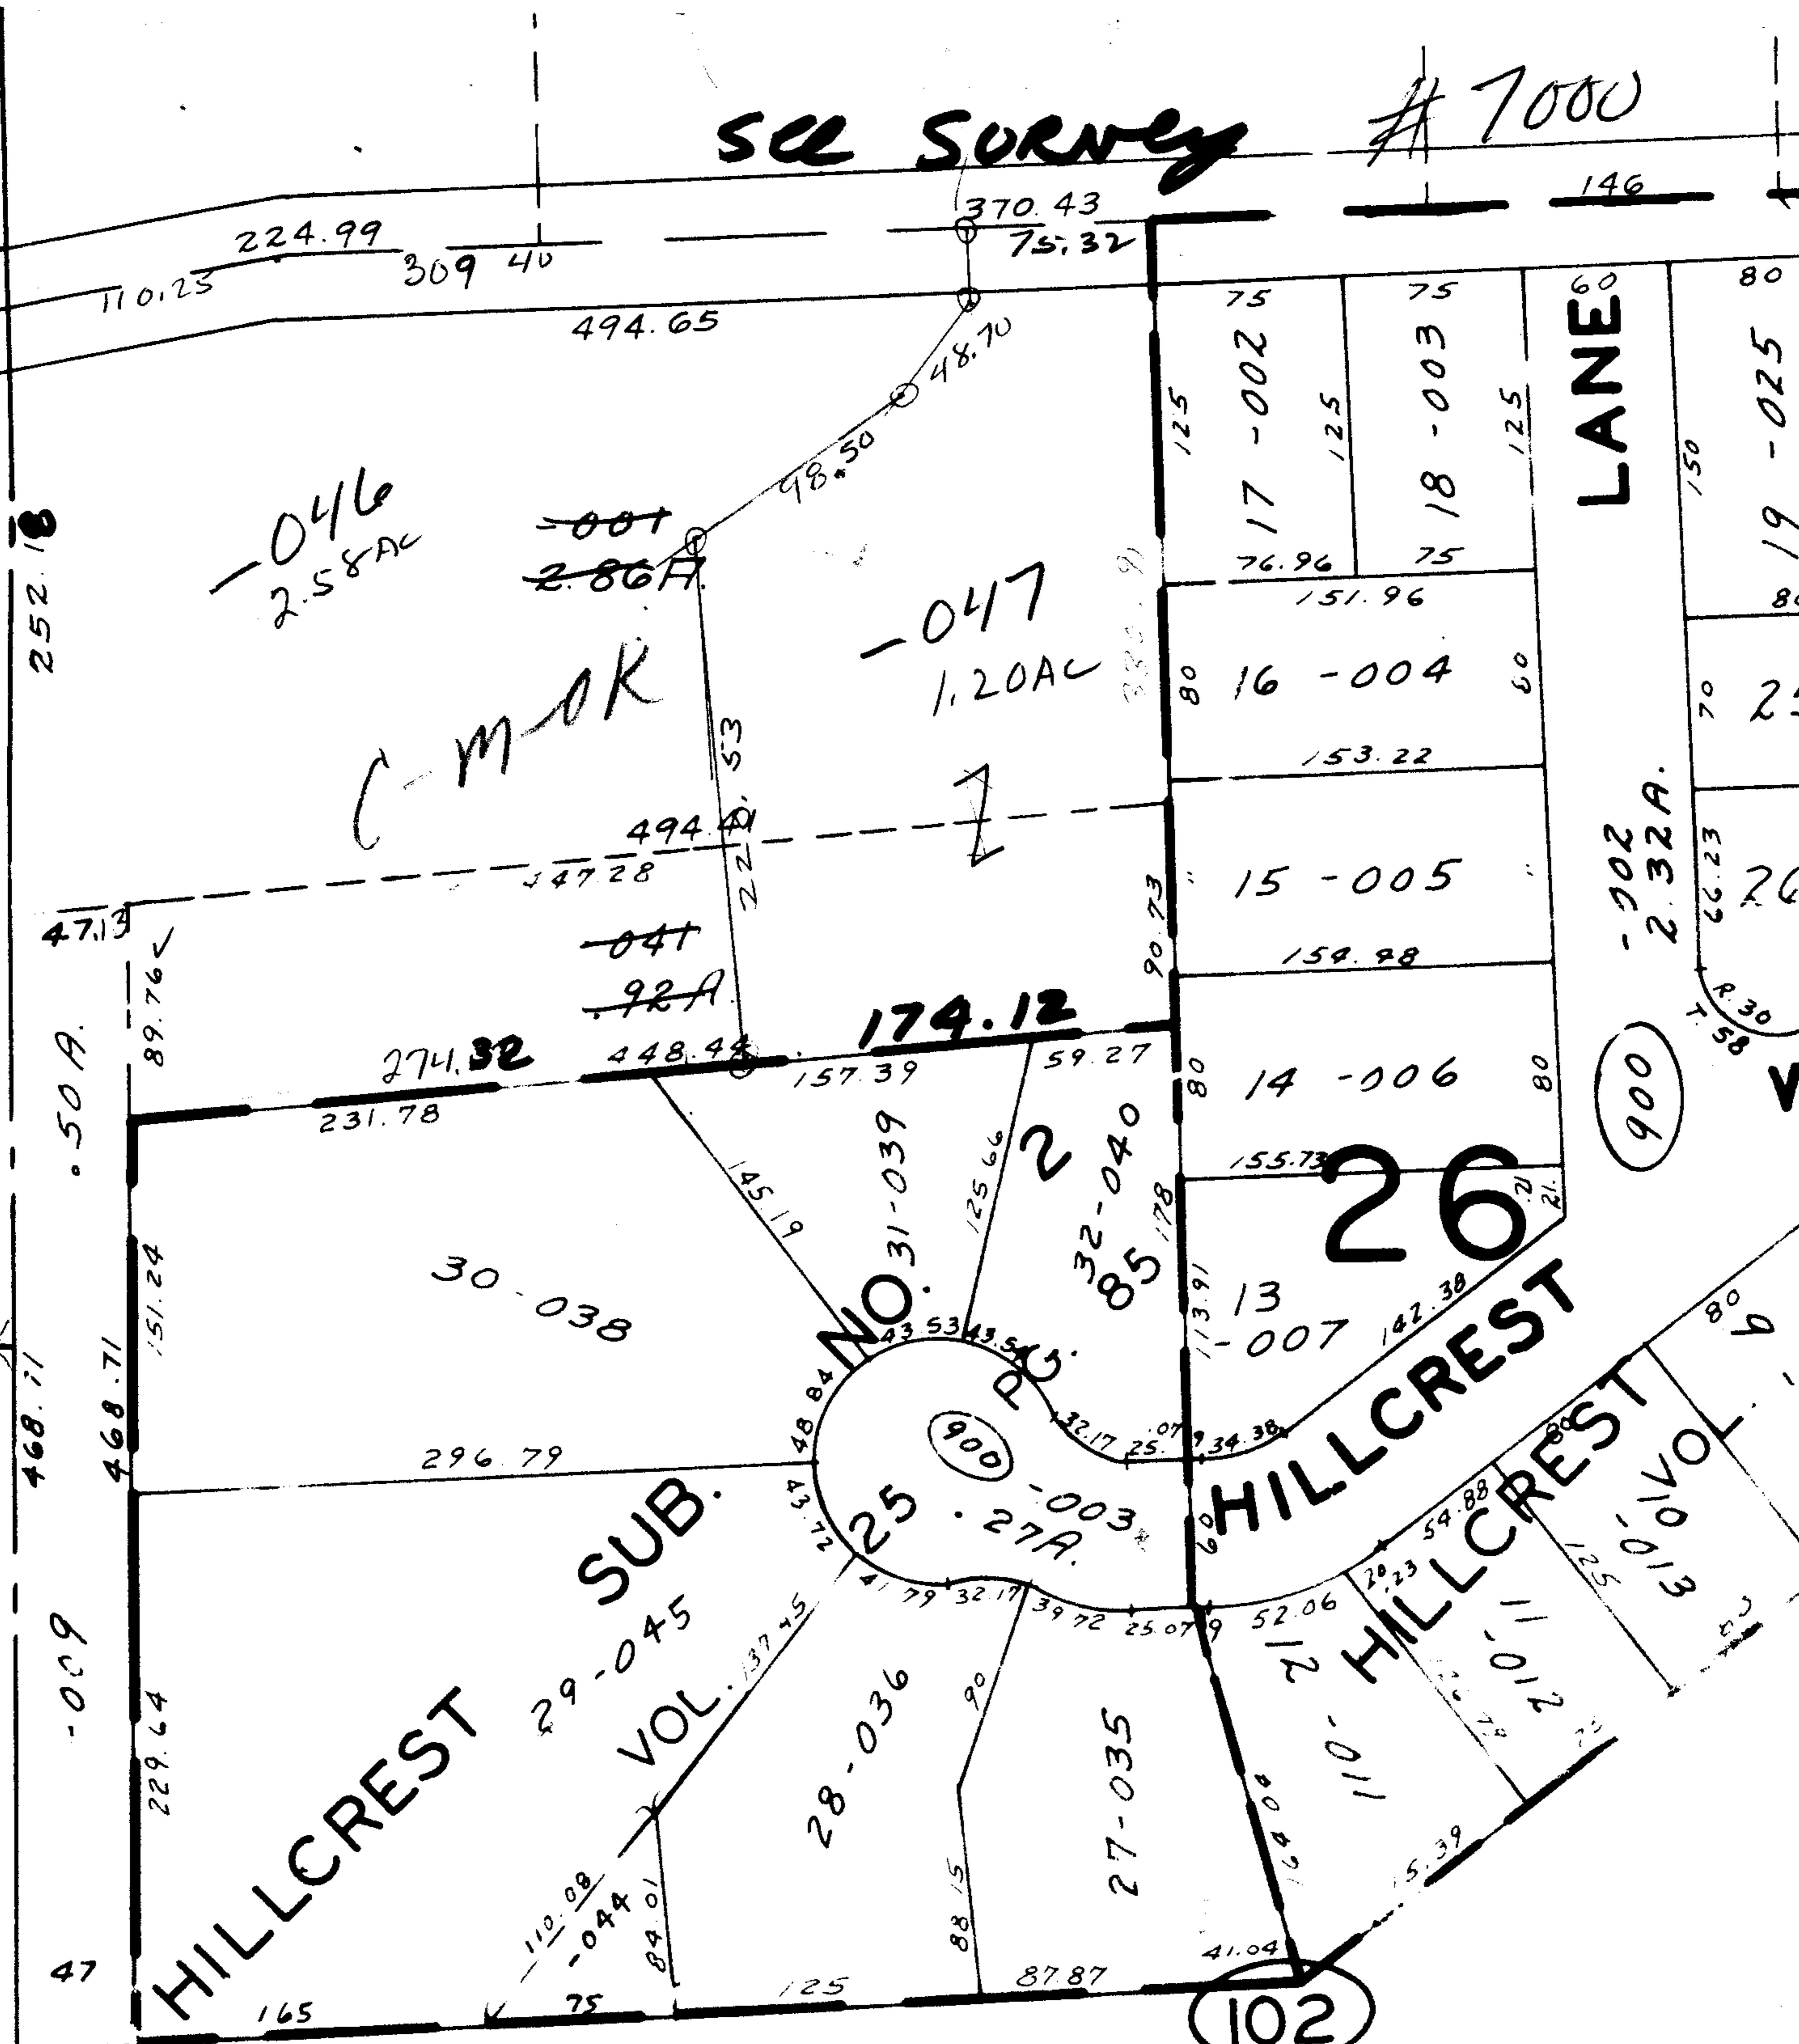

7000

APPROVED
LORAIN CO.
MAP DEPT.
DATE 5-21-73
6-38
BY LWHall

P.R.S.

-034  
17.96A

FOR.