


7004
+ 7003

212

(Handwritten scribbles)

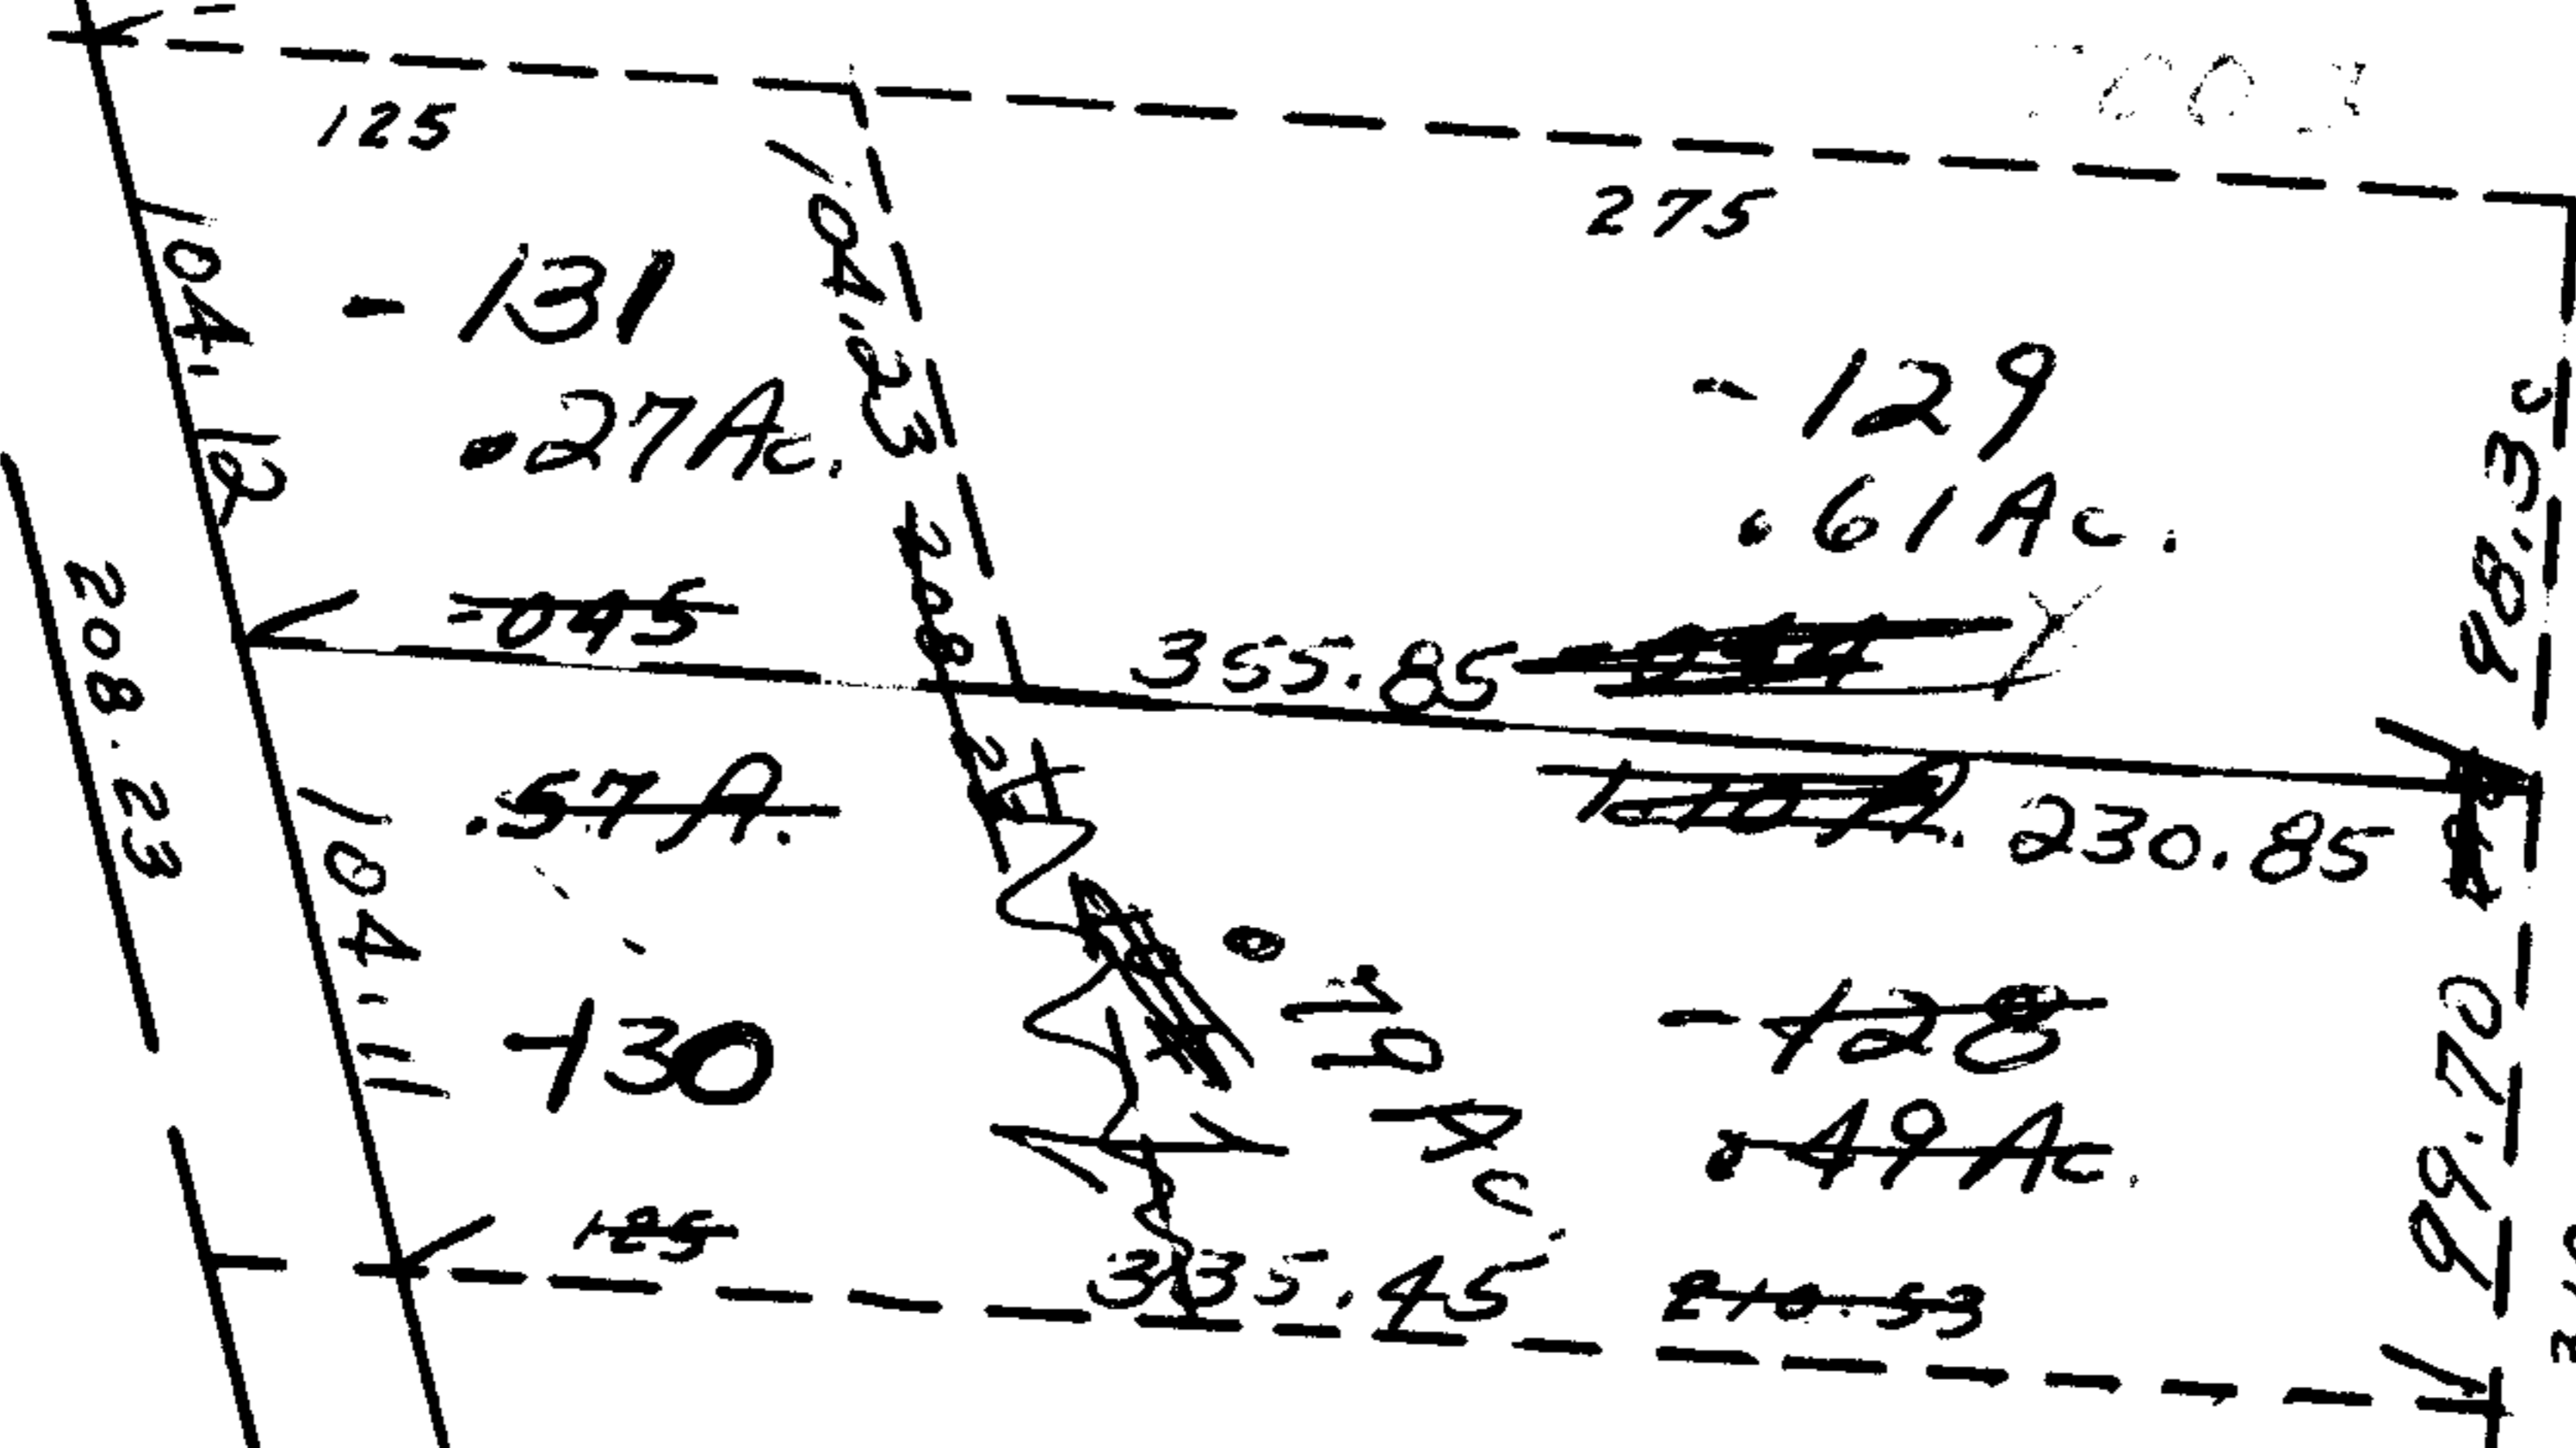


79
49
30

7003

APPROVED
LORAIN CO.
MAP DEPT.
DATE 5-24-73
11-00-099-B
BY *(Signature)*

7004

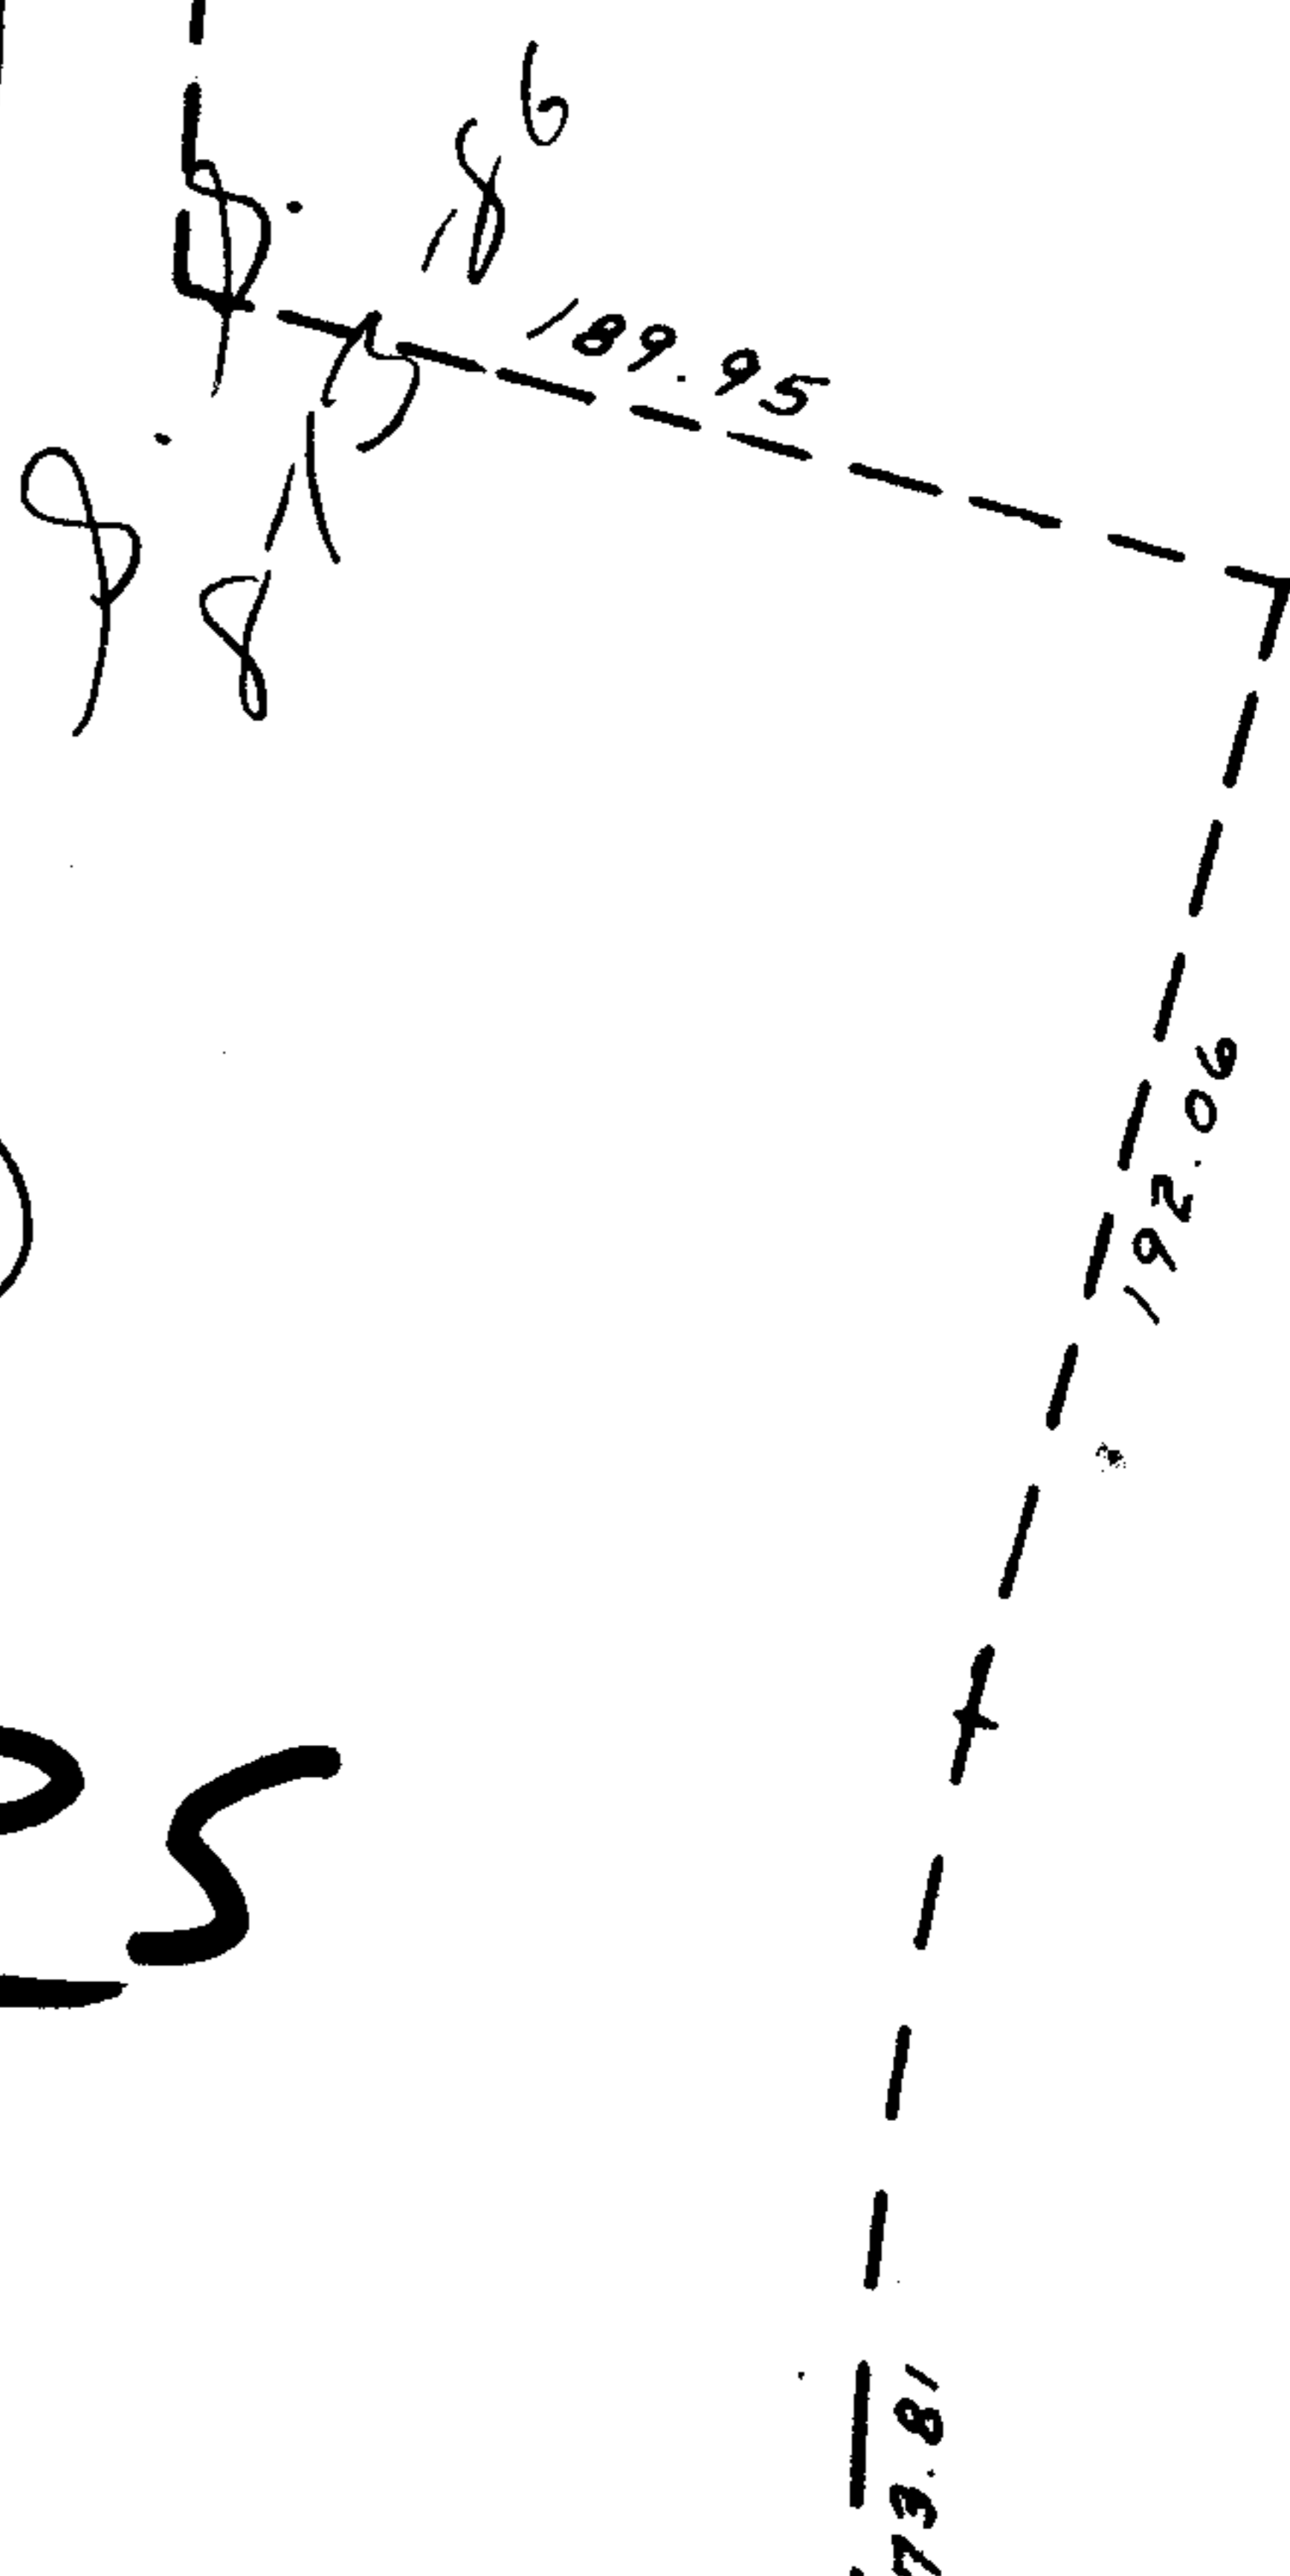

PRS

SEE 11-E
NO-M

