


7018

1/2

C.M.H. OK

P.R.S.

SEE SURVEY

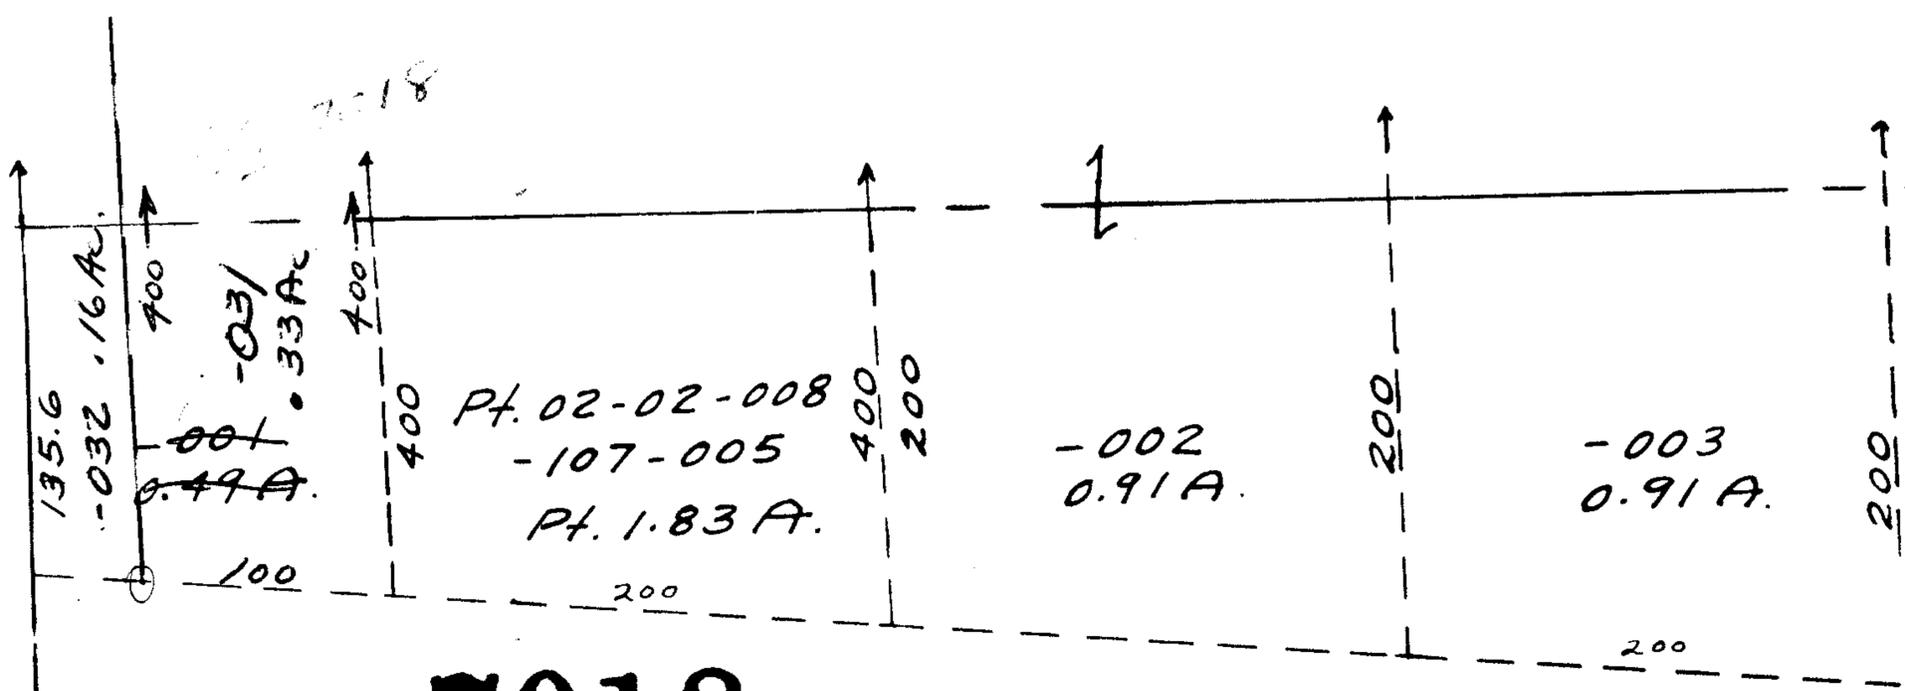

7018

APPROVED
 LORAIN CO.
 MAP DEPT.
 DATE 5-22-73
 2-02-003
 BY *[Signature]*

J.S.
8-13-86


-030
7.75 A.

631.3

92° 27'

554.4

886.4

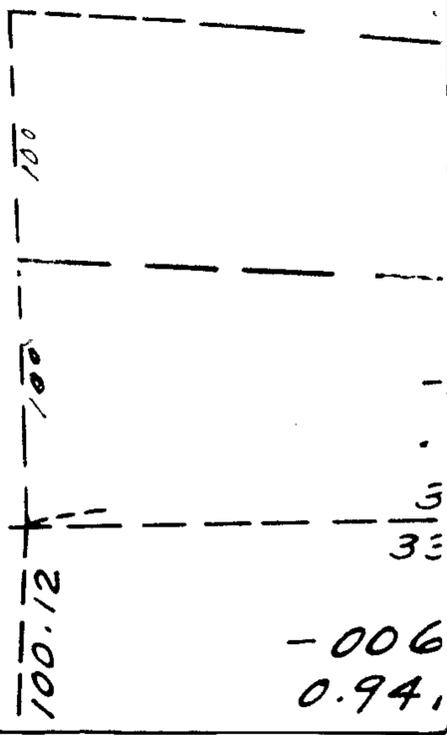

2-02-003