


7021

107

-021  
4.50 A.

C-M-OK  
891.05  
60

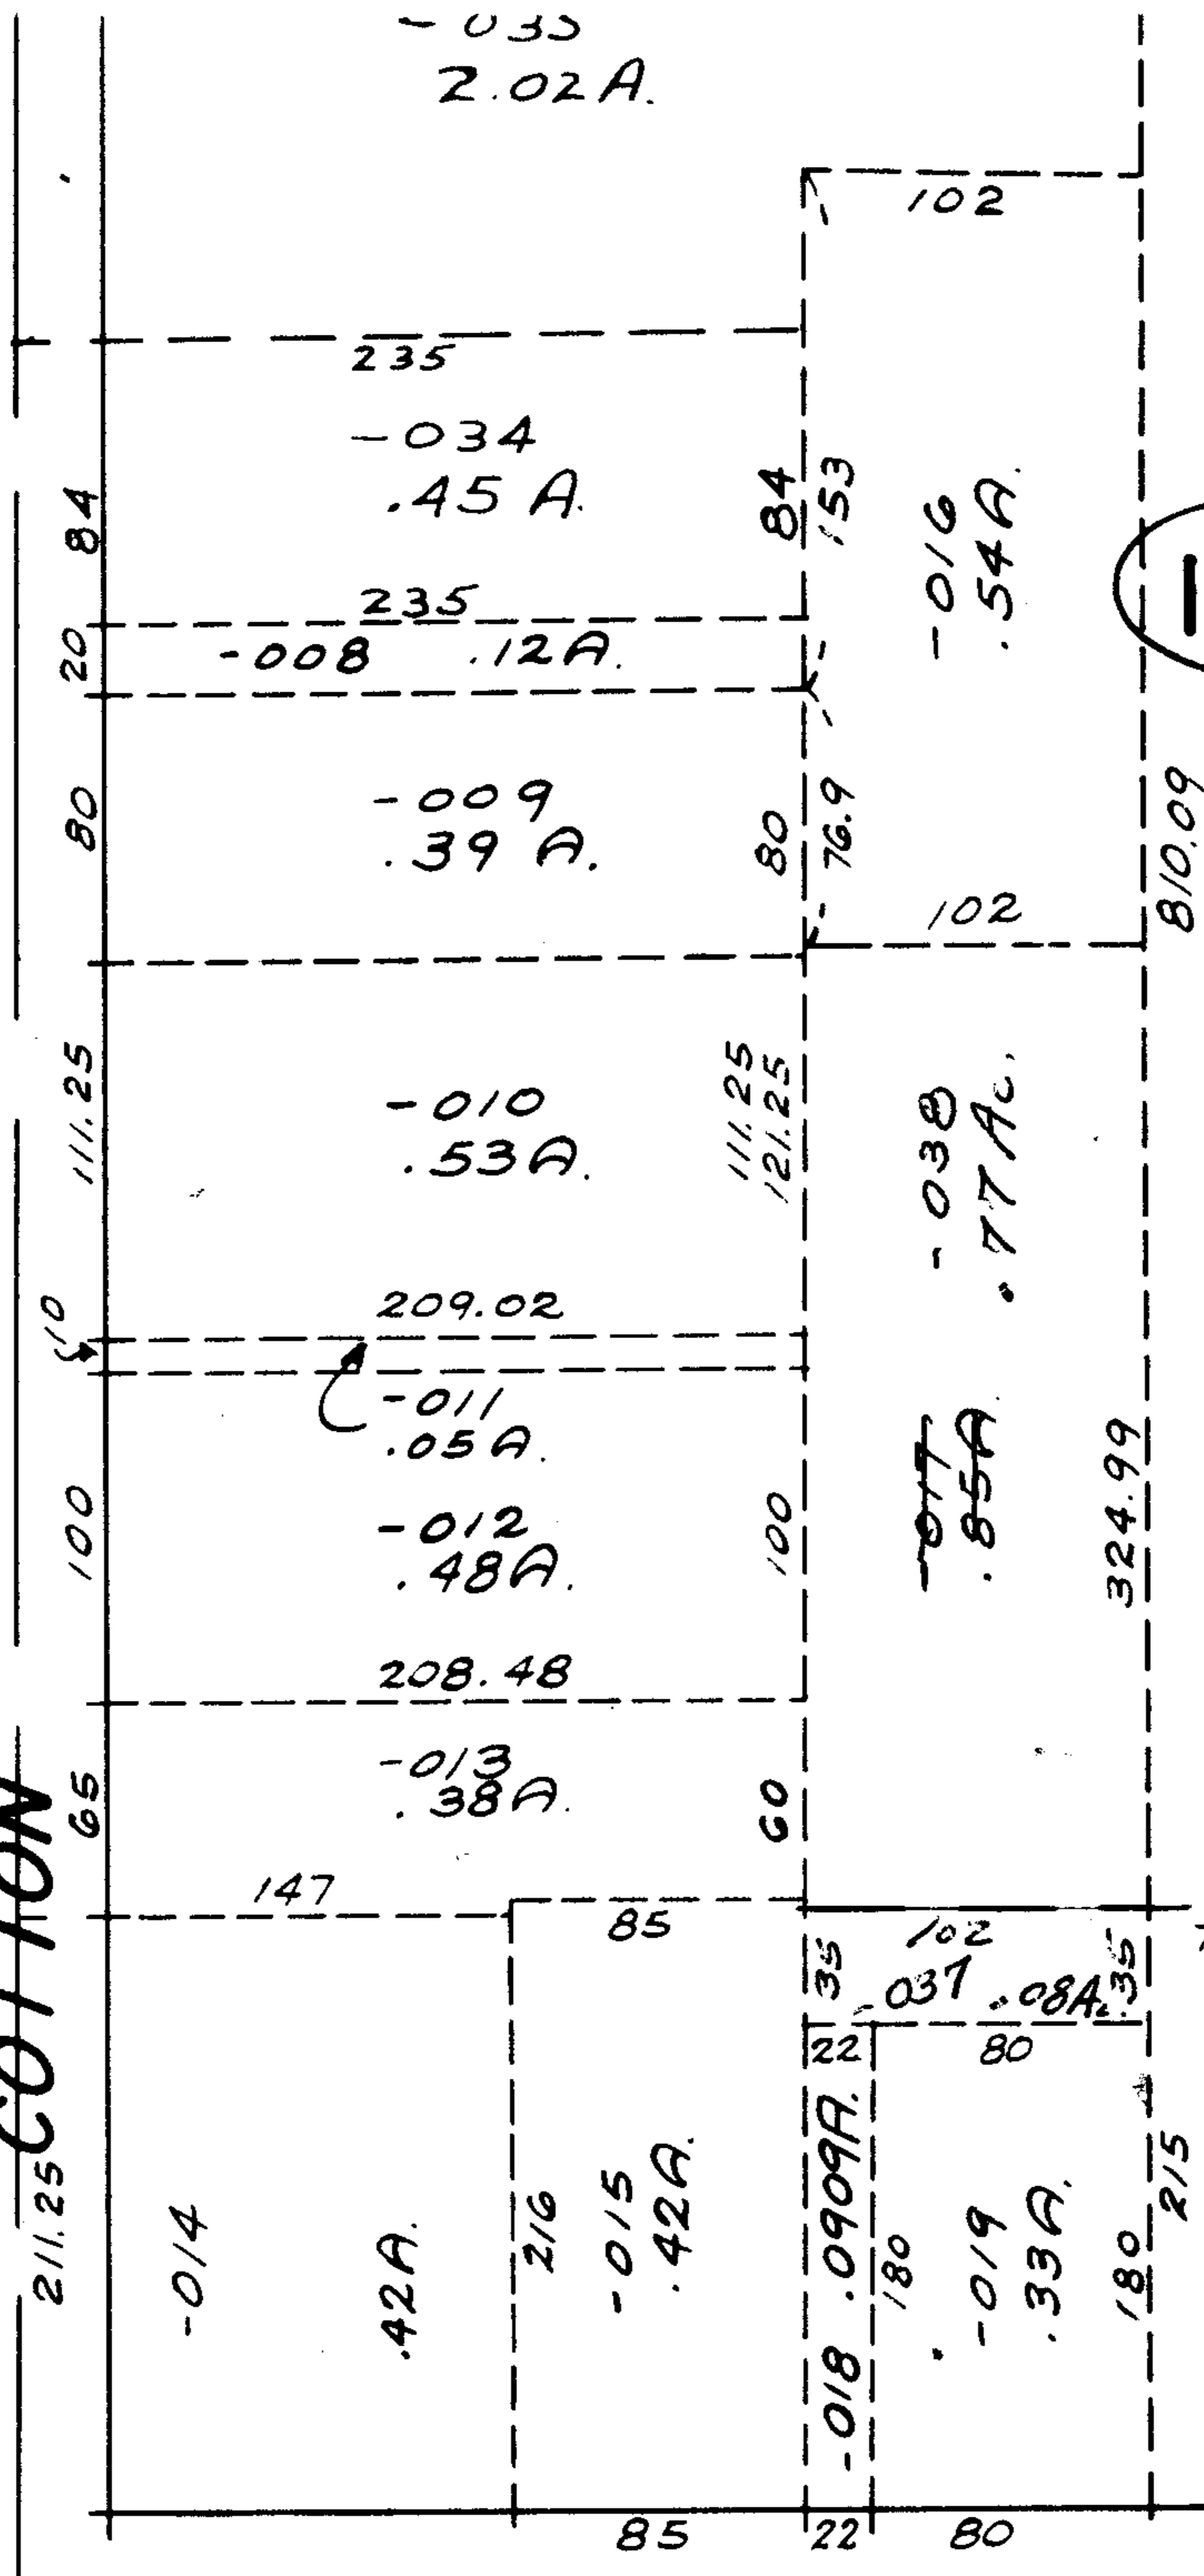

COTTON

NORTH RIDGE

254

SEE 6-2

7021

APPROVED  
 LORAIN CO.  
 MAR. DEPT.  
 DATE 5-25-73  
 3-00-113-B  
 BY *Lalor*

P.R.S.  
S.D. 8-13-86

21  
 21  
 21  
 21  
 35  
 289.99

SHEFFIELD TWP.

SCALE: 1" = 100'