


7031
42

PRS

SEE
SURVEY

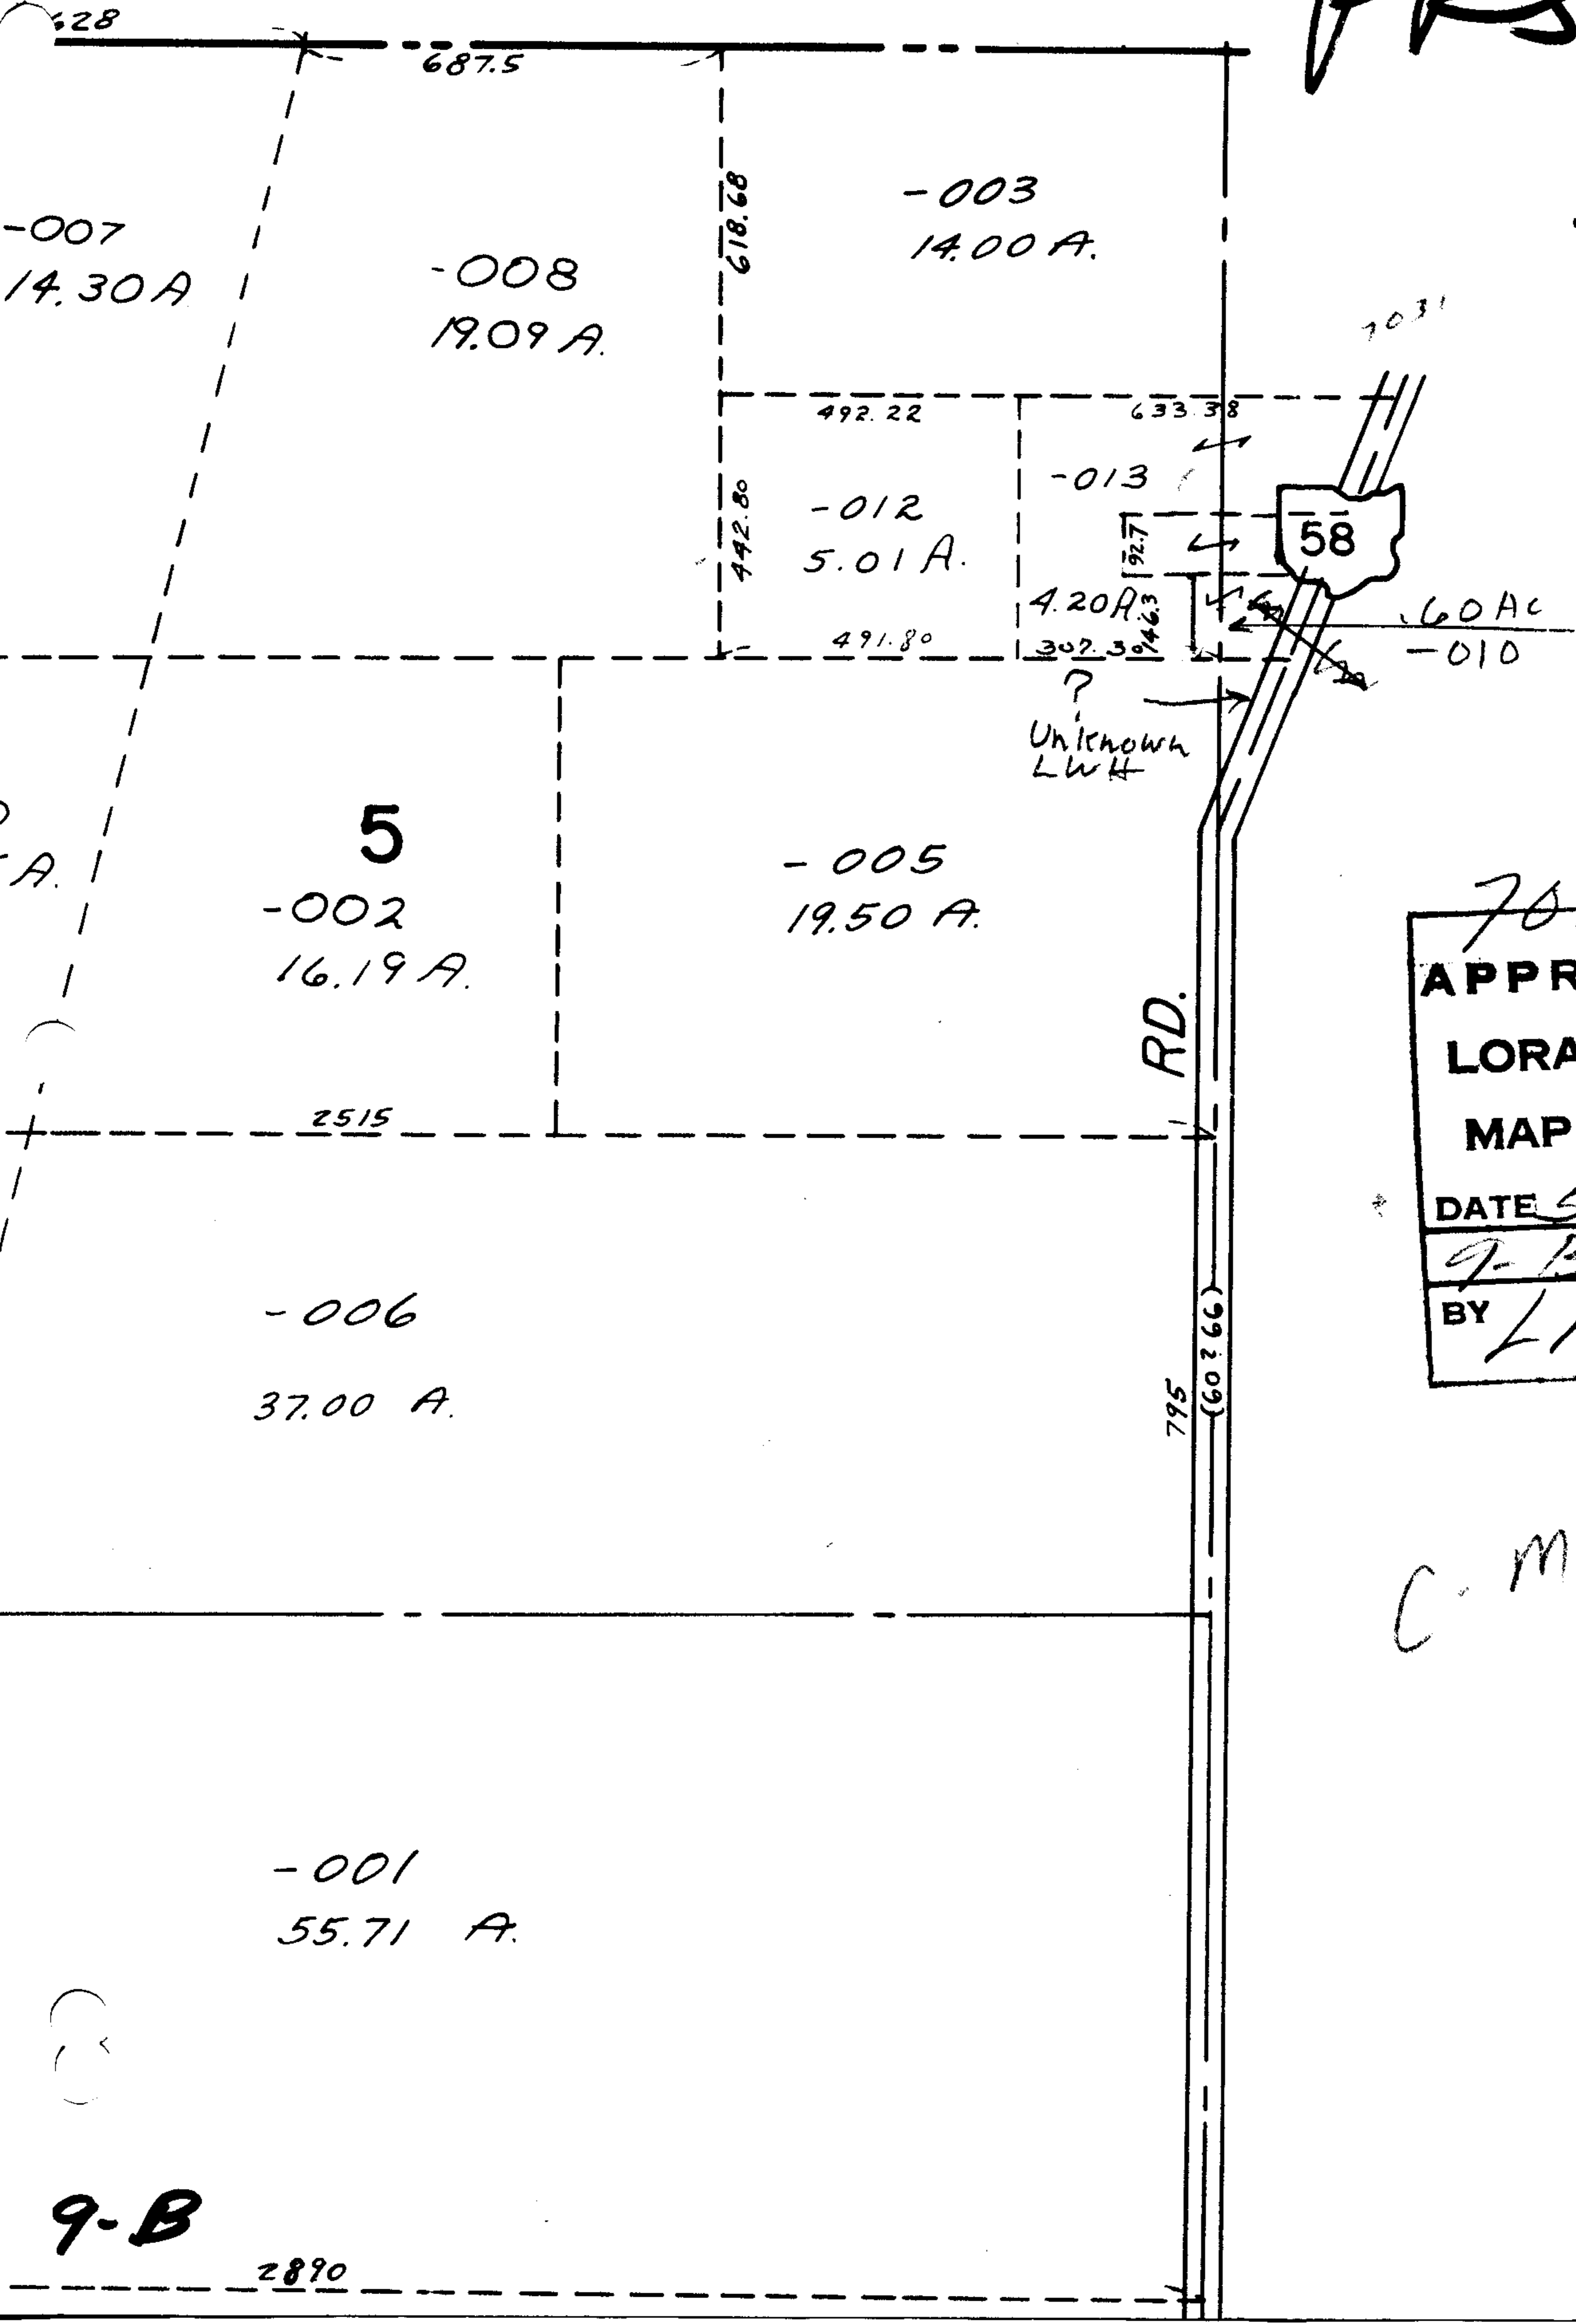

7031
APPROVED
LORAIN CO.
MAP DEPT.
 DATE 5-24-73
 9-B + 9-C
 BY LWH

C.M. OK

9-B

2890