

SEE 5-00-062-A

1108.10

959.13

910

7037

PR

063  
~~061~~  
~~7.99A.~~  
7.28

C M OF


7037  
APPROVED  
LORAIN CO.  
MAP DEPT.  
DATE 5-30-73  
5-00-063A  
BY L.W. Hall

2081.25

766.92

7-20 86 Y.L.

S. 87° 40' E. N. 89° 35' E.

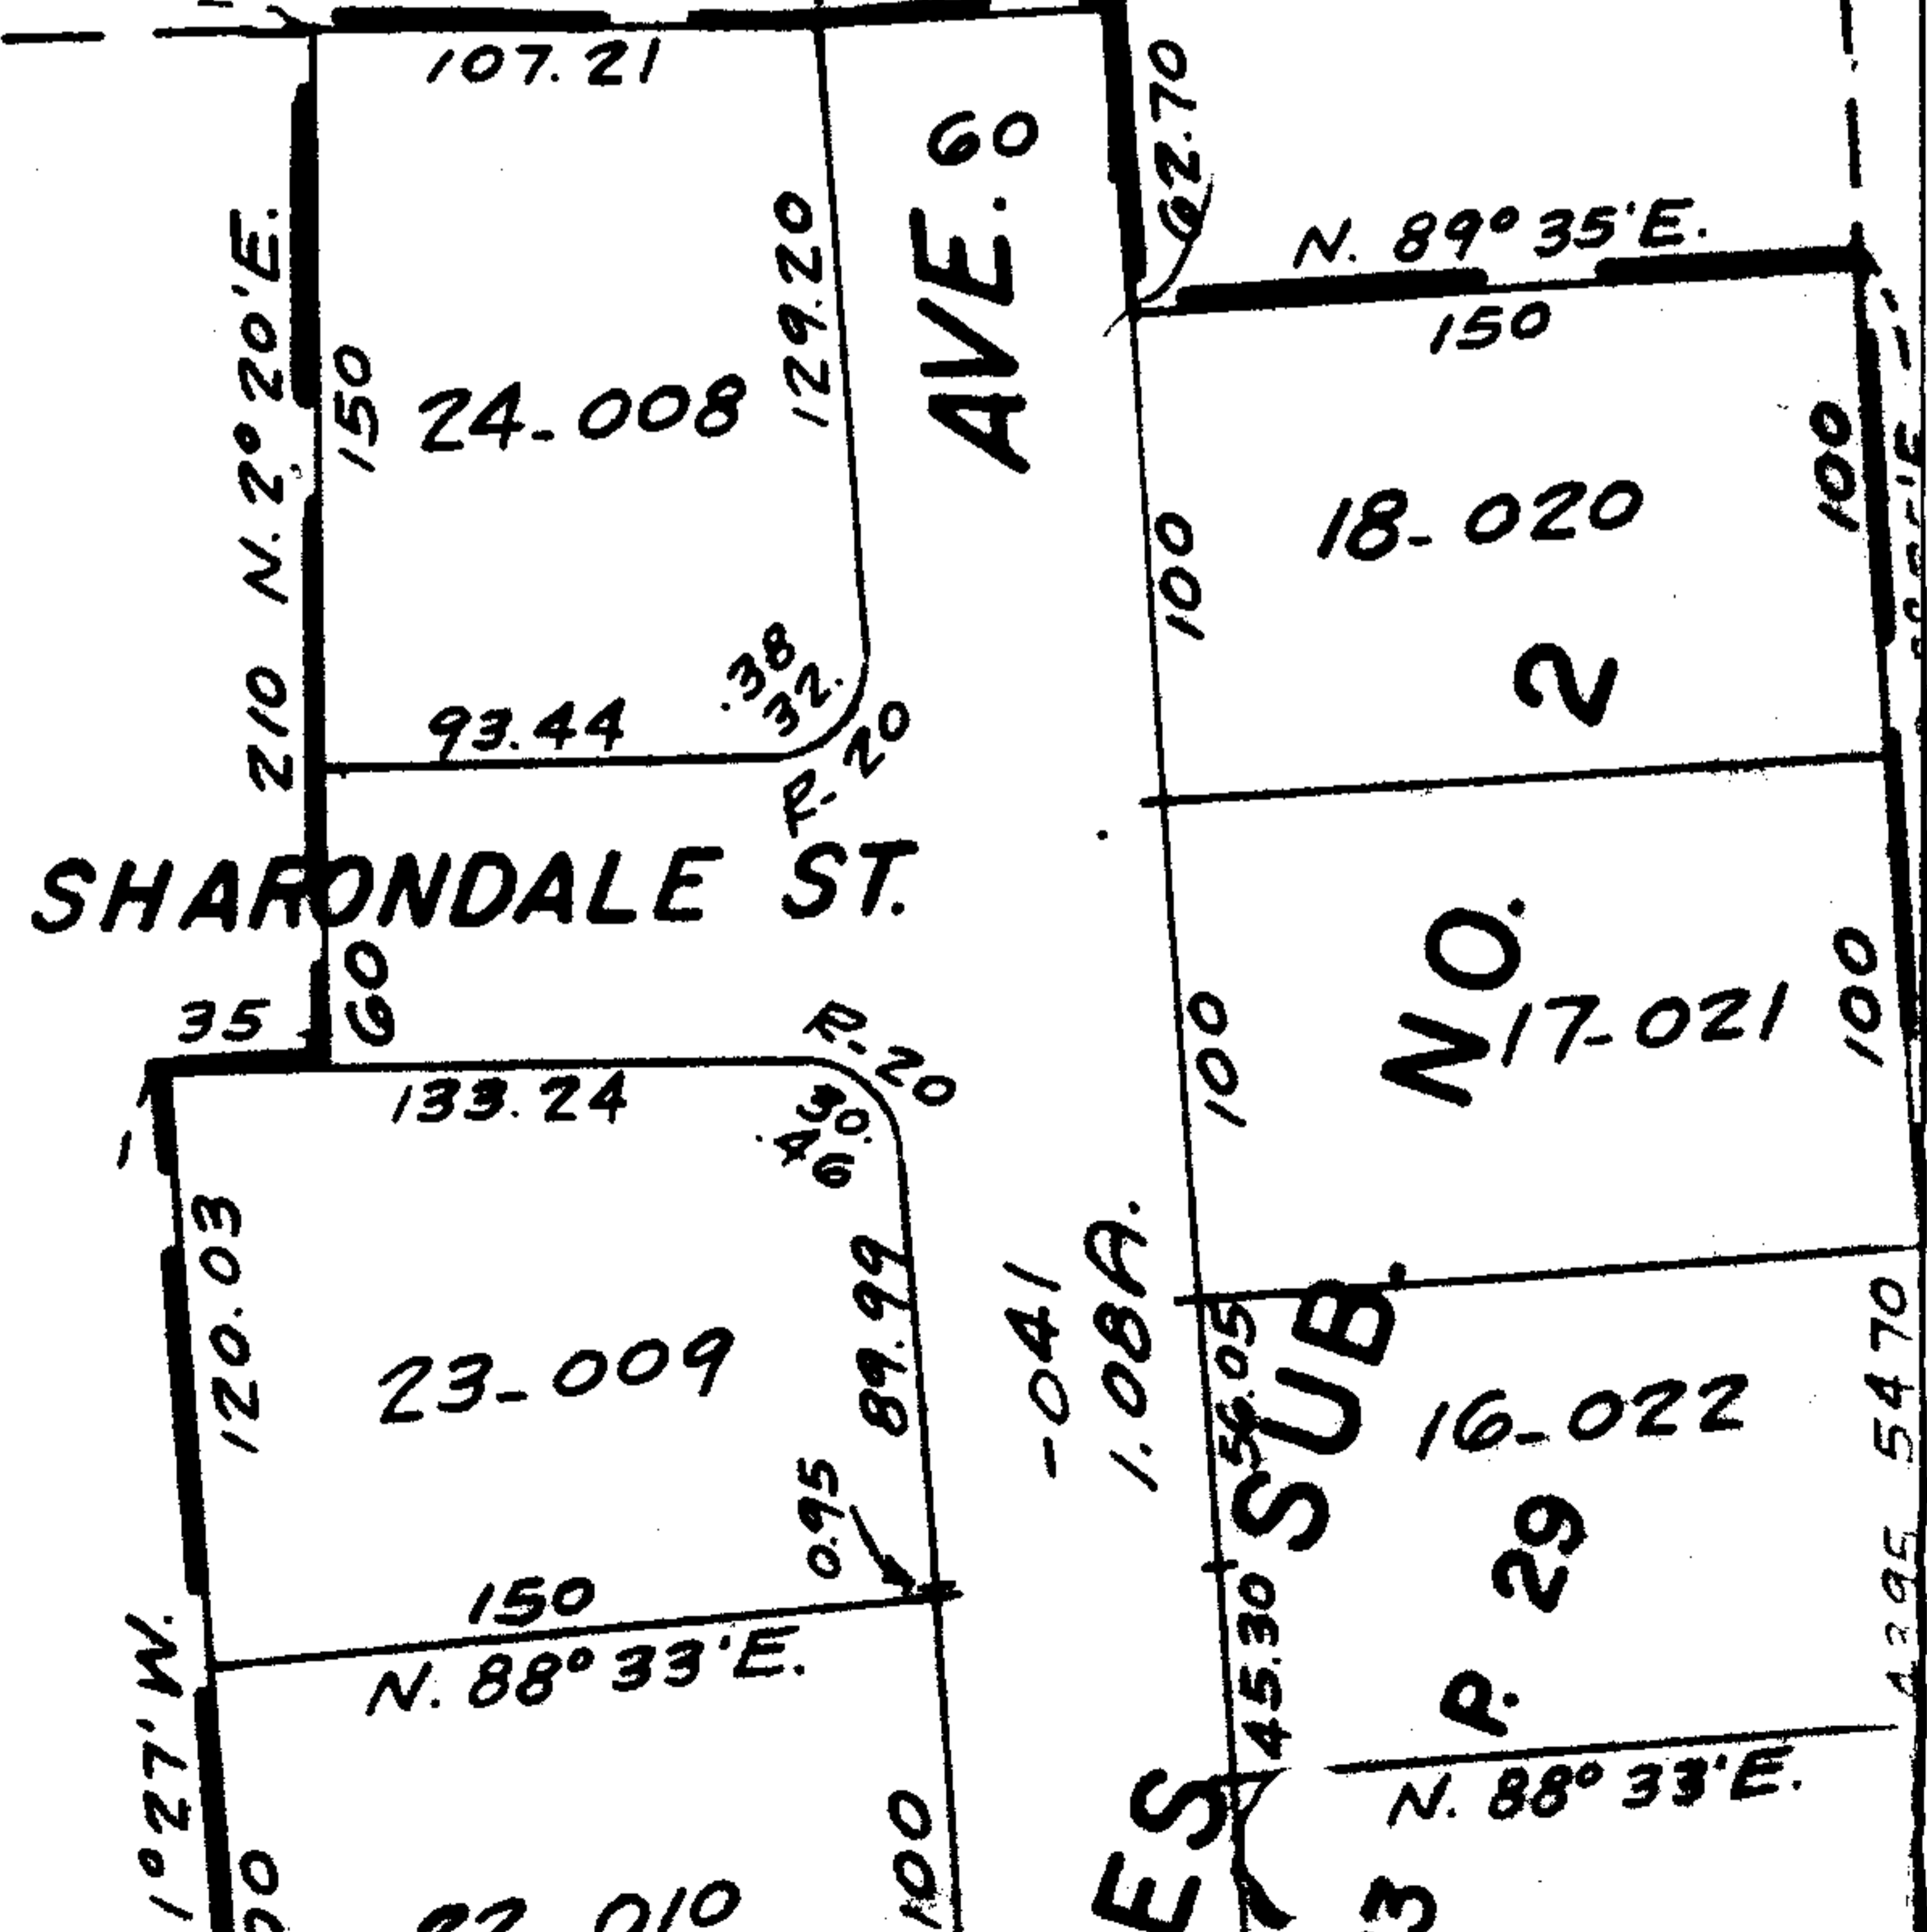

-062  
9.83A.

ES  
SUB. NO. 17-021

16-022  
P. 29  
N. 88° 33' E.

N. 89° 35' E.

2.00 - Clay  
69 Ac

150

410  
200

62.70

AVE. 60

SHARONDALE ST.

210 N. 2° 20' E.

107.21

24-008

93.44

129.20

133.24

23-009

150  
N. 88° 33' E.

92-010

NO. 17-021

16-022

N. 88° 33' E.

100

100

2.00

150

100

100

4395 5470

-041  
1.08A.

45.30

100

100

62.70

2.00

150

410