


7040 RD.

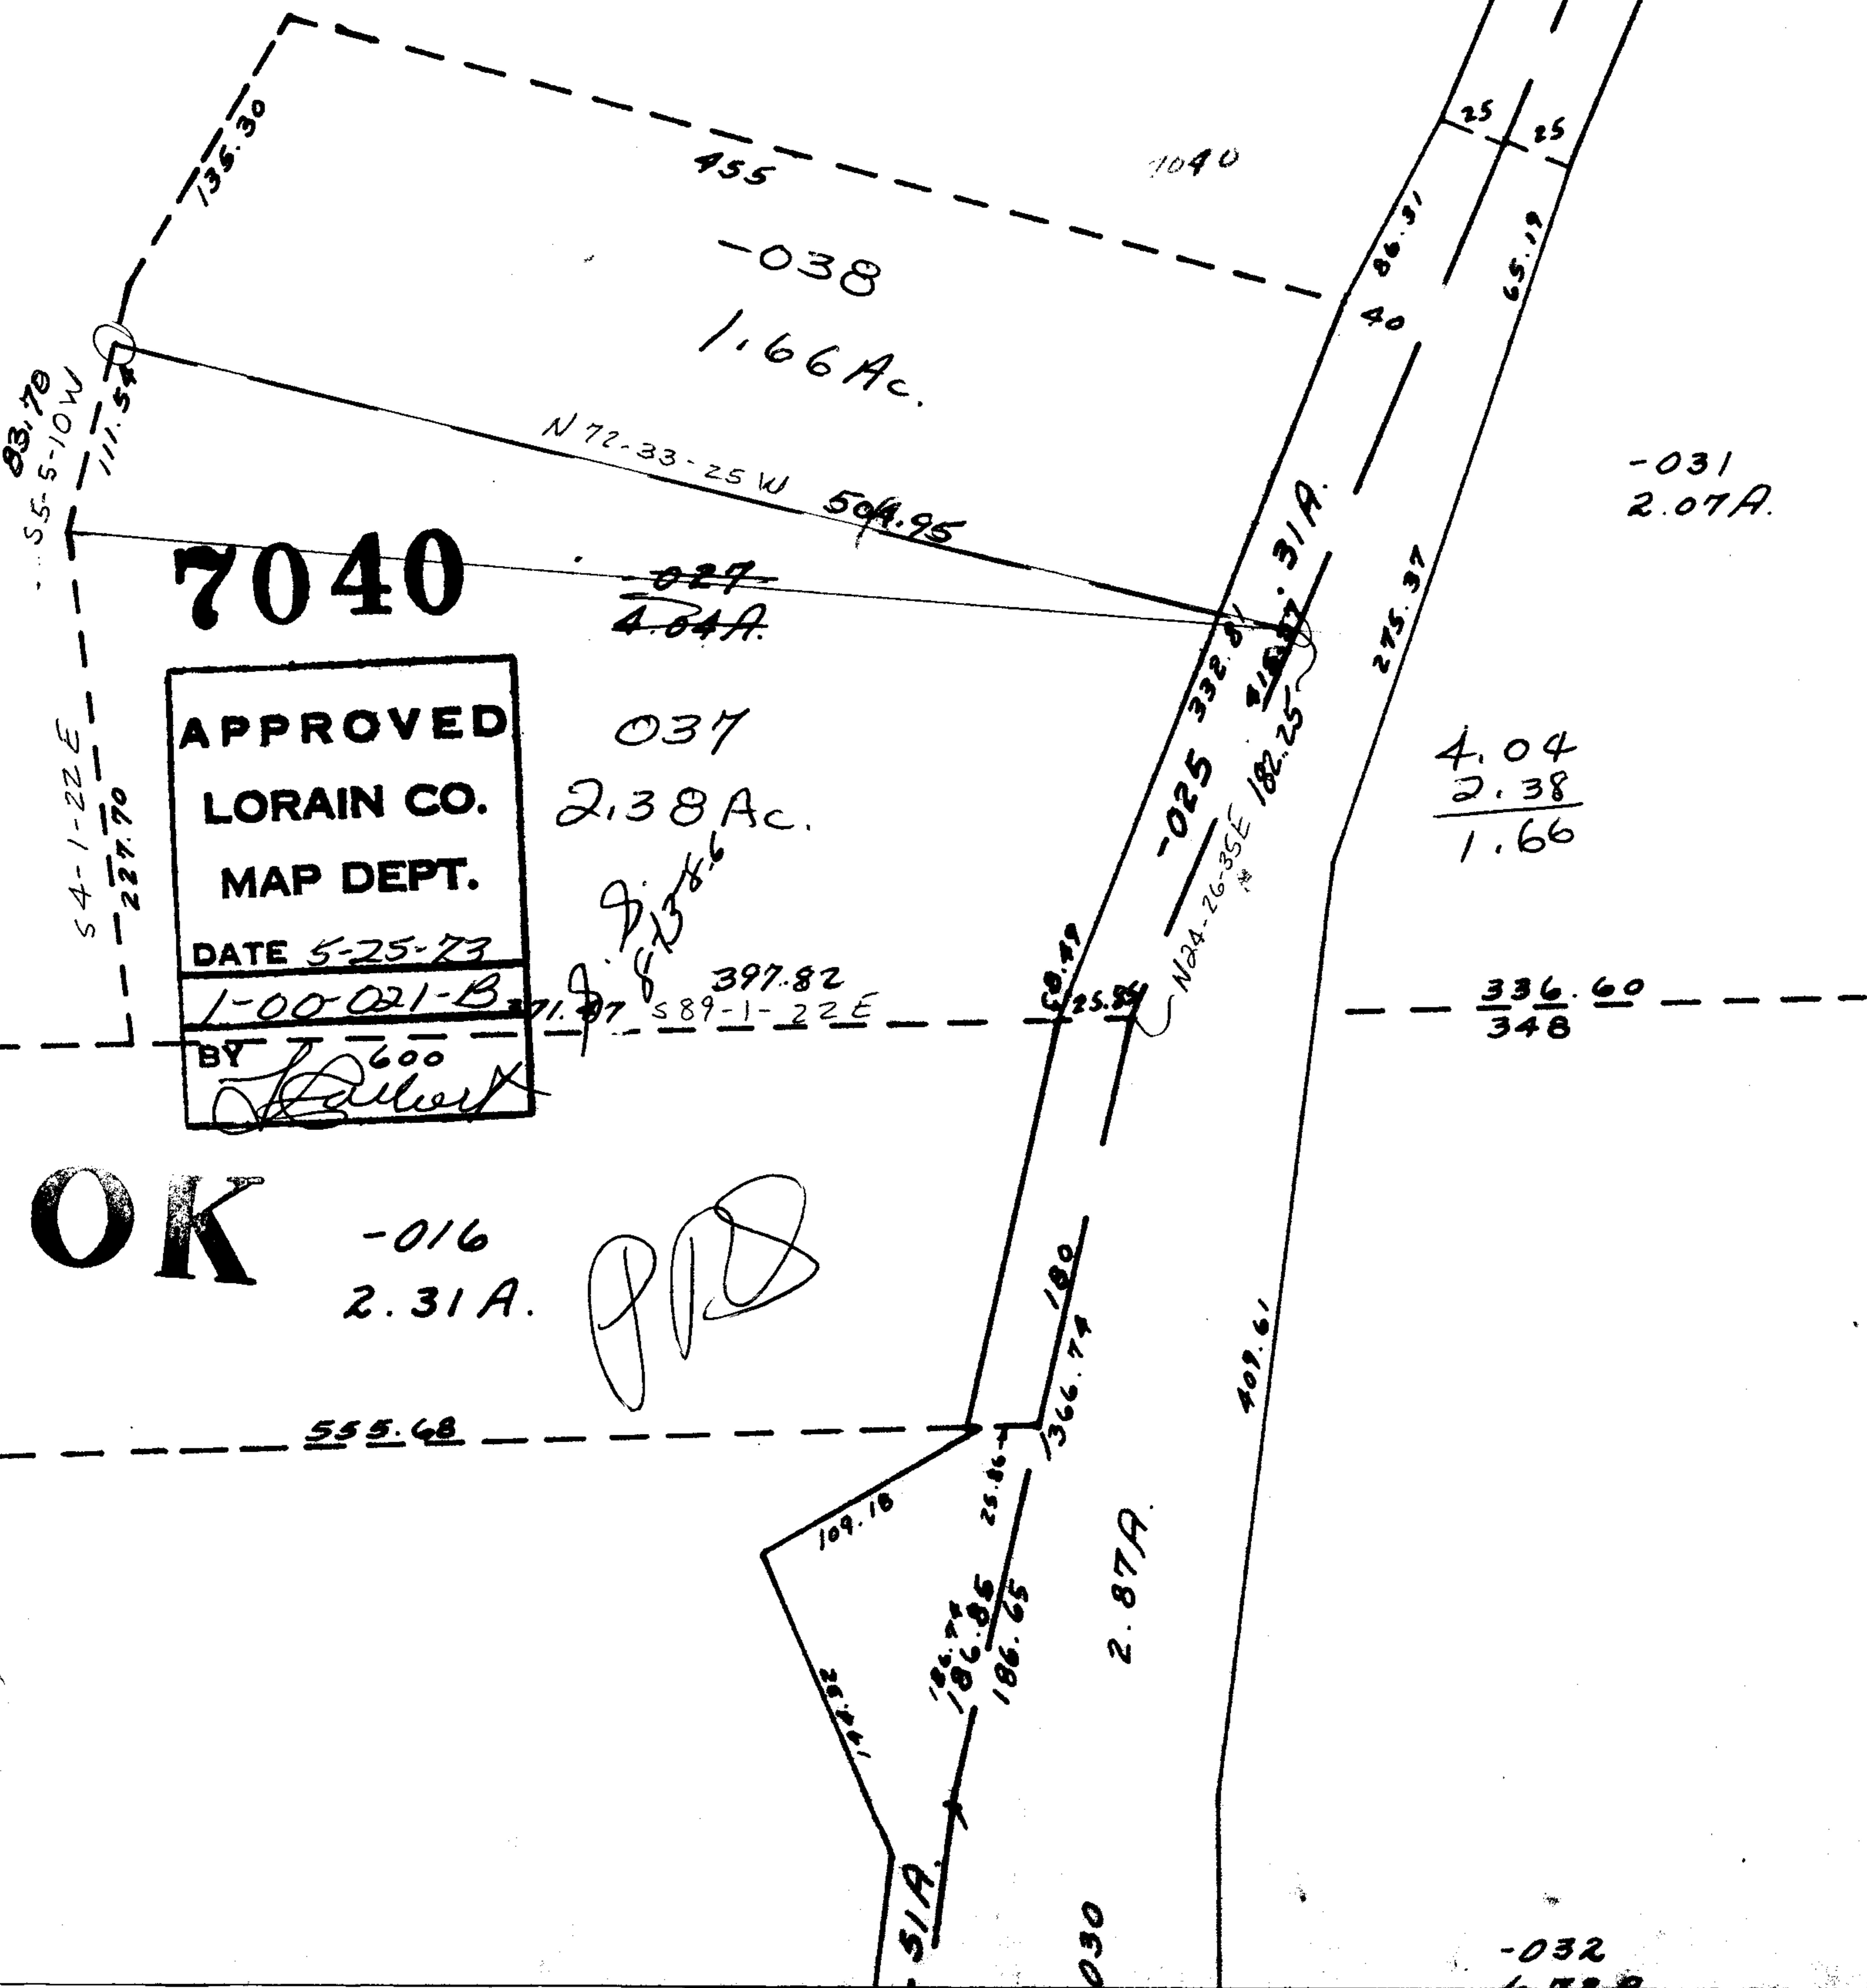

7040

APPROVED
 LORAIN CO.
 MAP DEPT.
 DATE 5-25-73
 1-00-021-B
 BY *[Signature]*

OK

-016
2.31A.

[Handwritten signature]

037
2.38 Ac.

~~027~~
4.04A.

-038
1.66 Ac.

-031
2.07A.

4.04
2.38
1.66

336.60
348

2.87A.

-032