


- 004
49.00 A.

7044

- 002
68.00 A.

8

7044
APPROVED
LORAIN CO.
MAP DEPT.
DATE 5-29-73
134
BY L.V. Hall
74-818-986

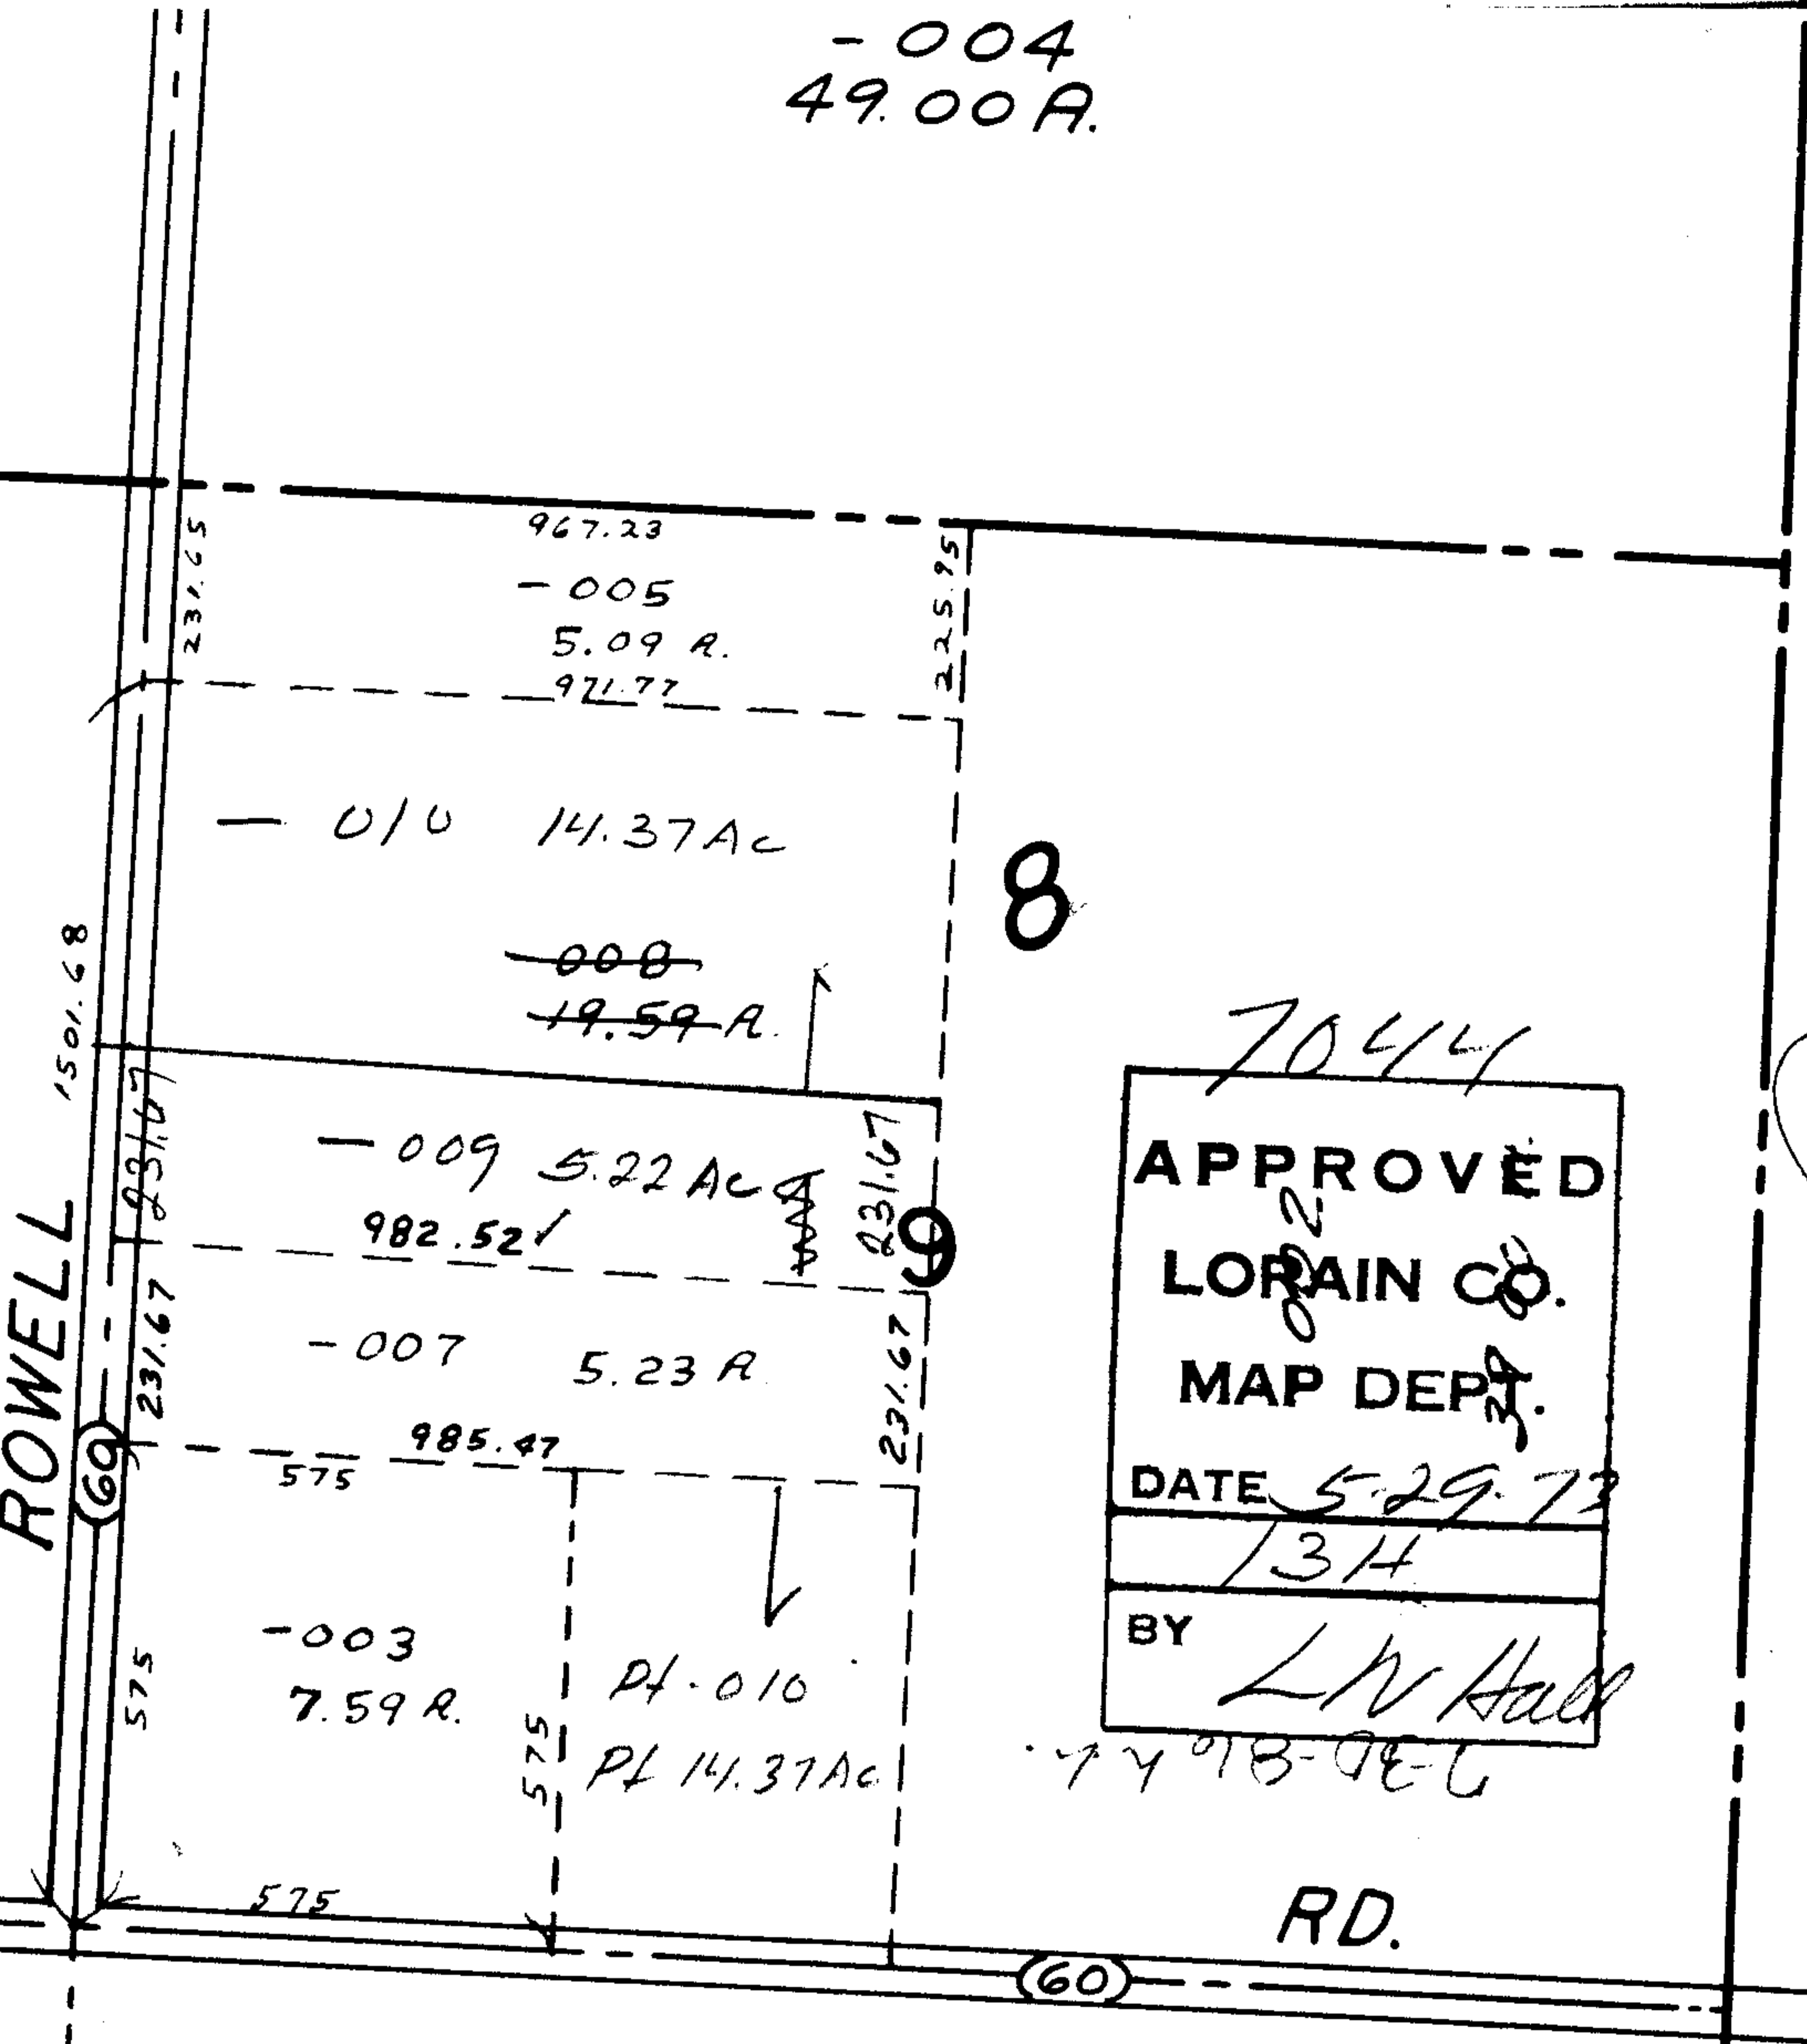

19.59
- 5.22
14.37

- 002
73.00 A.

11

- 001
70.00 A.

10