


2441 GORE 566.5 ORPHANAGE

1219

796 14

2441

67 75

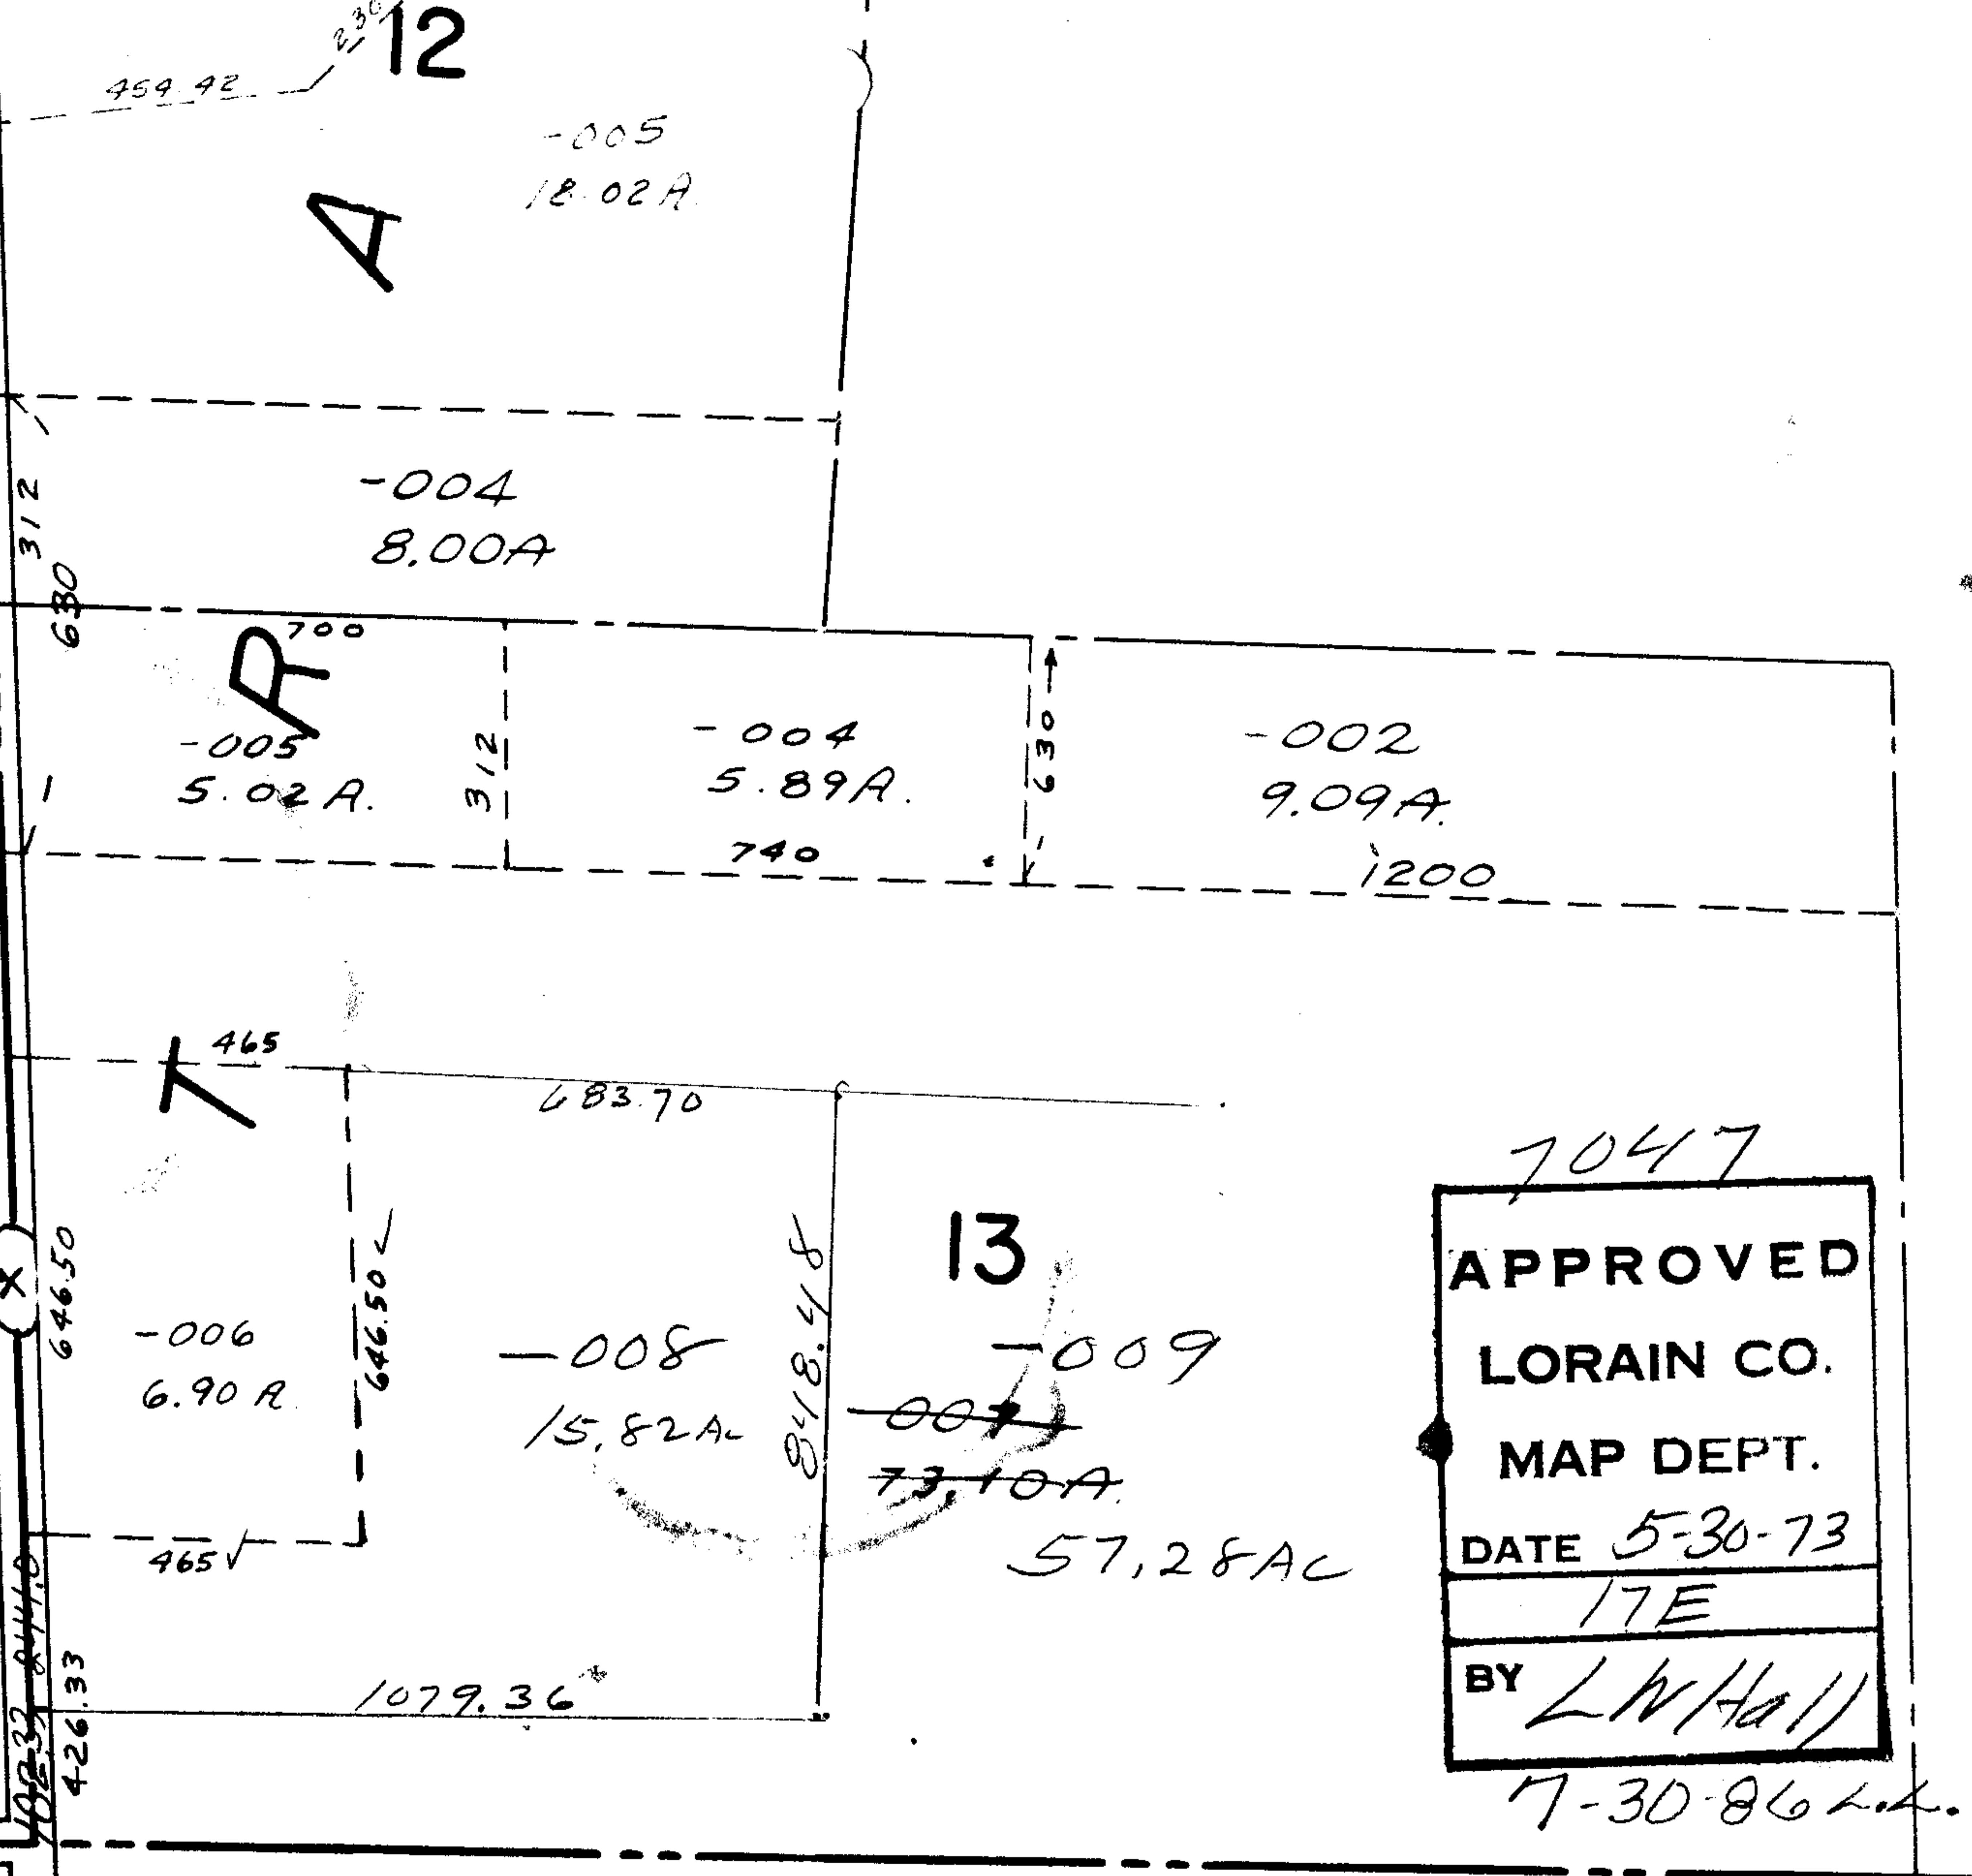

7047  
 APPROVED  
 LORAIN CO.  
 MAP DEPT.  
 DATE 5-30-73  
 17E  
 BY L.W. Hall

*[Handwritten signature]*  
 OK

Stocking RD.

VP.

GORING STRIP LOTS 15, 16, 8, SLY  
 TRACT 6 " 1, 4, 5, 8, 12  
 " 7 " 19, 20

7047