


7048

7048 8-13-86 7048


YO

APPROVED
 LORAIN CO.
 MAP DEPT.
 DATE 5-31-73
 2-02-006B
 BY LWHall

E 2-02-015-B

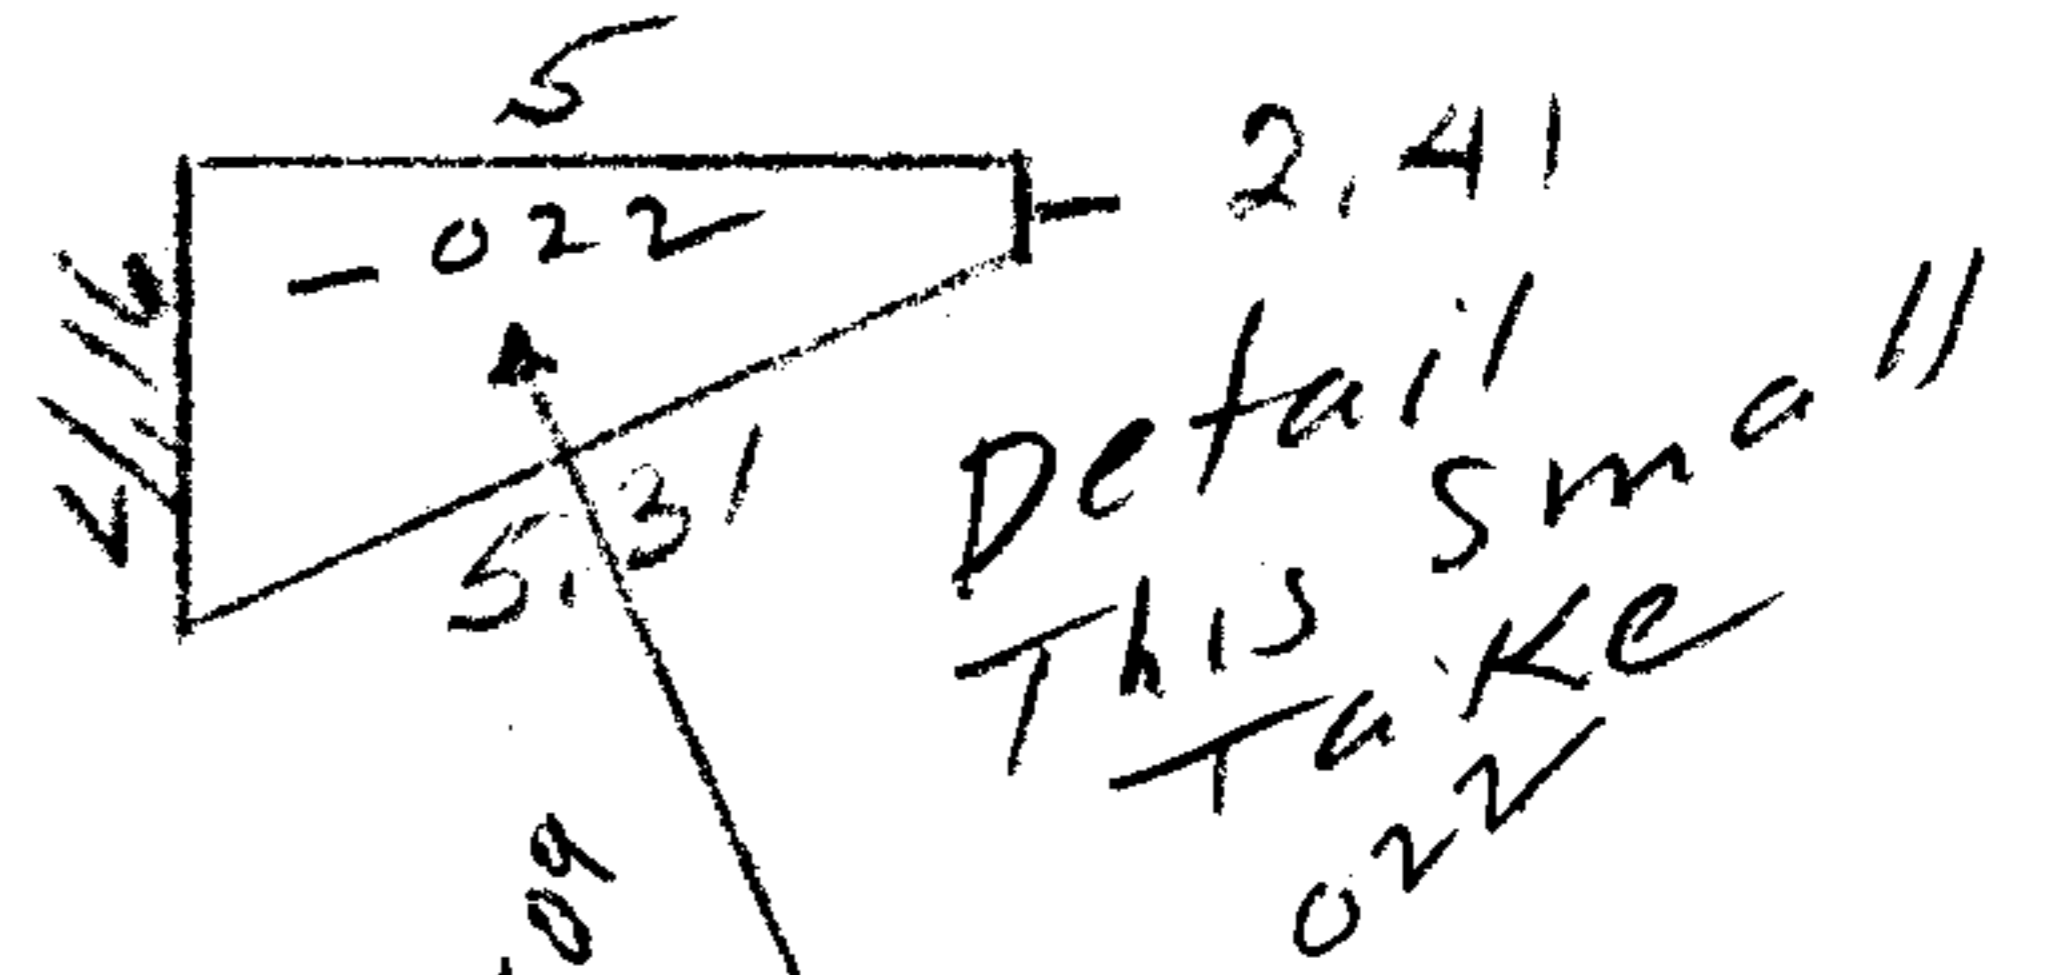

297.76
 5040
 37816

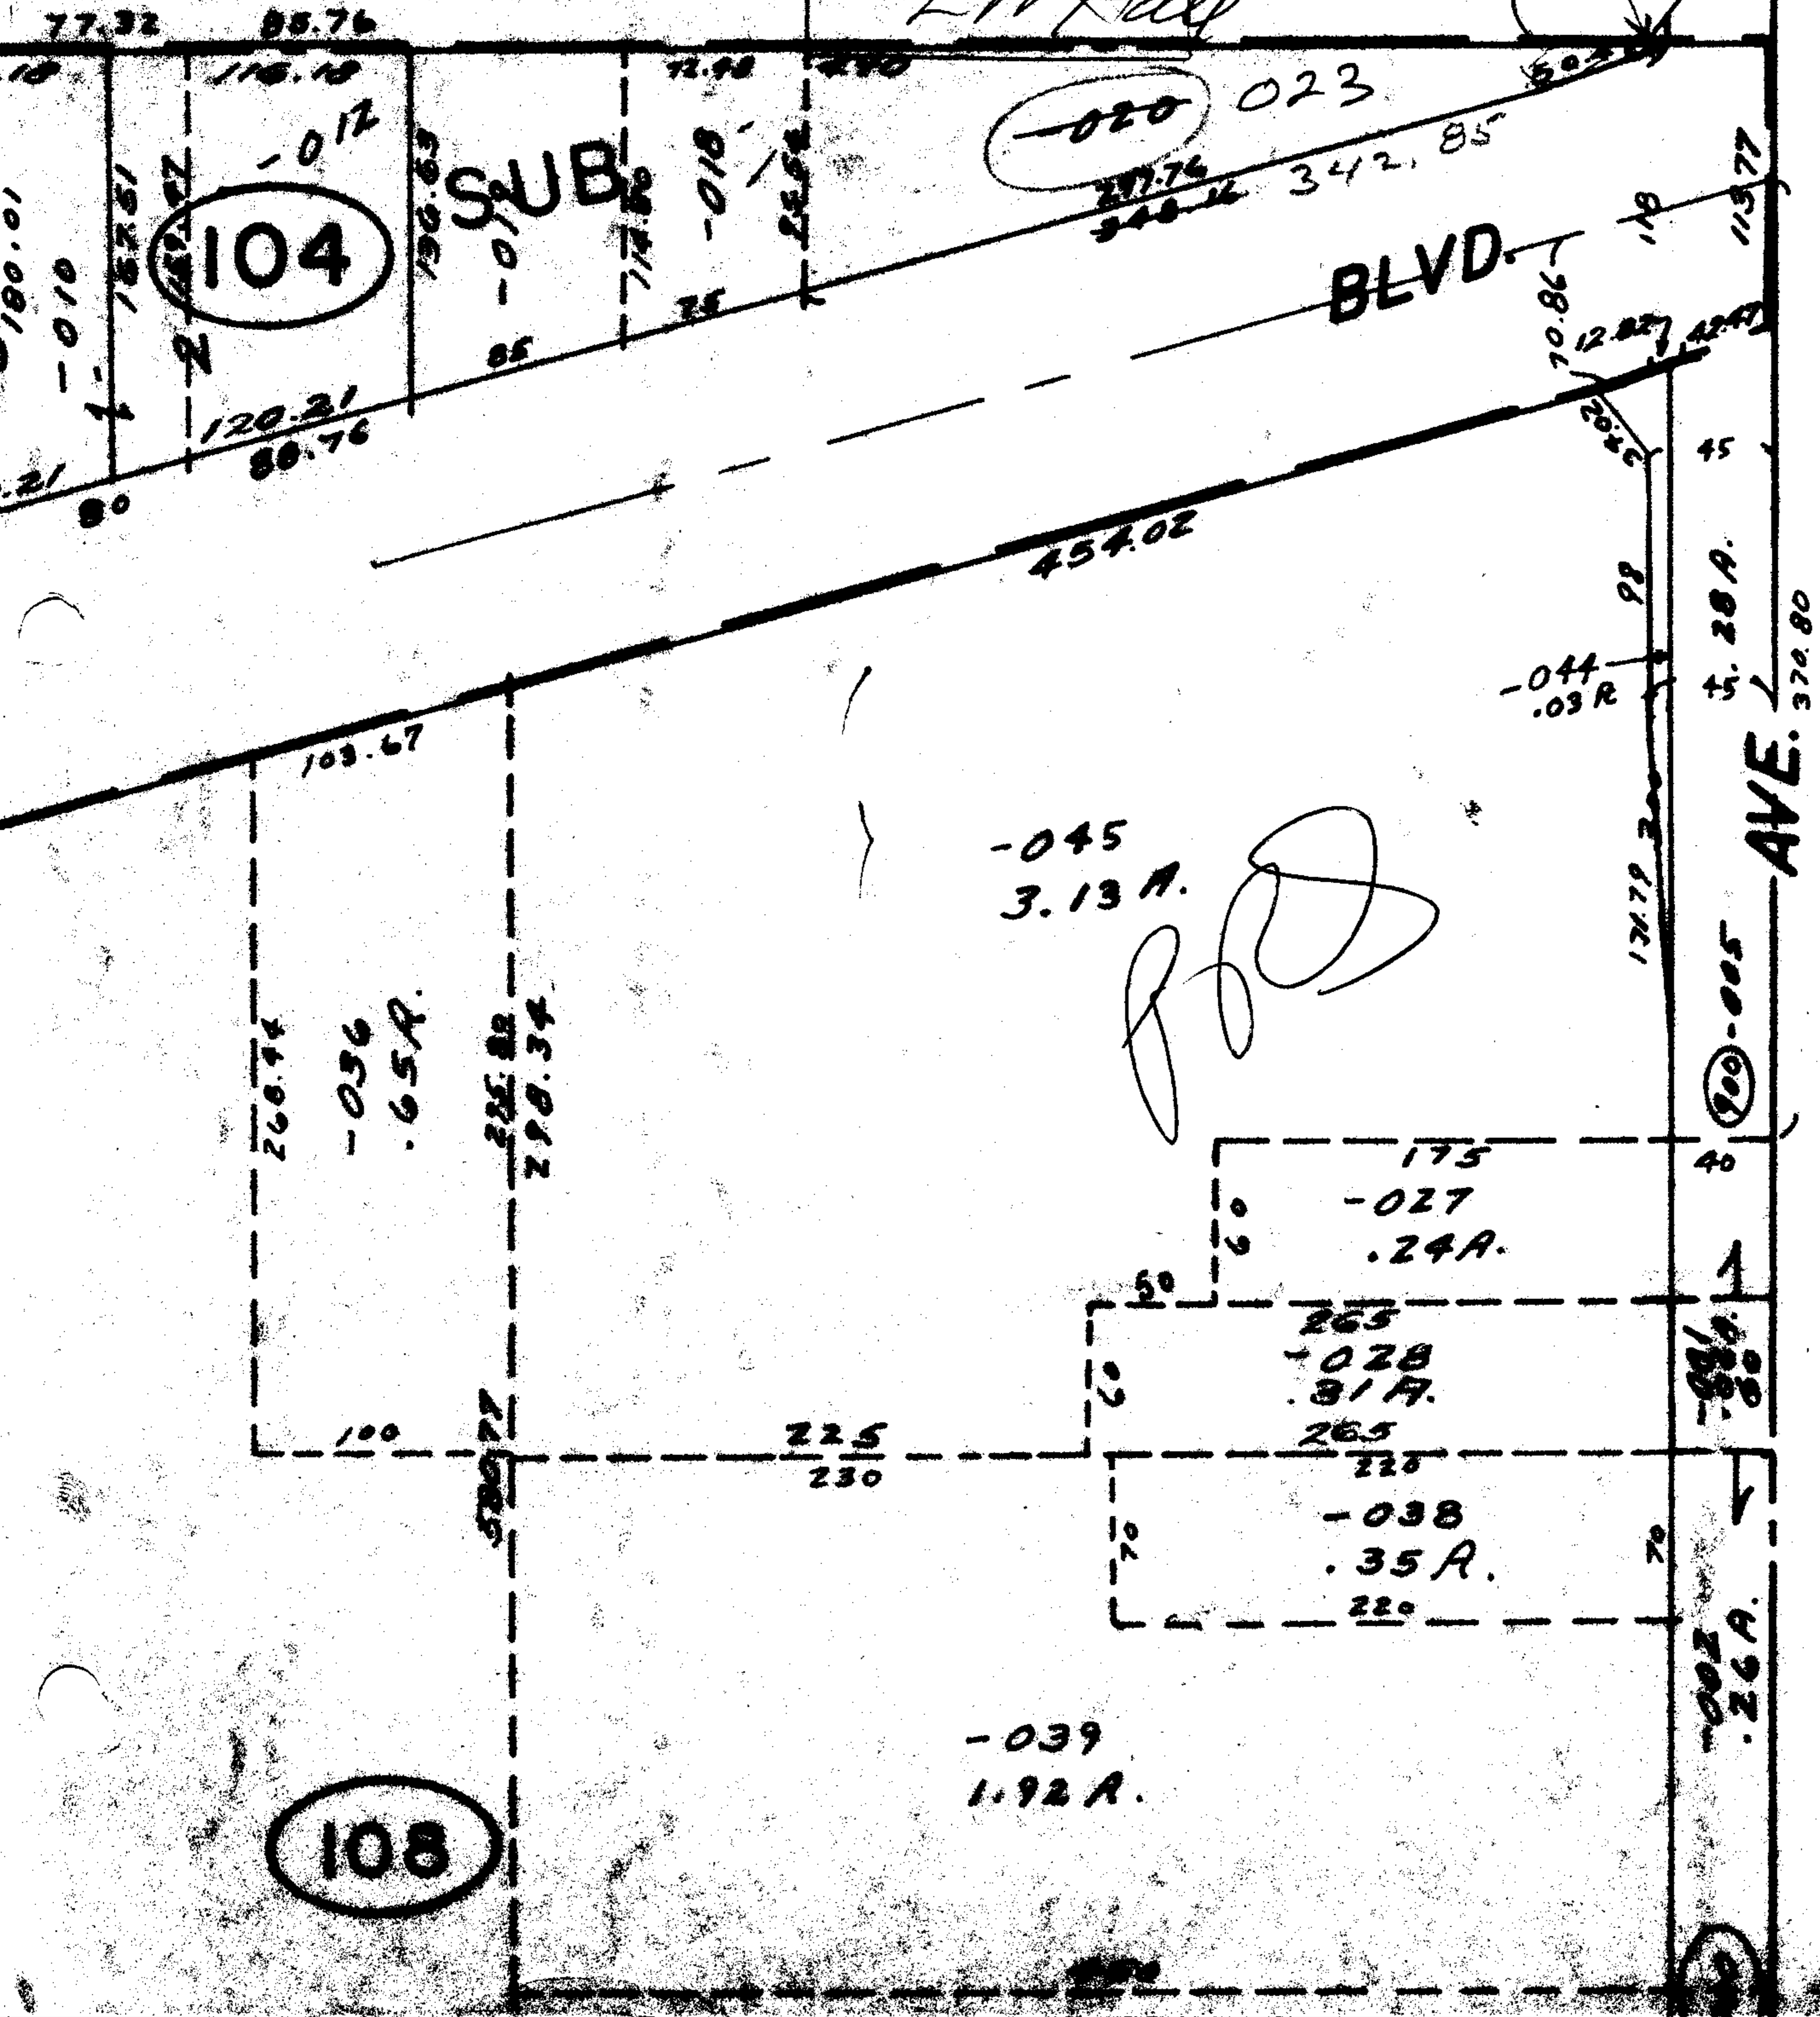

260.44
 -036
 .65A.

-045
 3.13A.

175
 -027
 .24A.

265
 -028
 .31A.

220
 -038
 .35A.

-039
 1.92A.

880
 -002
 .26A.