

7058

RD.
(X)

ROOT

OK

- 001
14.31A.

PRJ.

7056


APPROVED
LORAIN CO.
MAP DEPT.
DATE 6-5-73
12-00-099A
BY L.W. Hall

9.8
13
18

028
5.49A.

*Trans.
6-6-73*

Handwritten notes

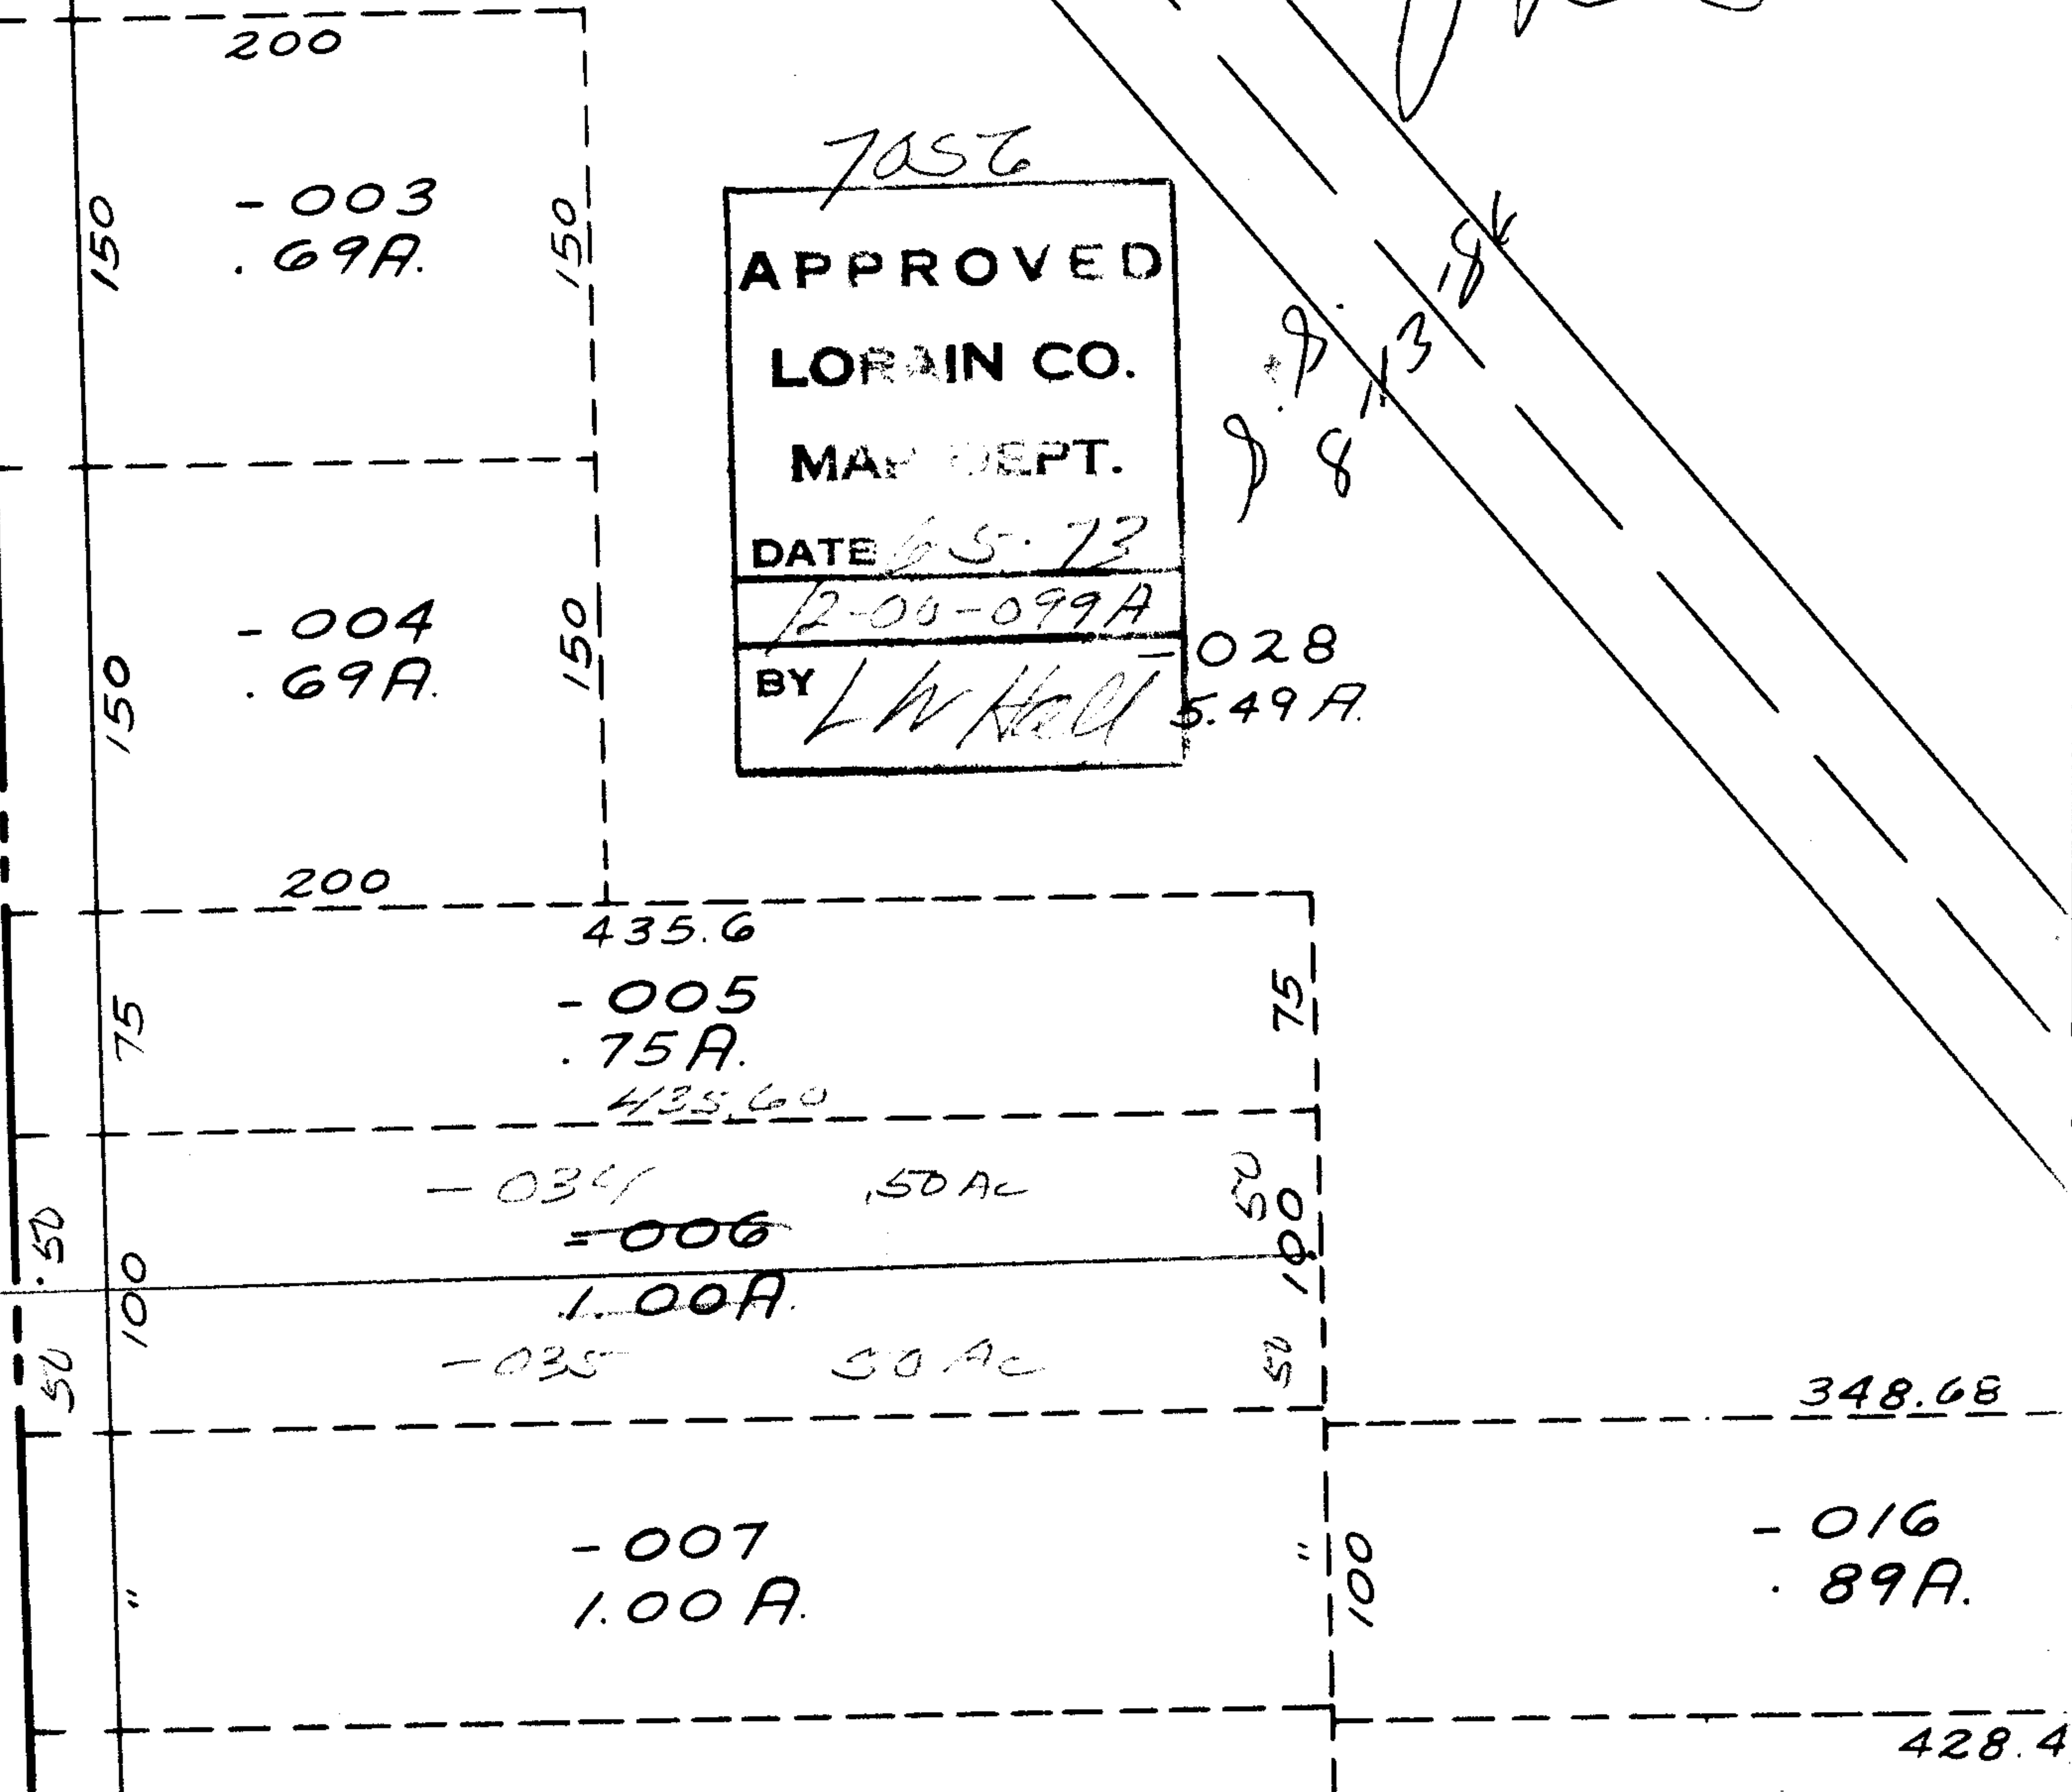

428.4