

7065

see
Pg 11-D →

343

7065

OK

[Handwritten signature]

027

Pt. ~~918~~

Pt. ~~5947~~

Sta. 9900

OK


8.8.8-13-86

* APPROVED	
LORAIN CO.	
MAP DEPT.	
DATE 6-5-73	
11-00-027A + 11D	
BY	LW Hall

See 11-D →

Island Rd

25'

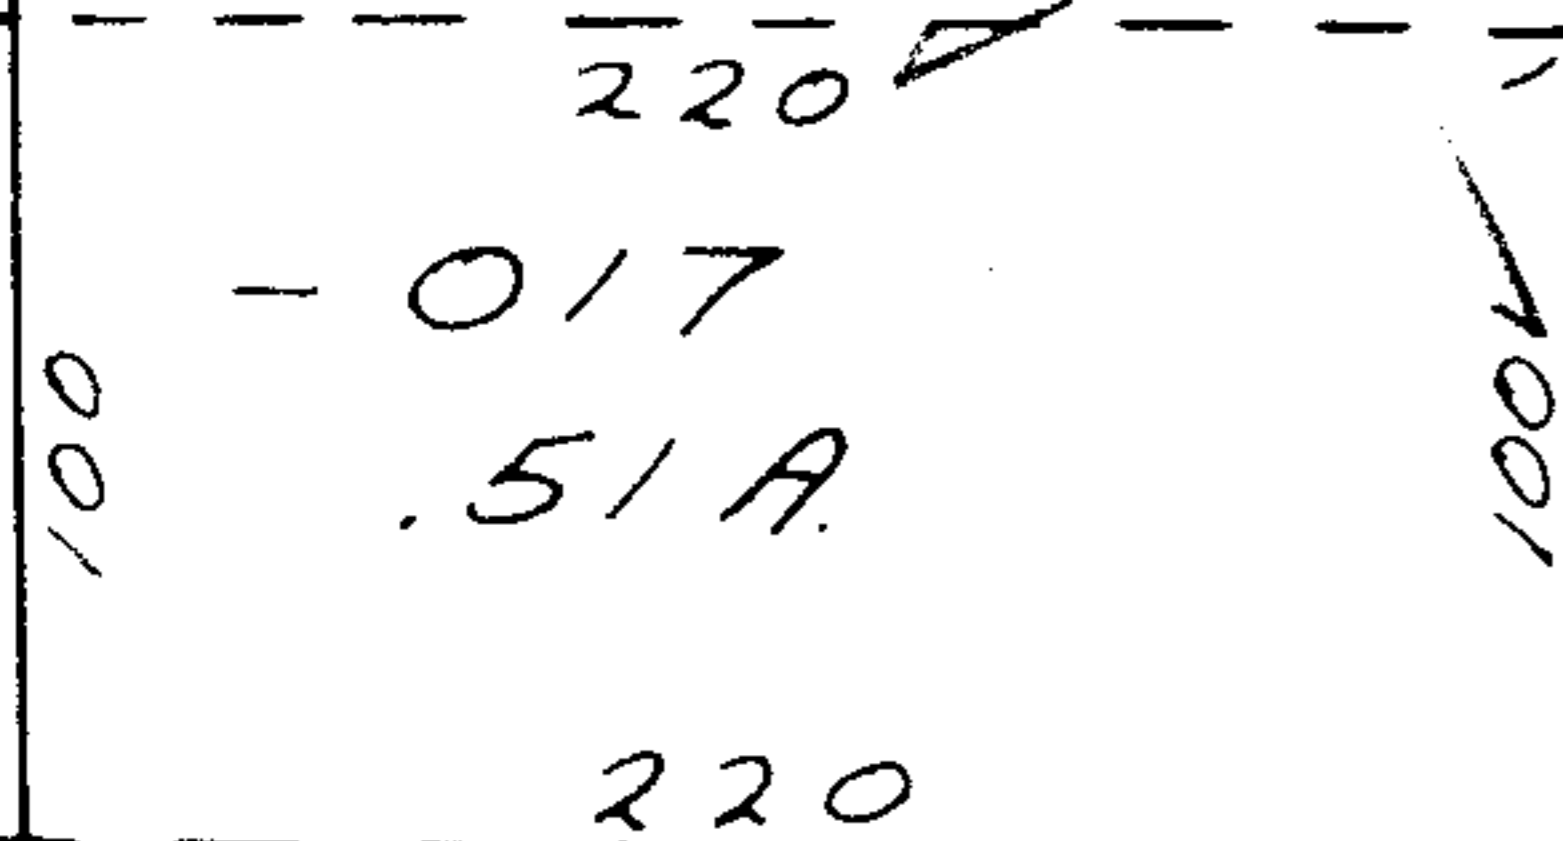

-026
2.50

872.77

1001

28

-006
1.00 A.

500.68

652.77

300.0

28

25'