


7070

7070  
OK

Chart R 270

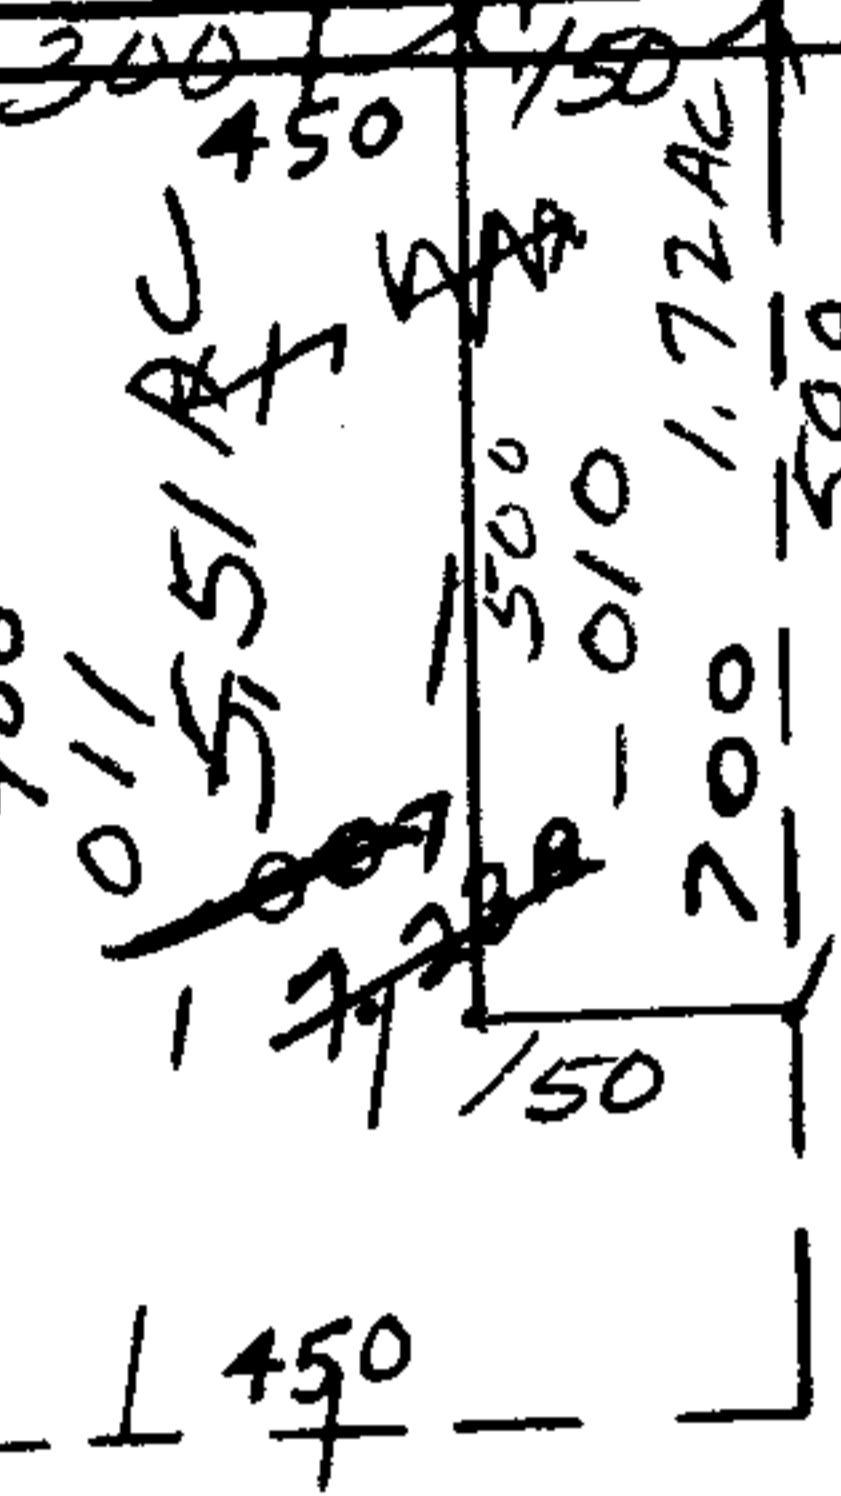

-006  
25.76 A.

OK

7070


APPROVED  
LORAIN CO.  
MAP DEPT.  
507.92  
DATE 6-7-73  
213  
BY L. W. Hall

9/13  
9/4  
-009  
45.23 R.


transferred  
7-3-73

A

539  
BURSLEY

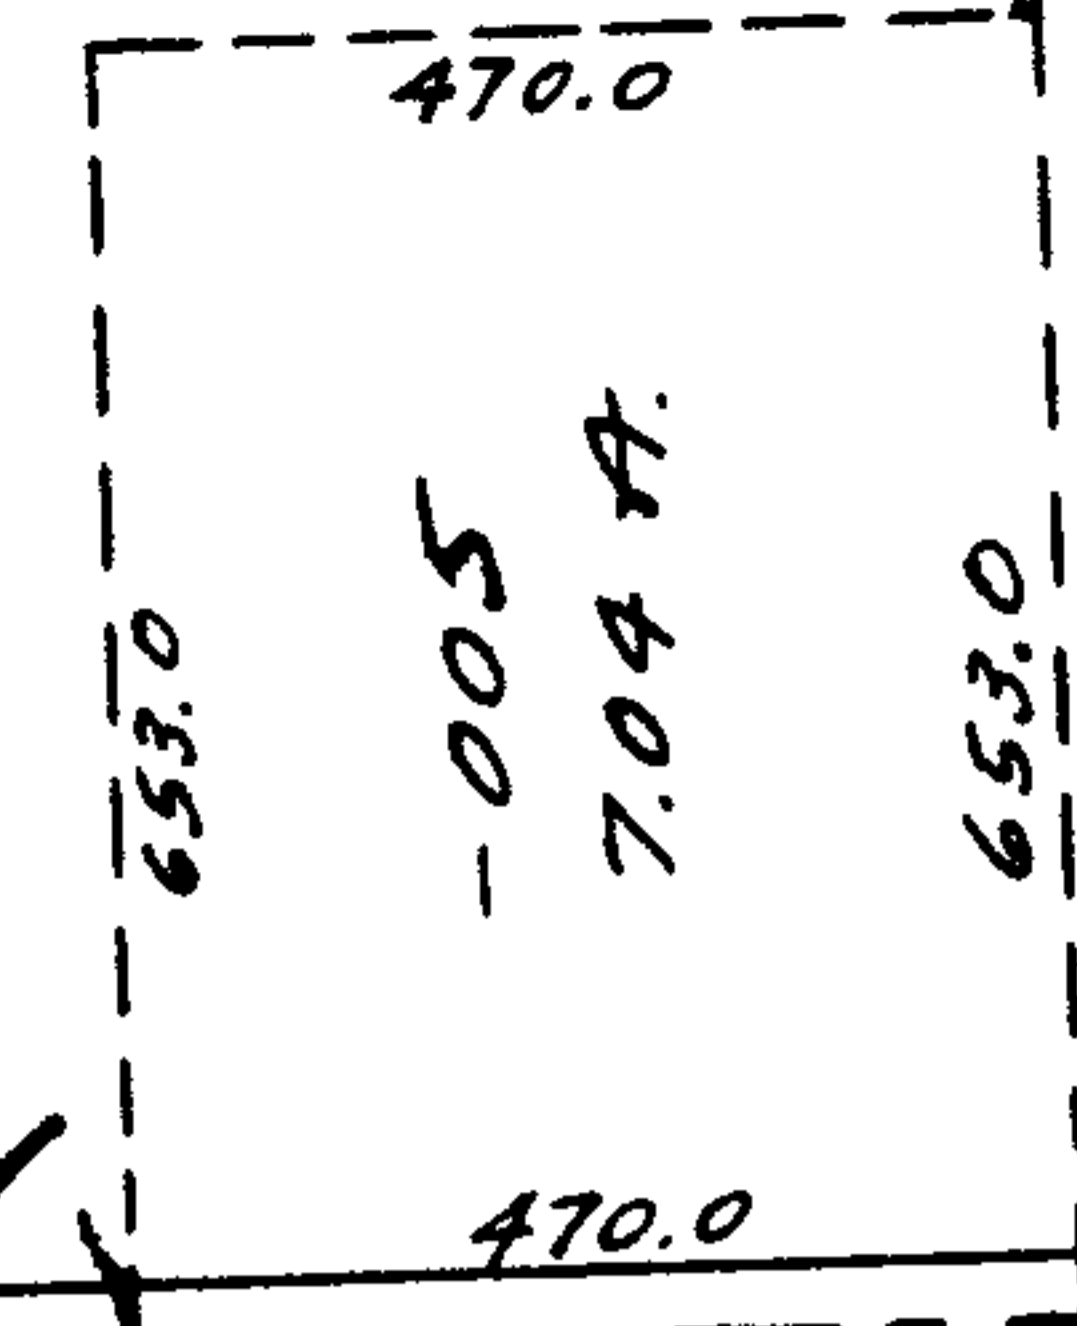


-004  
20.00 A.

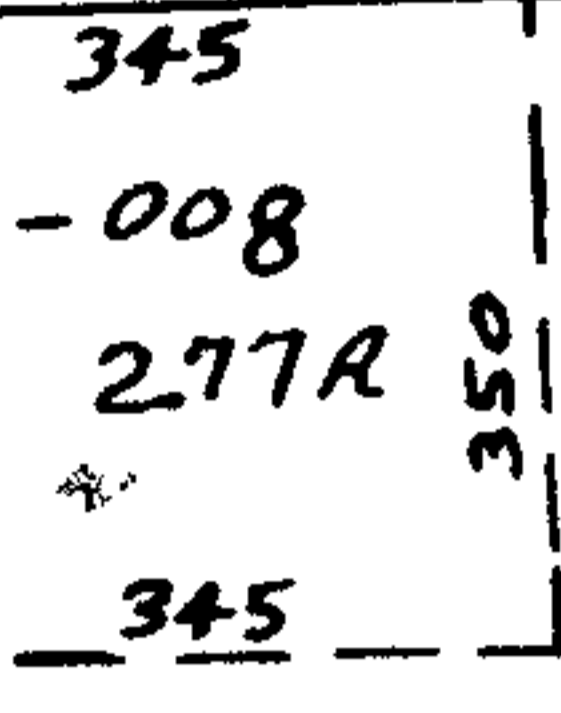

-009  
45.23 R.

-002  
46.25 A.

C

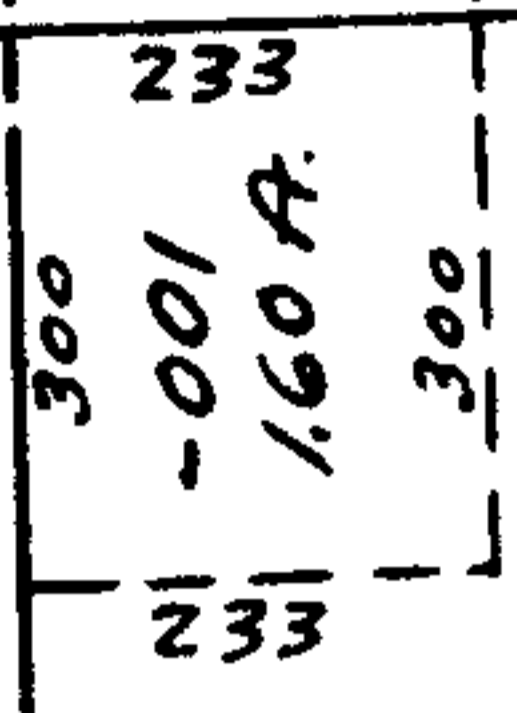

-002  
26.90 A.

7070