


7086

-028
Pt. -001
Pt. 61.68A
57.68A

OK

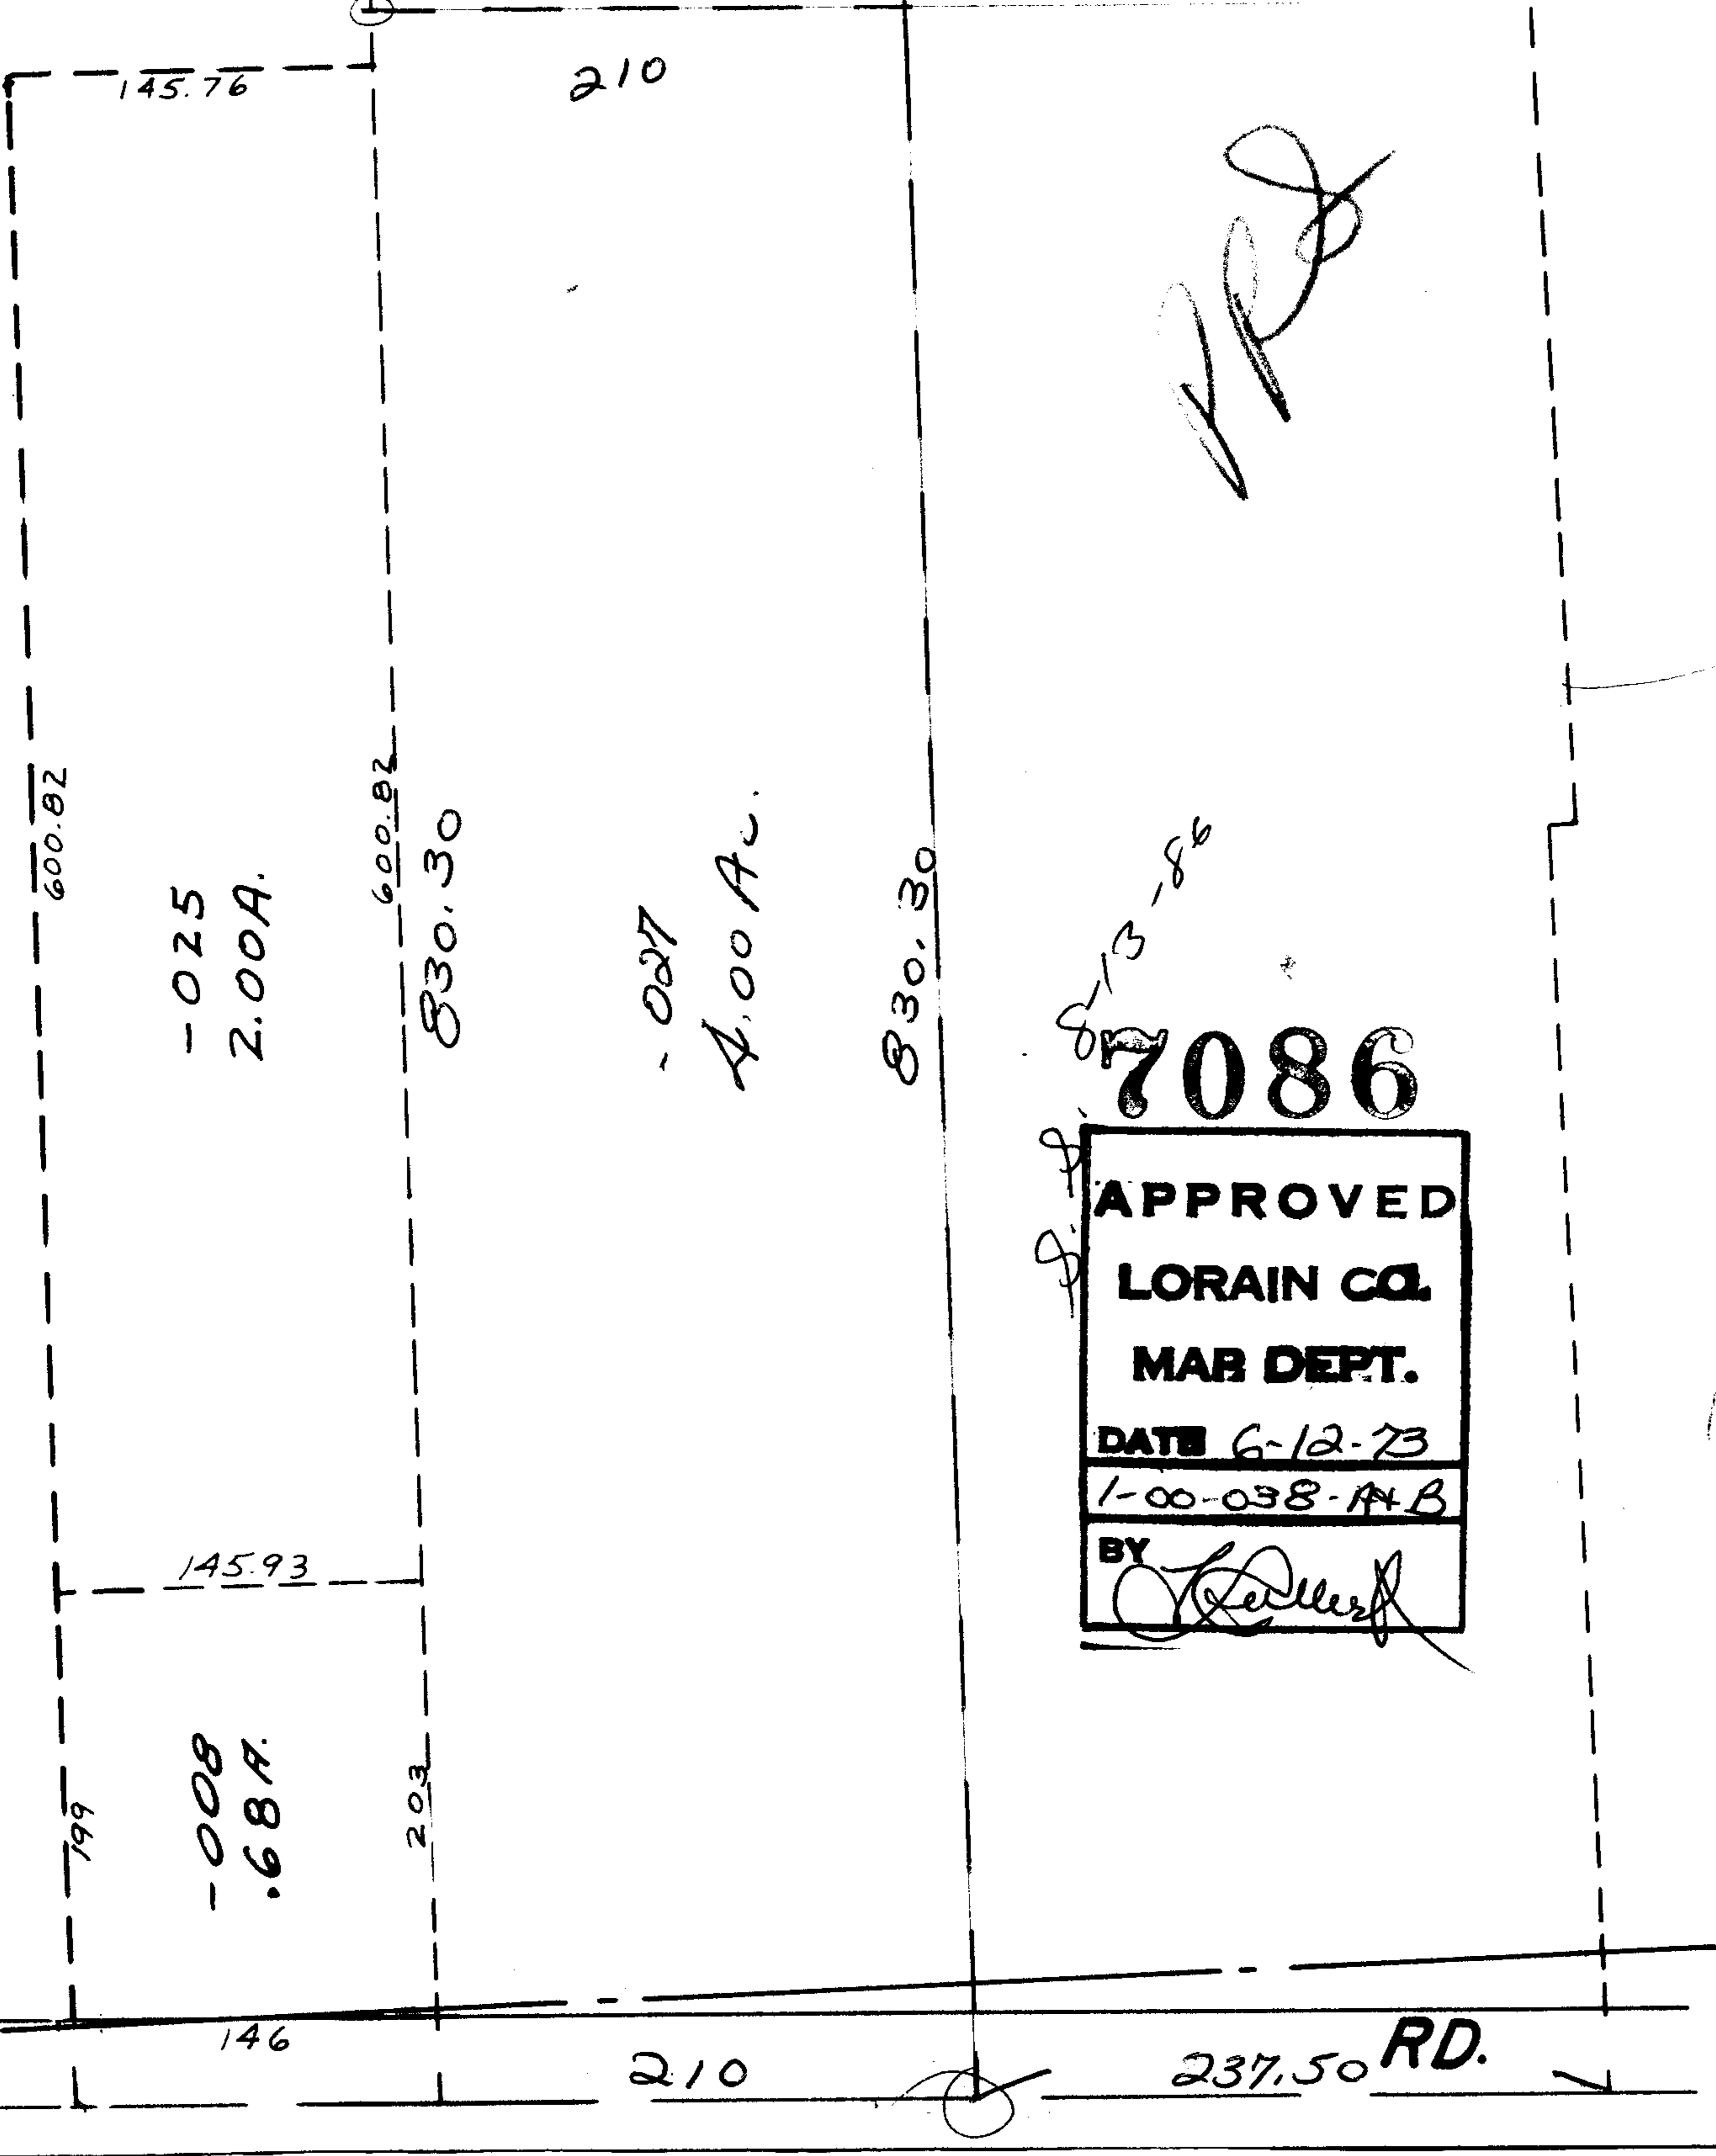

R.R.

S.S. 8-13-86

7086

APPROVED
LORAIN CO.
MAR DEPT.
DATE 6-12-73
1-00-038-A.B
BY *[Signature]*

7086