


SEE 4-00-018-E

83 -082	84 -081	85 -080	86 -079	87 -078	88 -077	89 -076	90 -075
WASHINGTON			SQUARE	VOL.	SUB.		
				28	88		

7104
 NO. #5
 PG.

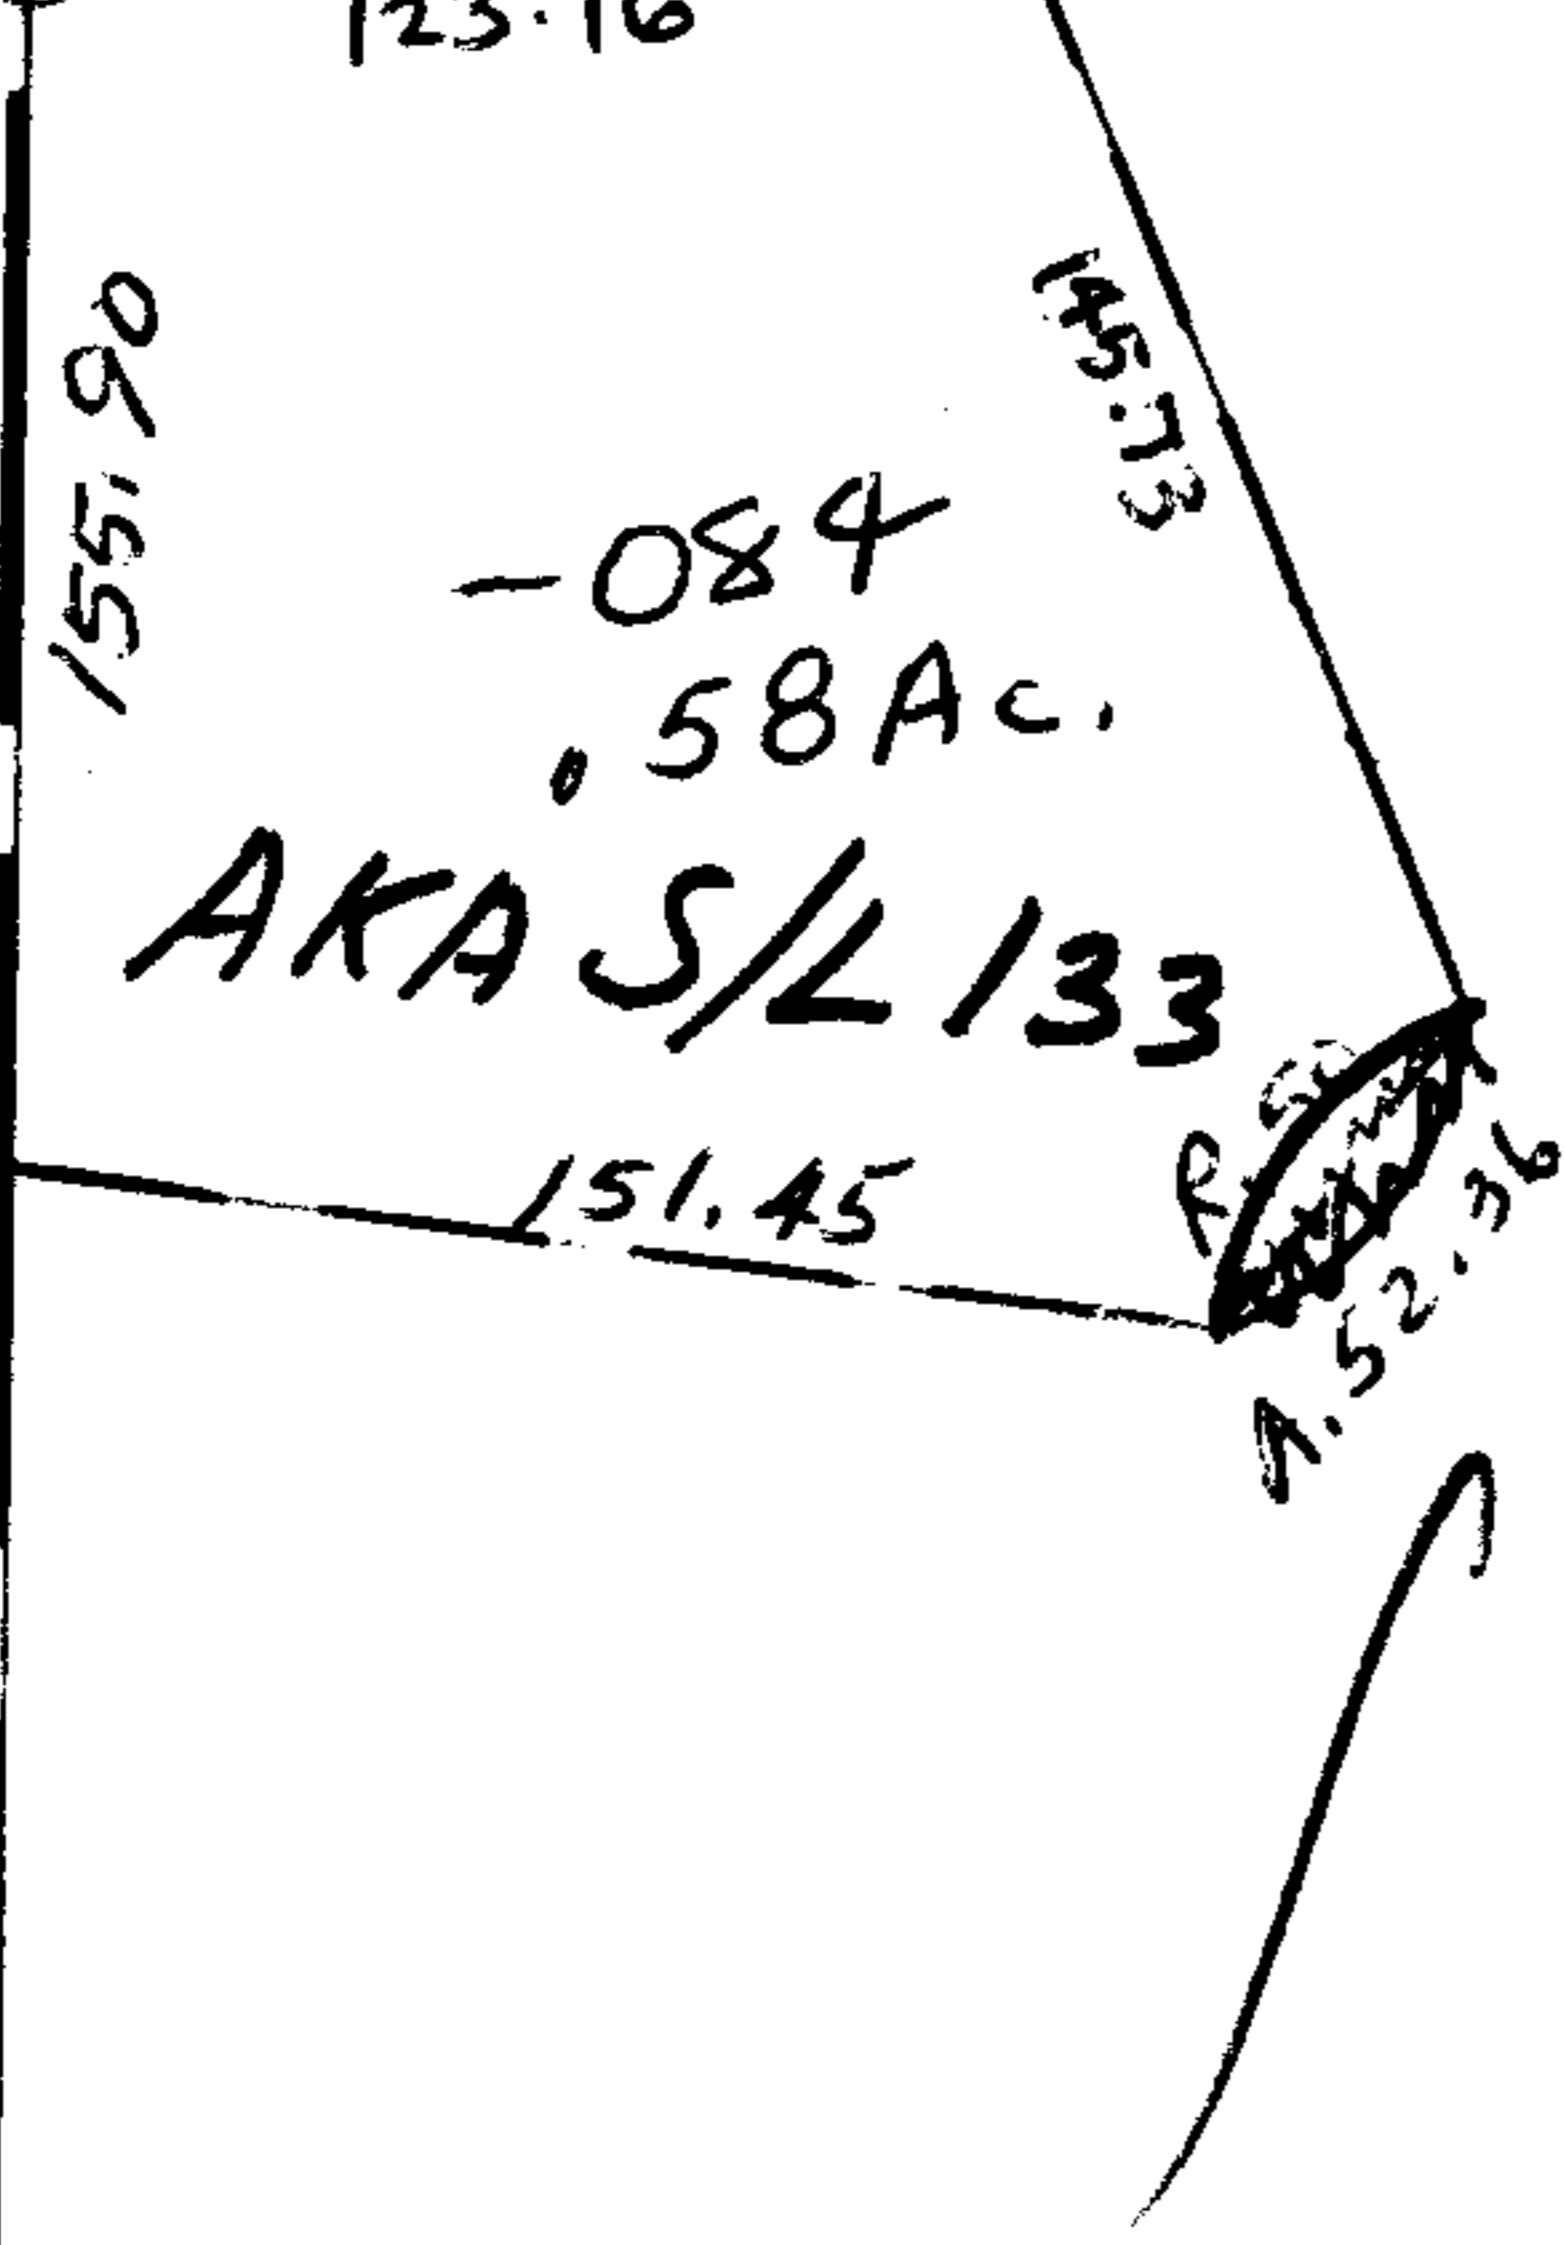


OK

[Signature]
 -085
~~283~~
~~21.64~~
 21.06 Ac.

7-3D-86k-k: **7104**

APPROVED
LORAIN CO.
MAP DEPT.
DATE 6-19-73
4-00-018-F
BY <i>[Signature]</i>

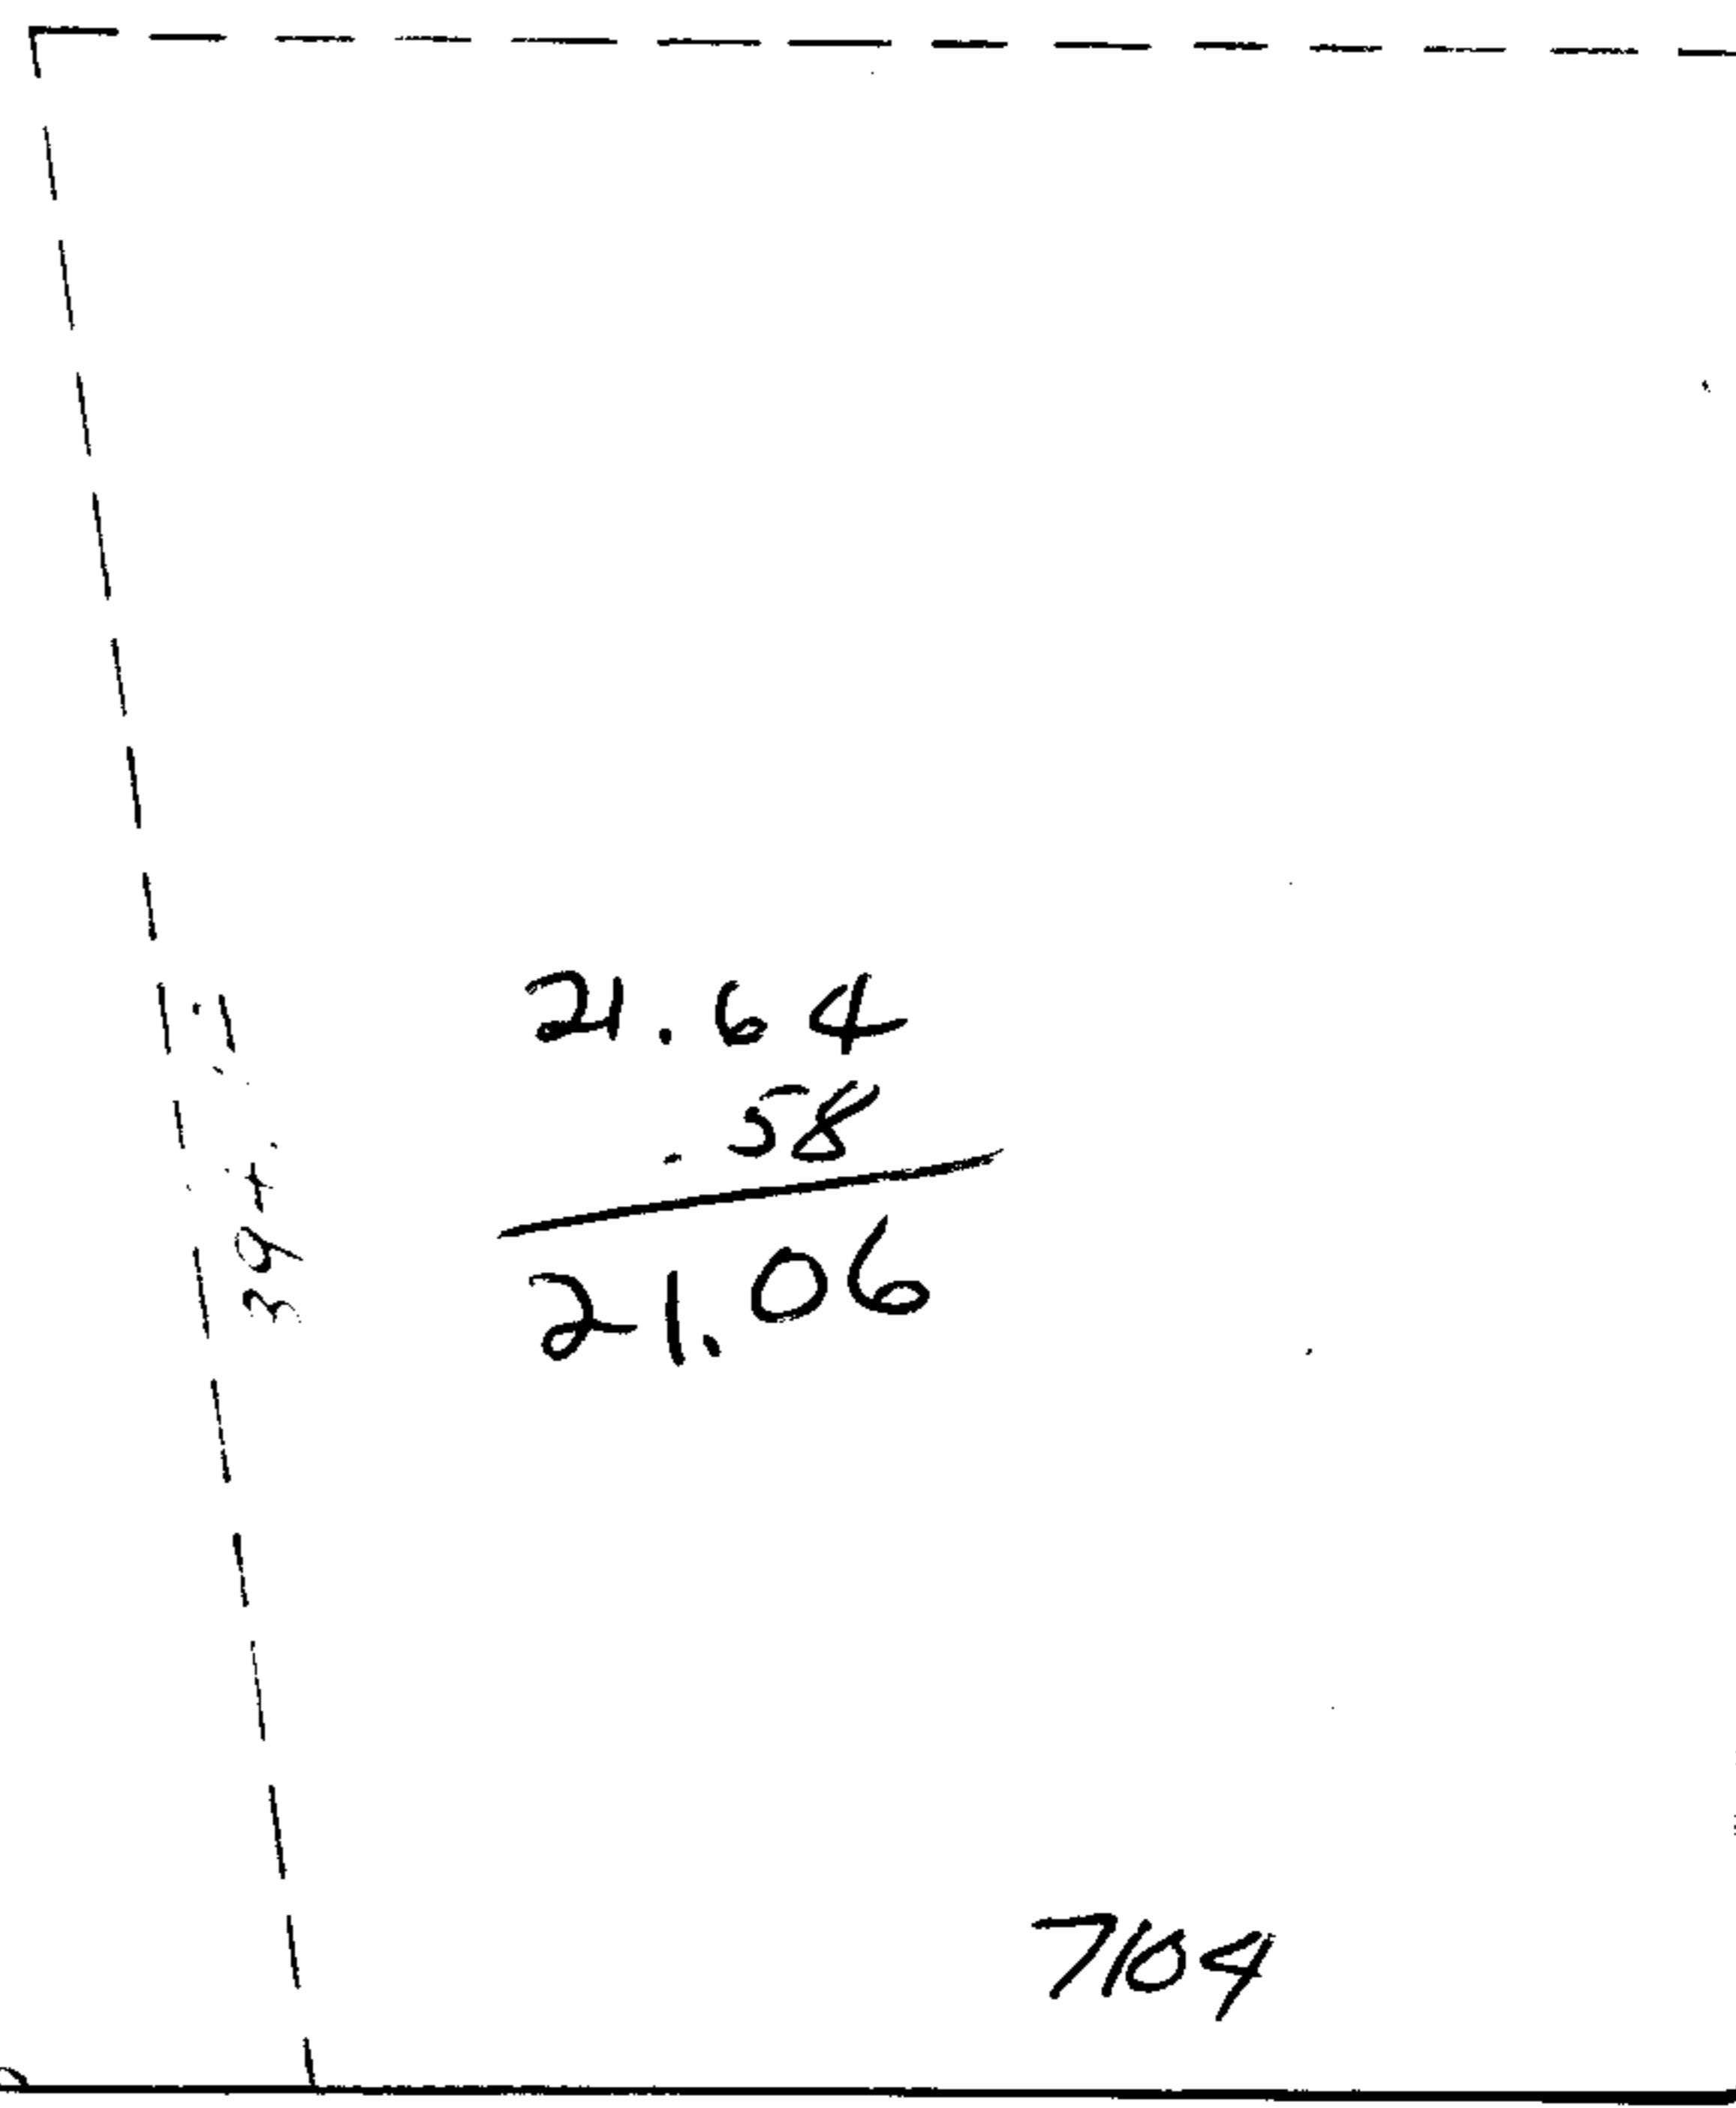

7104