

7109
1/2

2580

Pt. -012

Pt 29.20 Ac.

60

RD.

7109


APPROVED
LORAIN CO.
MAP DEPT.
DATE 6-20-73
3-00-016-B
BY <i>[Signature]</i>

OK


[Signature]

~~Pt. 44.99 A.~~


-013
15.79 Ac.

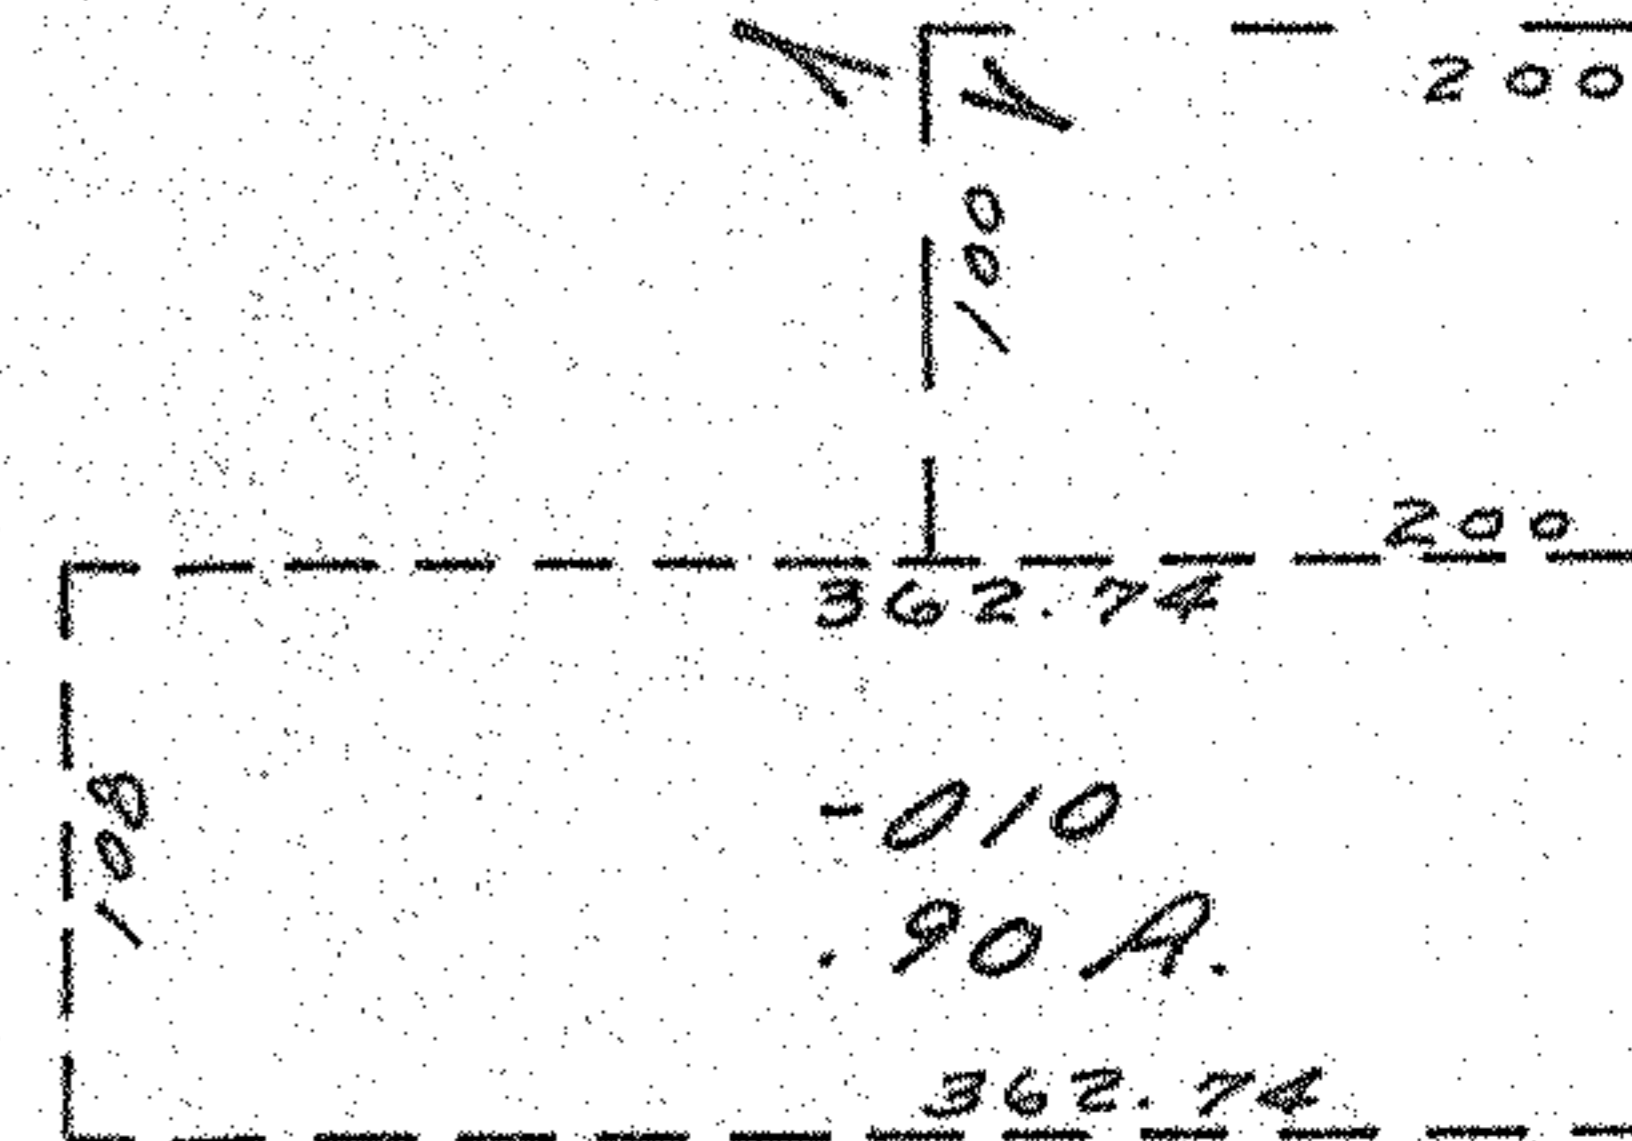

44.99
29.20
15.79

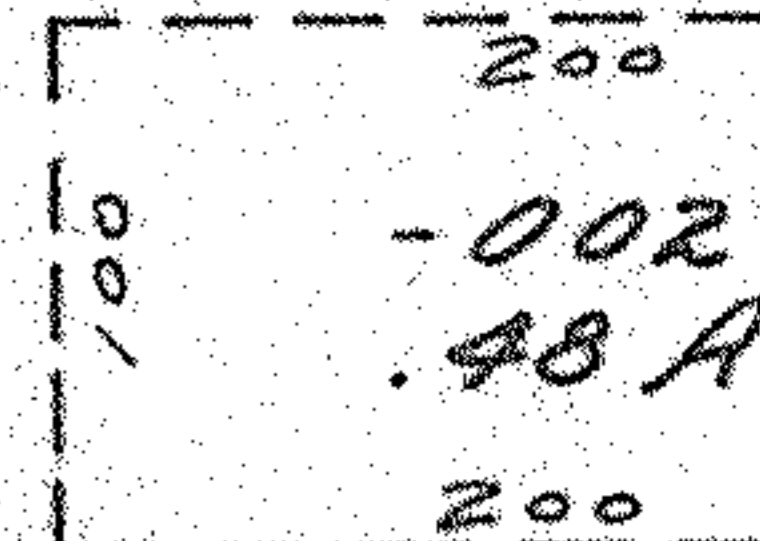

-003
3.63 A.

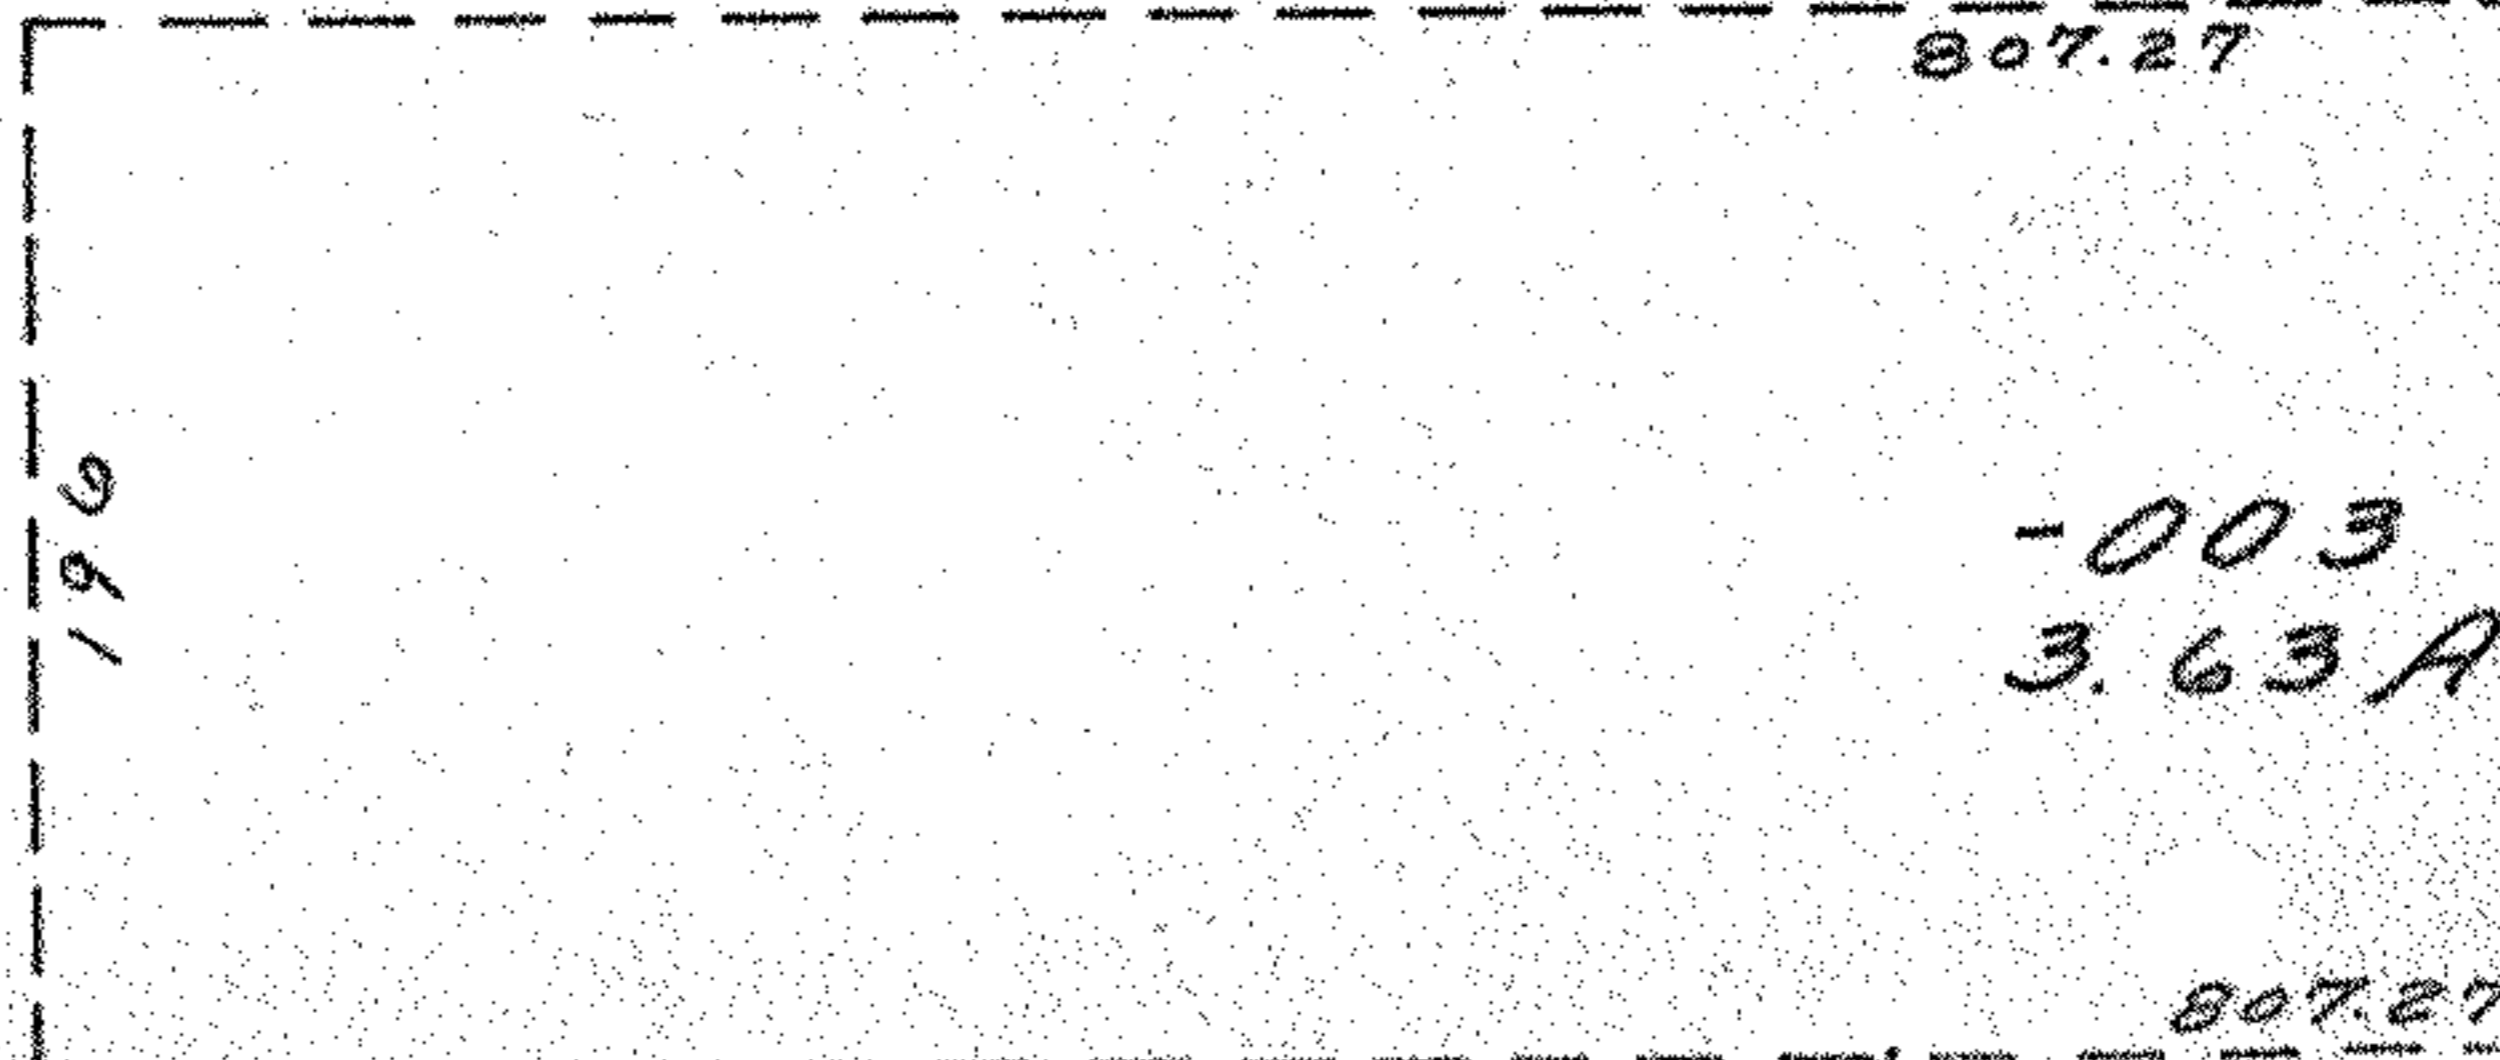

100

100

156

100

196

792

1410