



AUGUSTA

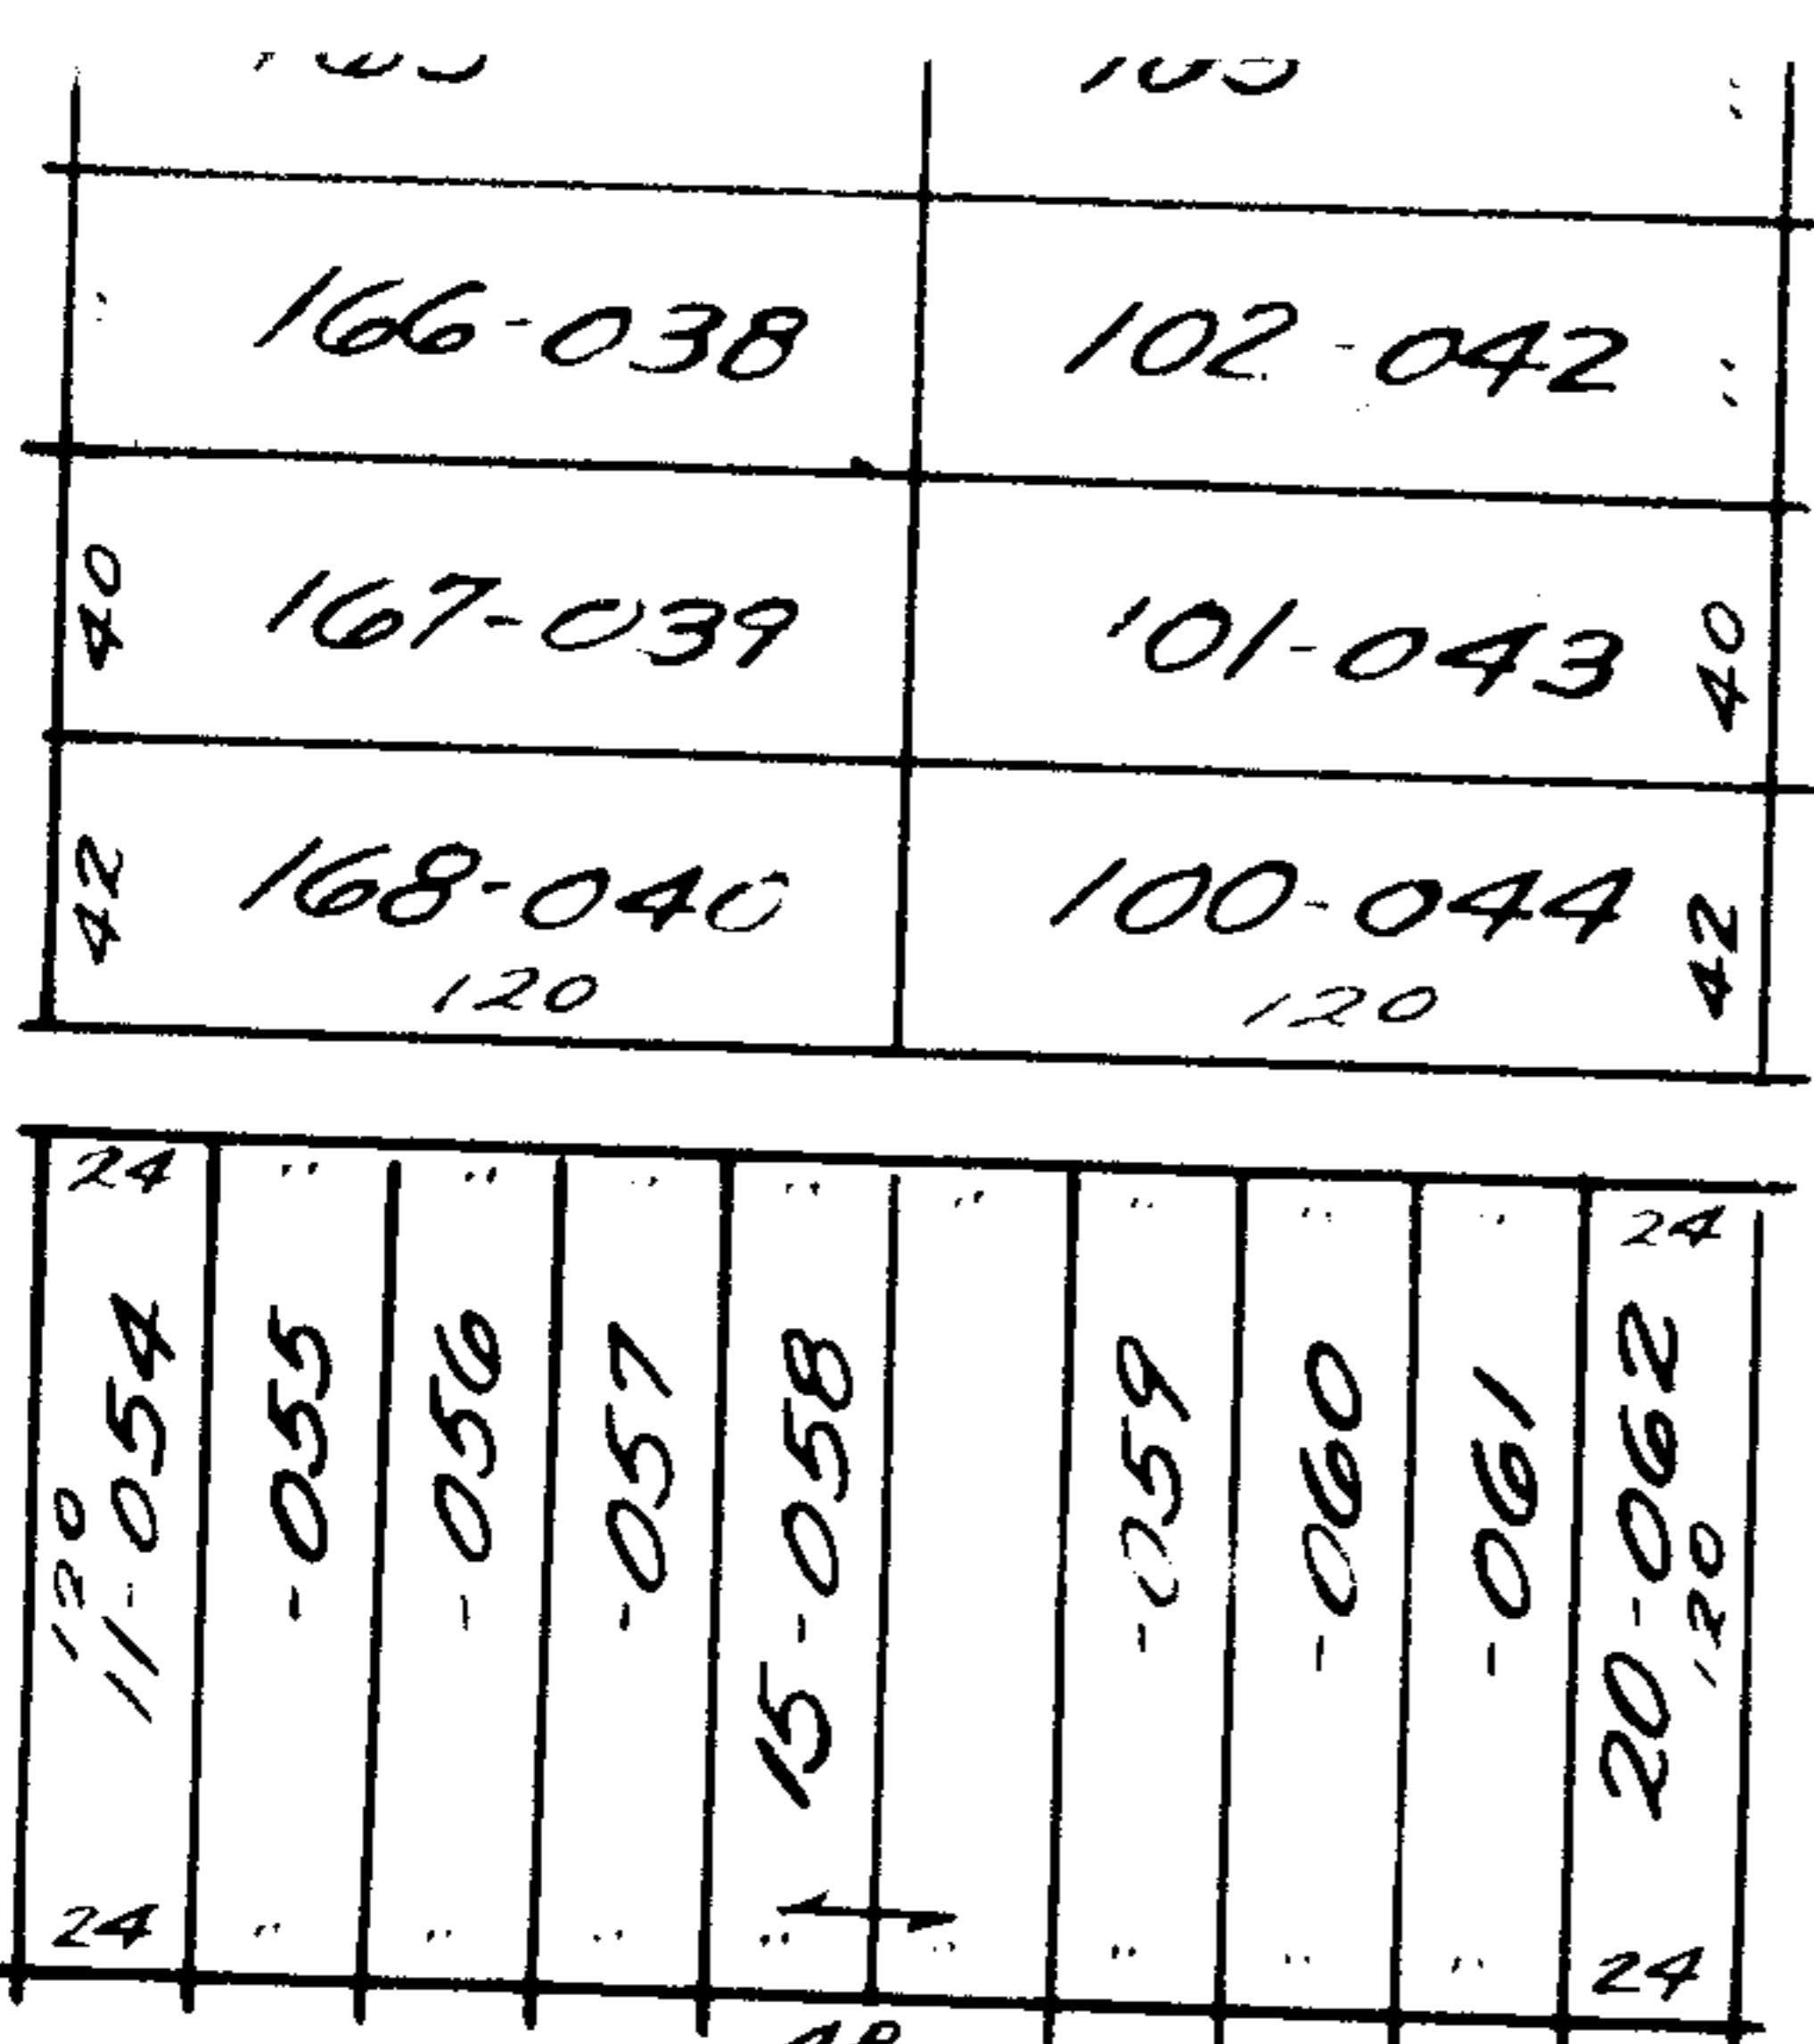


KANSAS

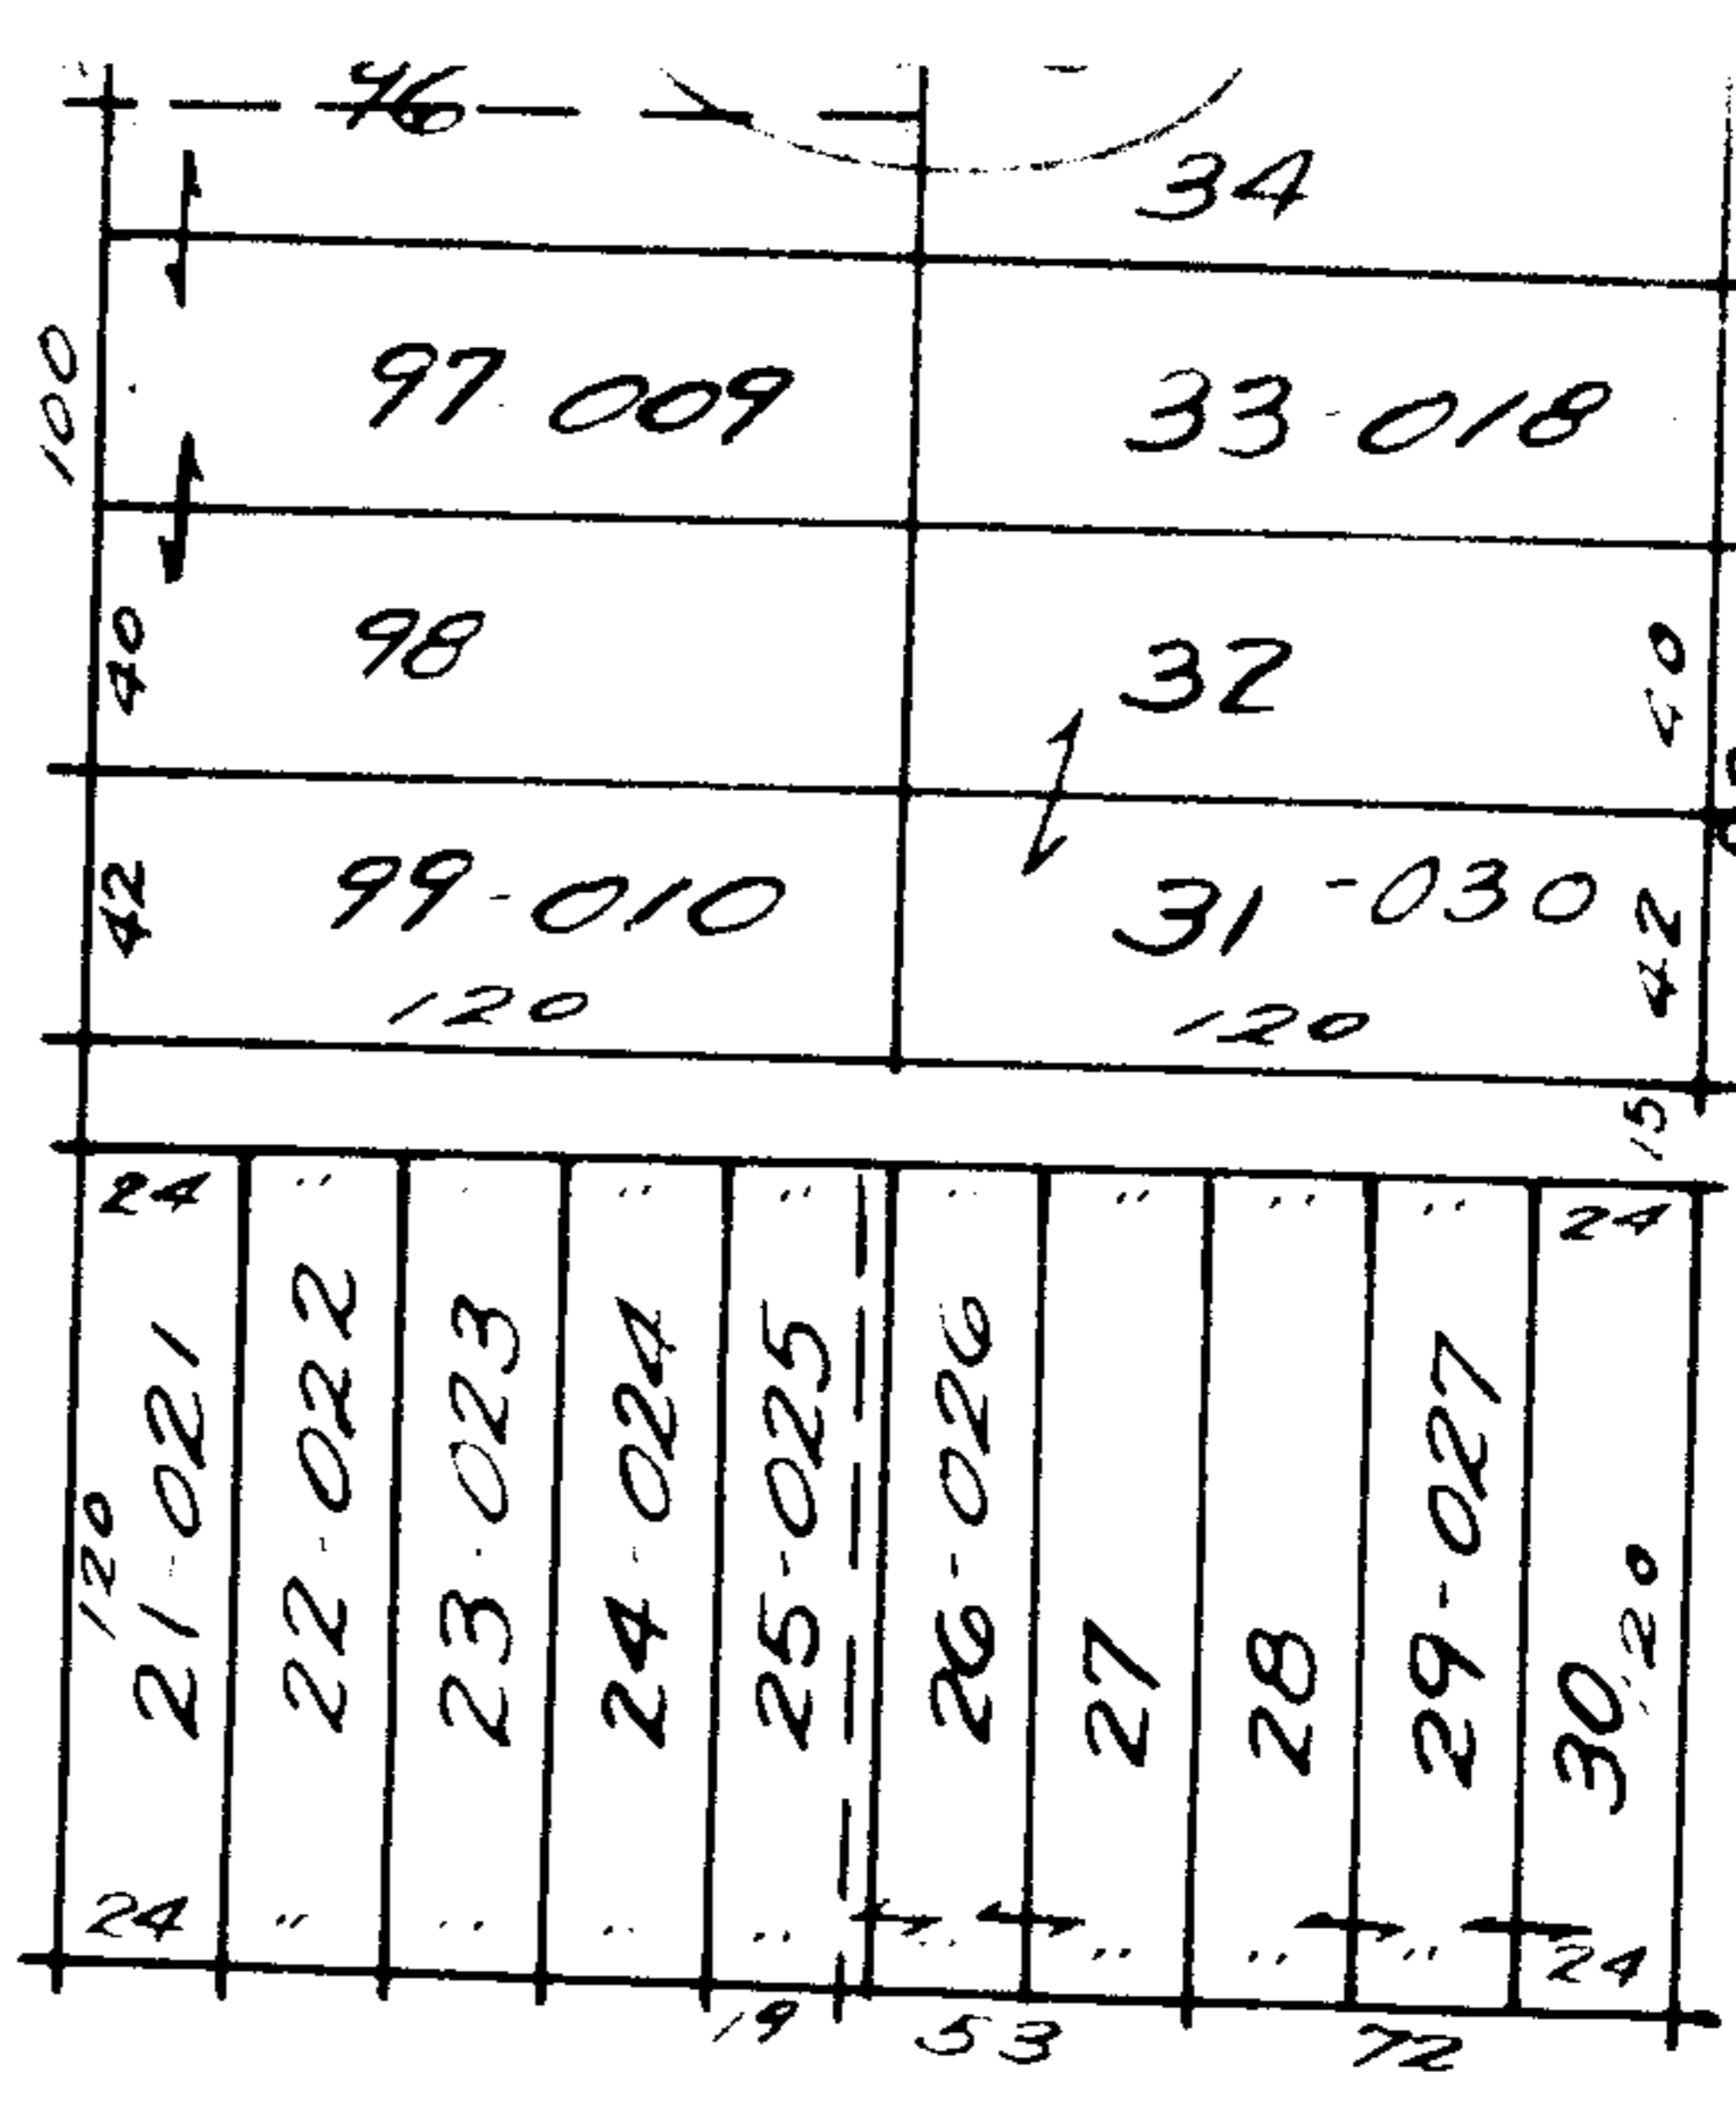

7118

LEHIGH


SEE 3-00-053-A

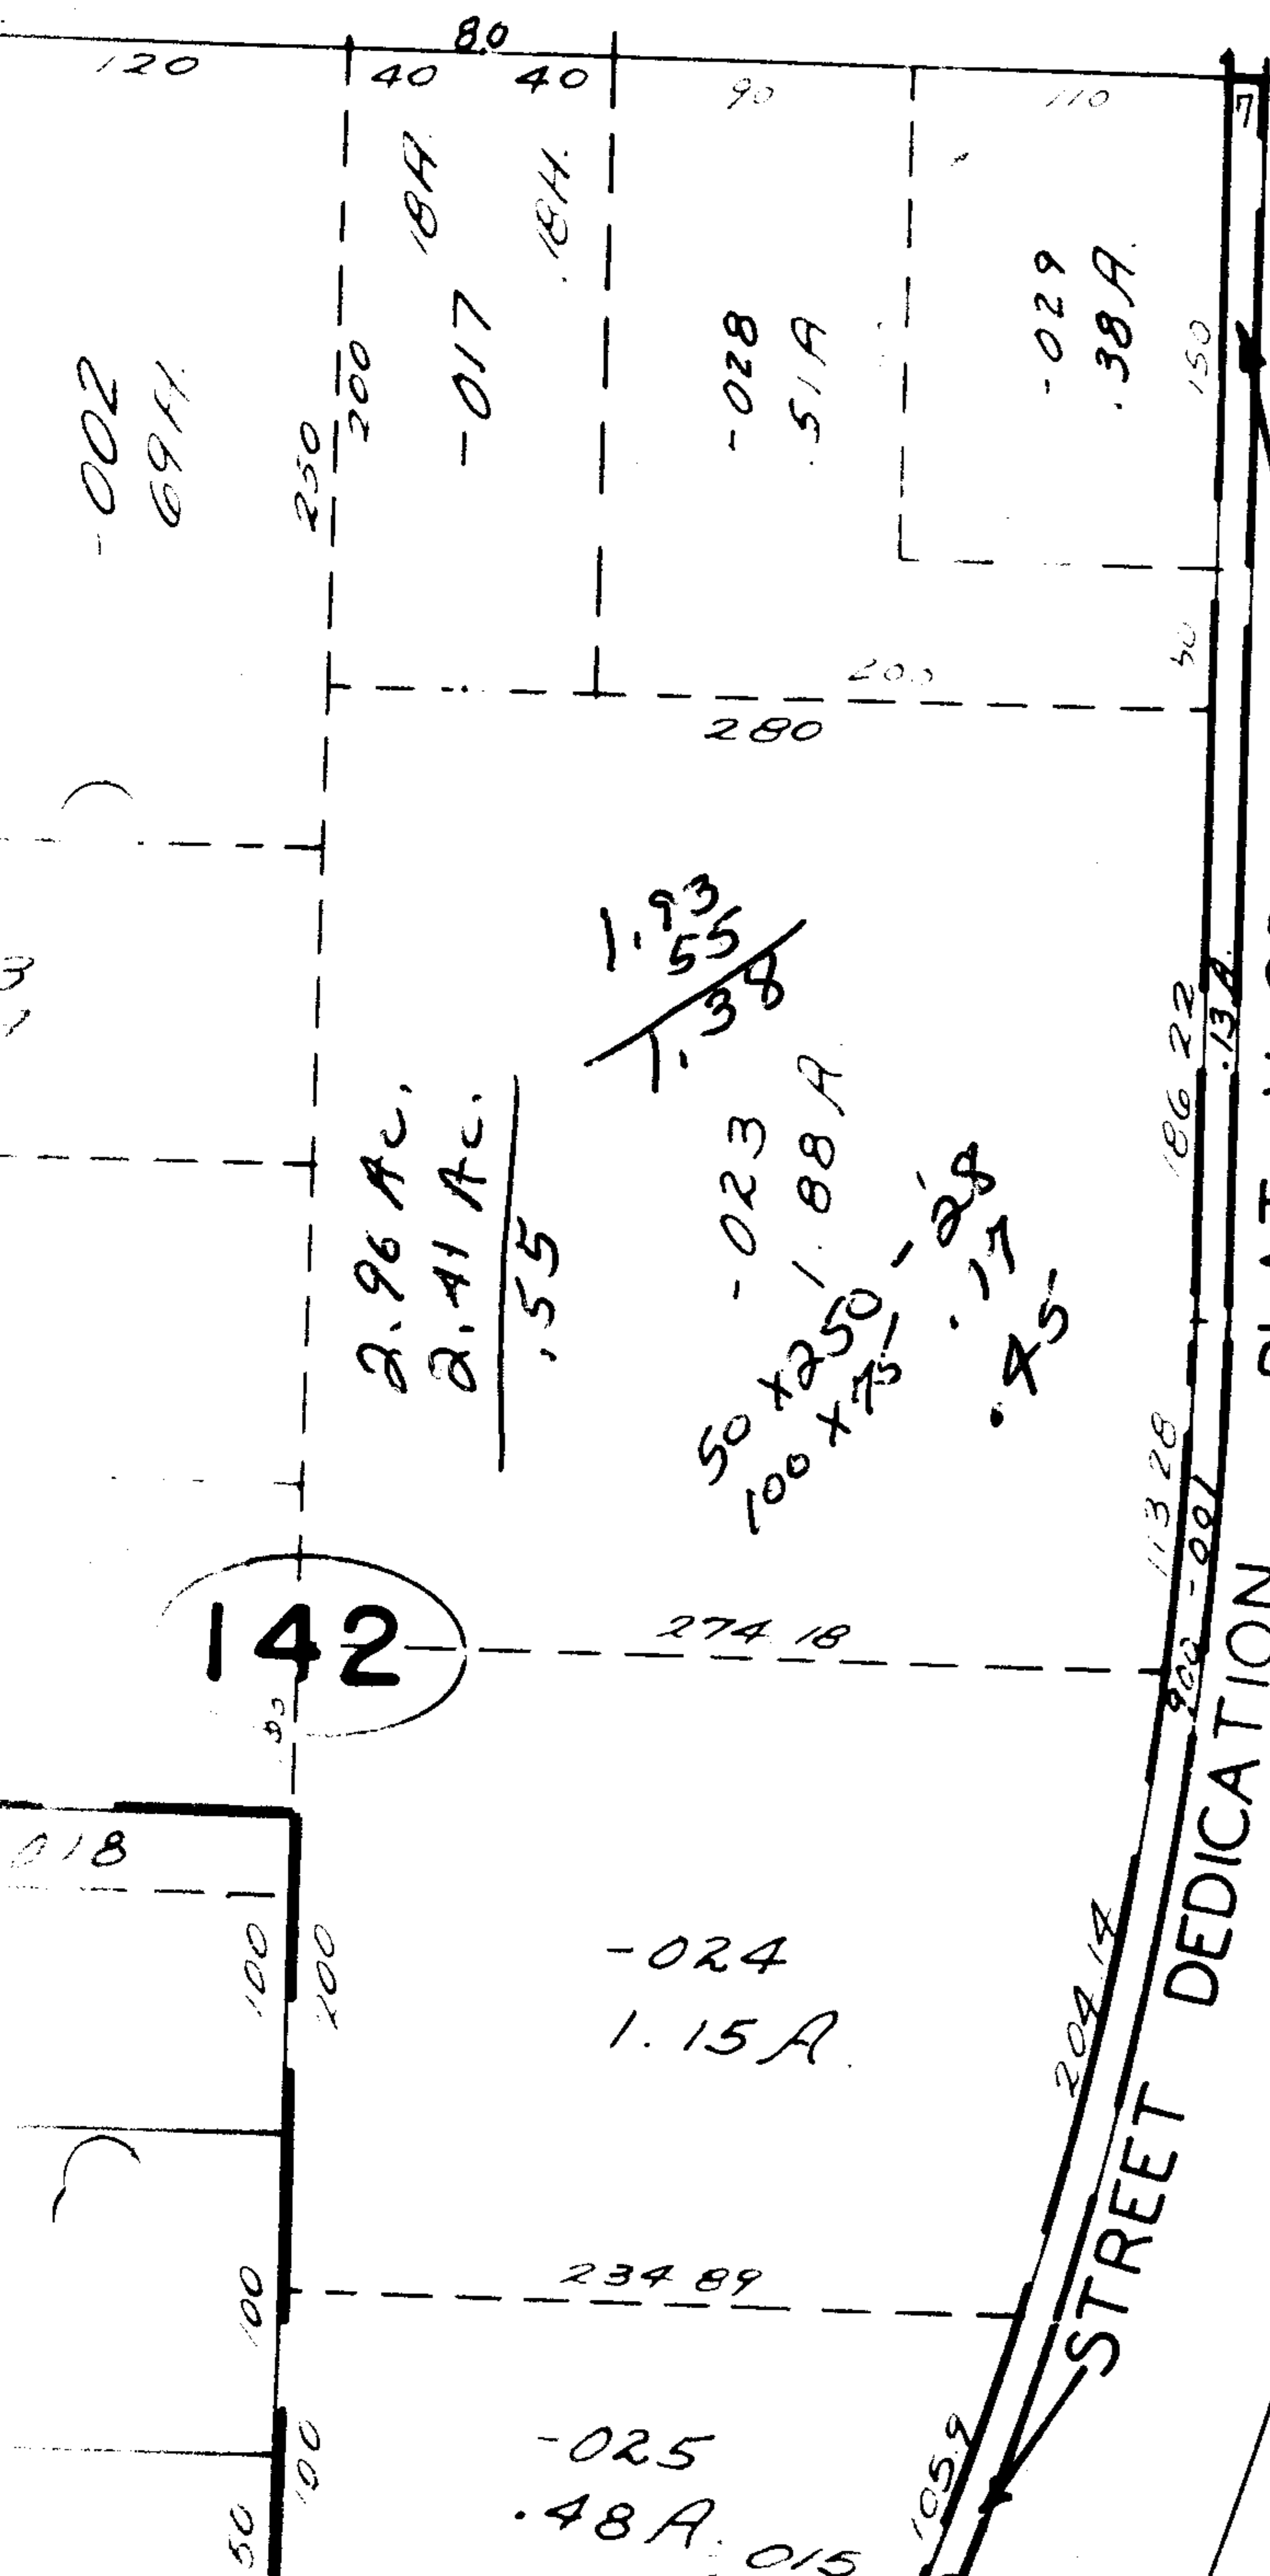

DR.

PLAT V. 25 P. 81

STREET DEDICATION

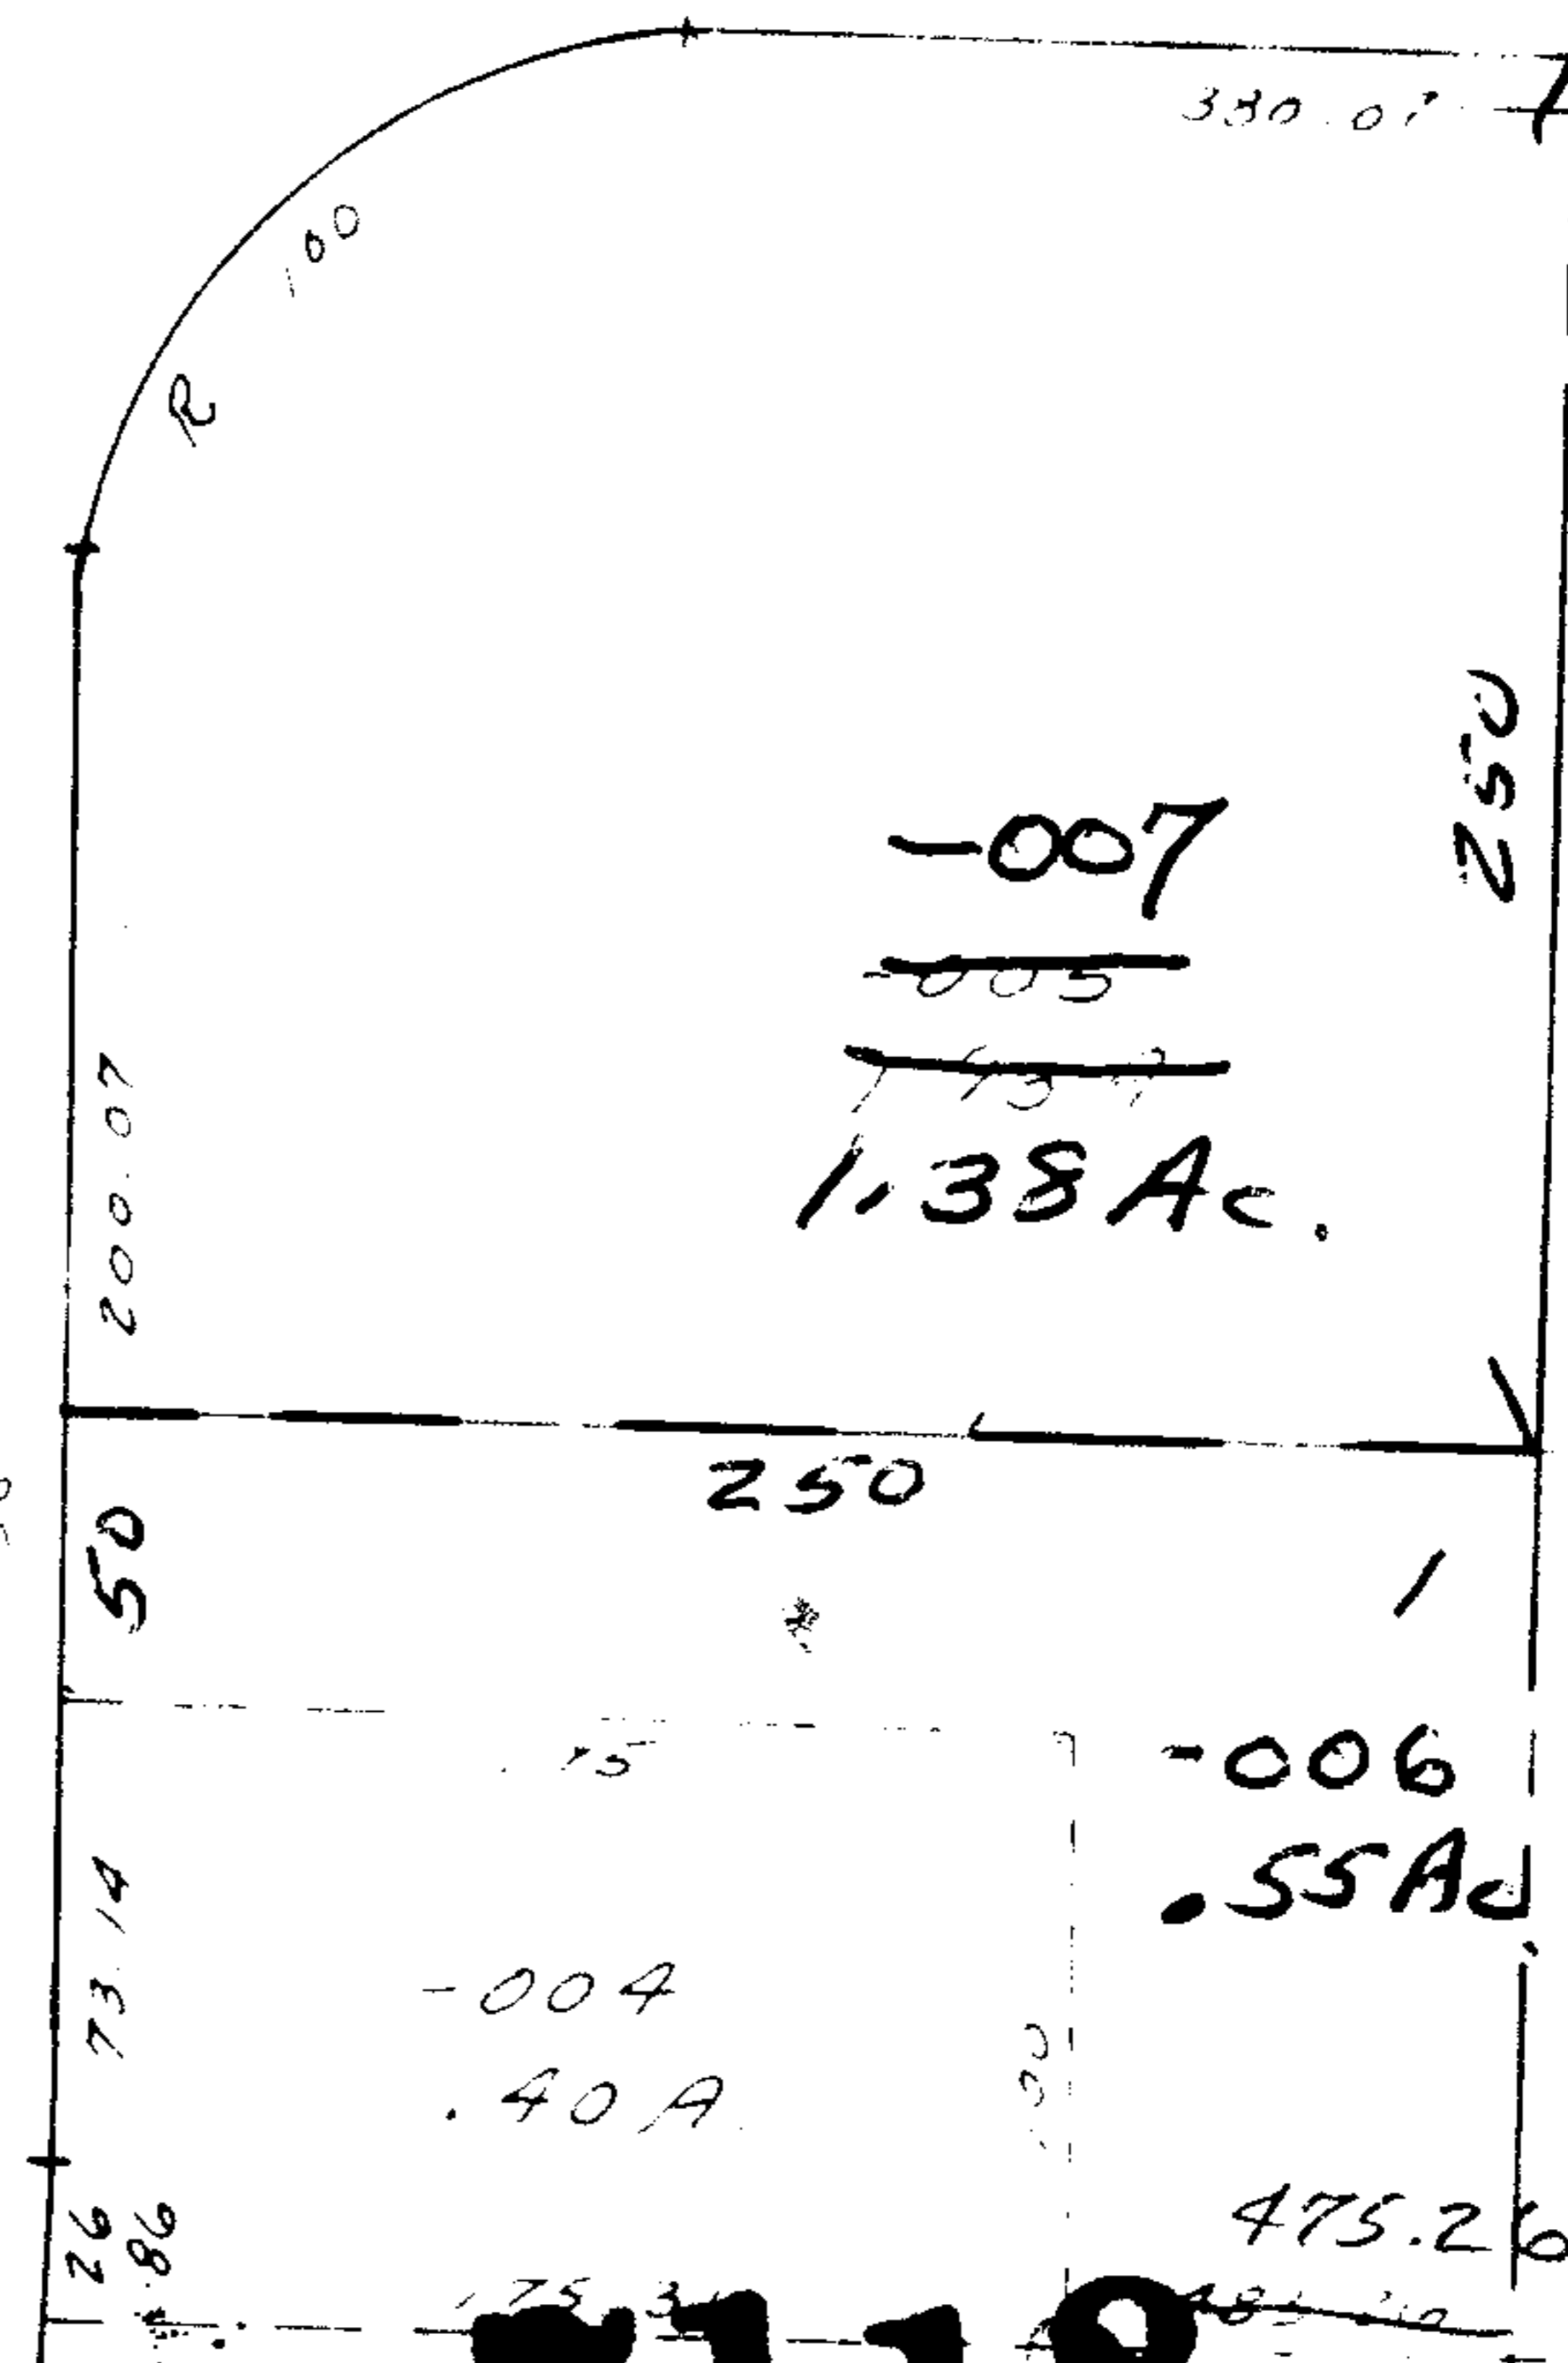

7118

APPROVED
LORAIN CO.
MAP DEPT.
DATE 6-22-73
200-051-B
BY *[Signature]*

OK

[Handwritten signature]
K