


7124

NO

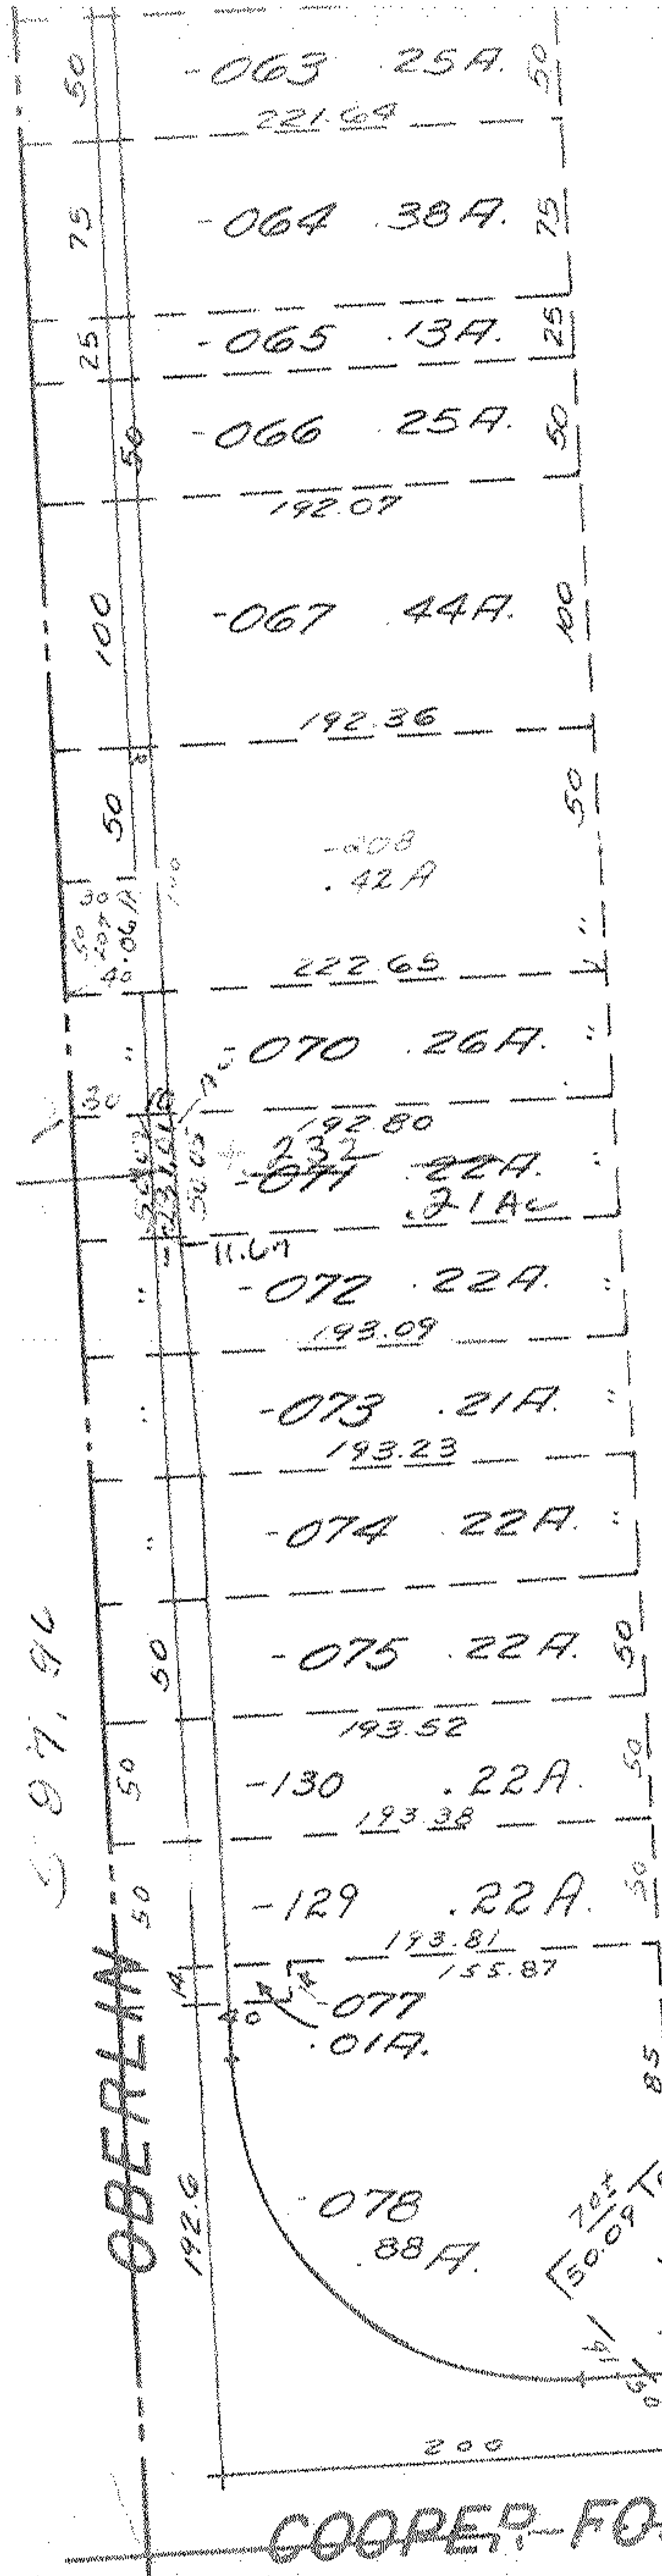

7124  
 APPROVED  
 LORAIN CO.  
 MAP DEPT.  
 DATE 7-9-73  
 2-01-008B  
 BY L.W. Hall

S. S. 8-13-887  
 7.80 A.

*PRJ*

01 AC

597.96

OBERLIN

COOPER FOSTER PARK

222.06