

7125


ppd

OK

7125

APPROVED
LORAIN CO
MAP DEPT.
DATE <u>7-10-73</u>
<u>2-02-005B</u>
BY <u>L W Hall</u>

\$ 8-13-86

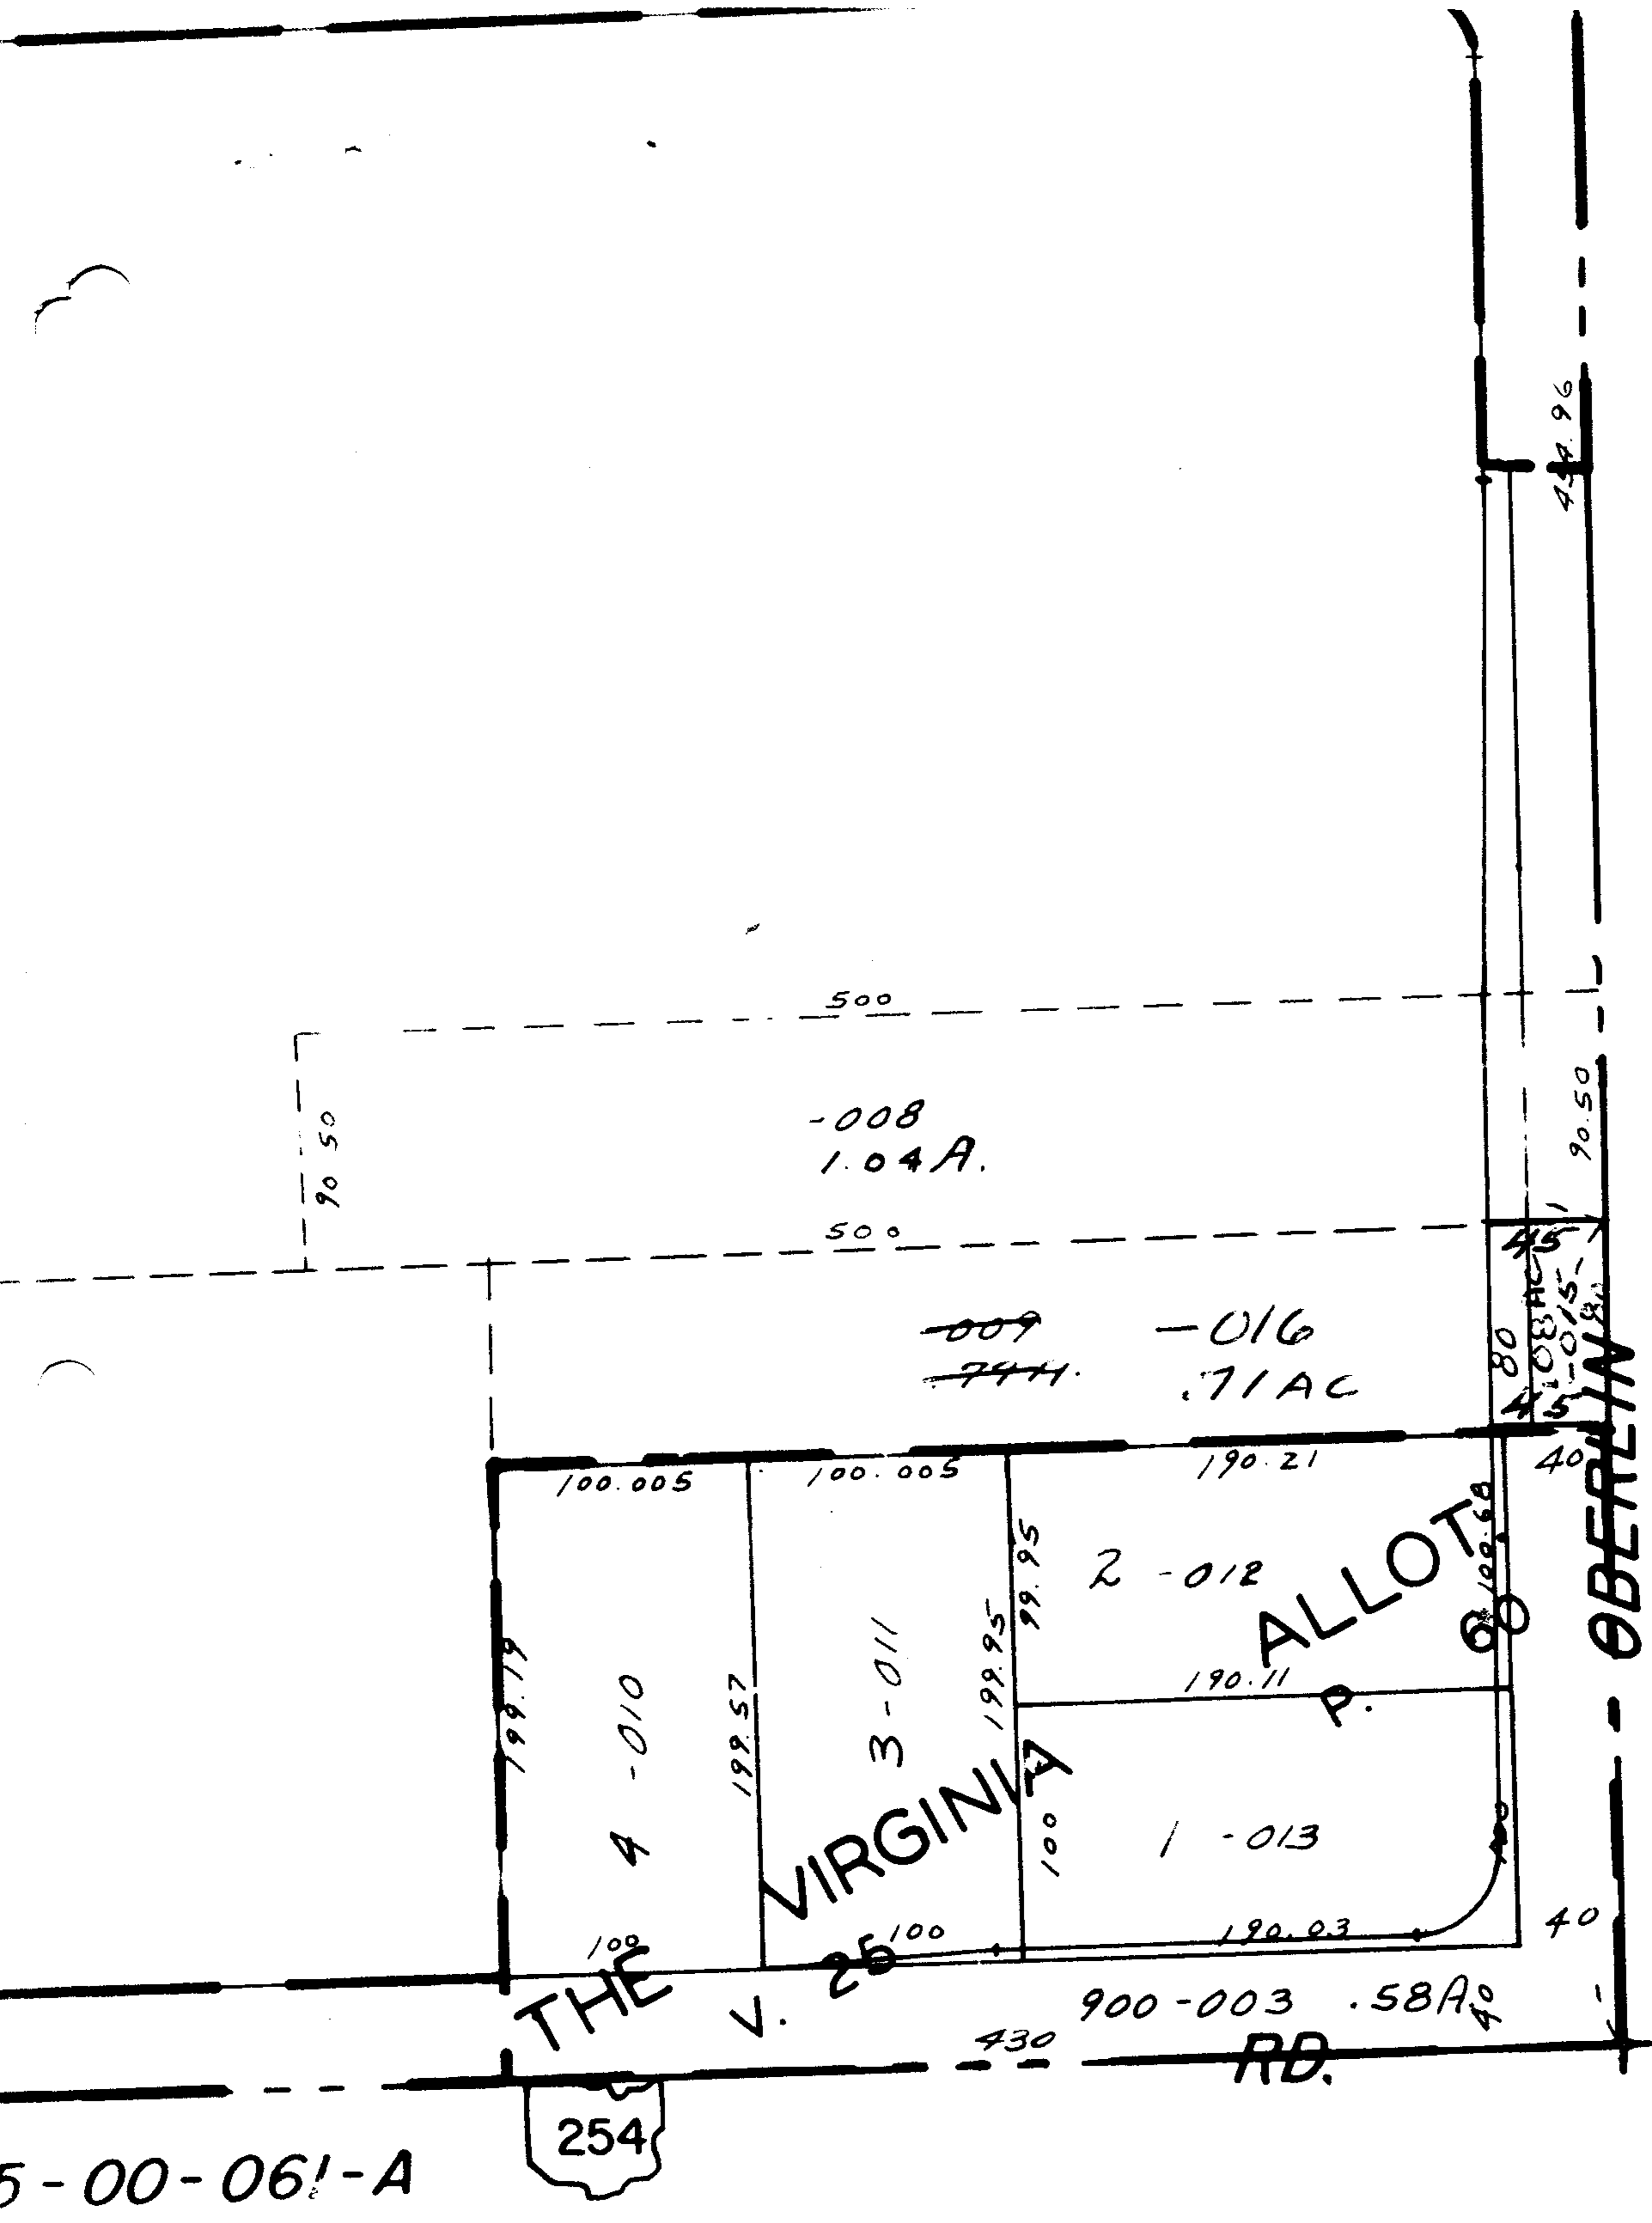

5-00-061-A



/P

TRACT 2 E. PT. LOT 5