

7137

R.D.
40

129.35
103°45'

894.96

-009
1.35 A.

260
174.05

270
300

-015
~~012~~
50 A.

0.63 A.C.

-002
1.03 A.

300 426.93


82.60

OK
7137

APPROVED
LOBAIN CO.
MAP DEPT.
DATE 6-27-13
6-110
BY <i>[Signature]</i>

-014
~~011~~
3.97 A.
3.84 A.C.

459.20

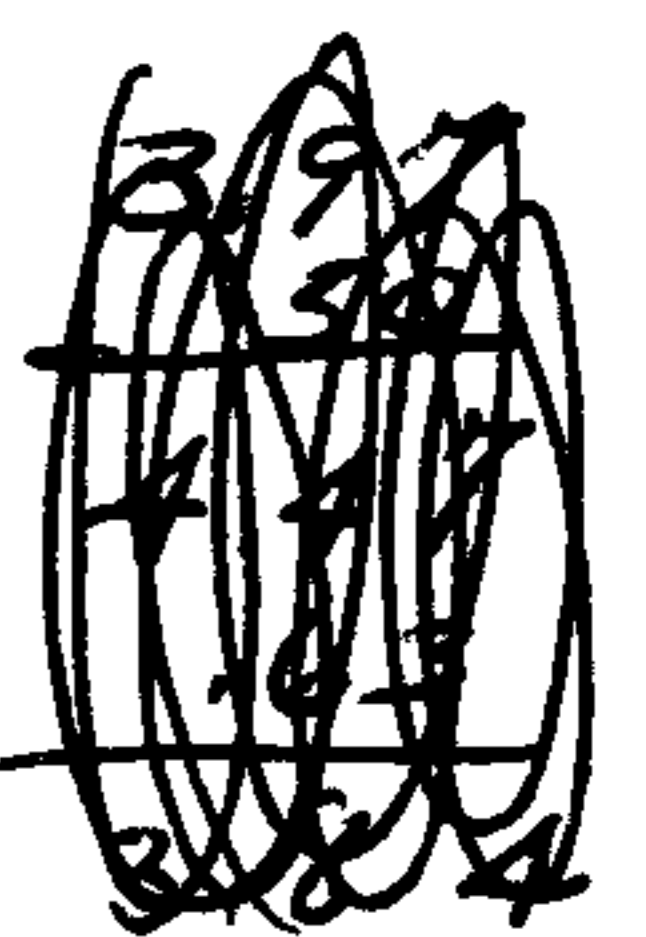

Pt. -051
Pt. 1.51 A.

Pt. -052
Pt. 1.60 A.

Pt. -053
Pt. 1.50 A.

100

103°45'

384.48

440

3