


7141

COTTON

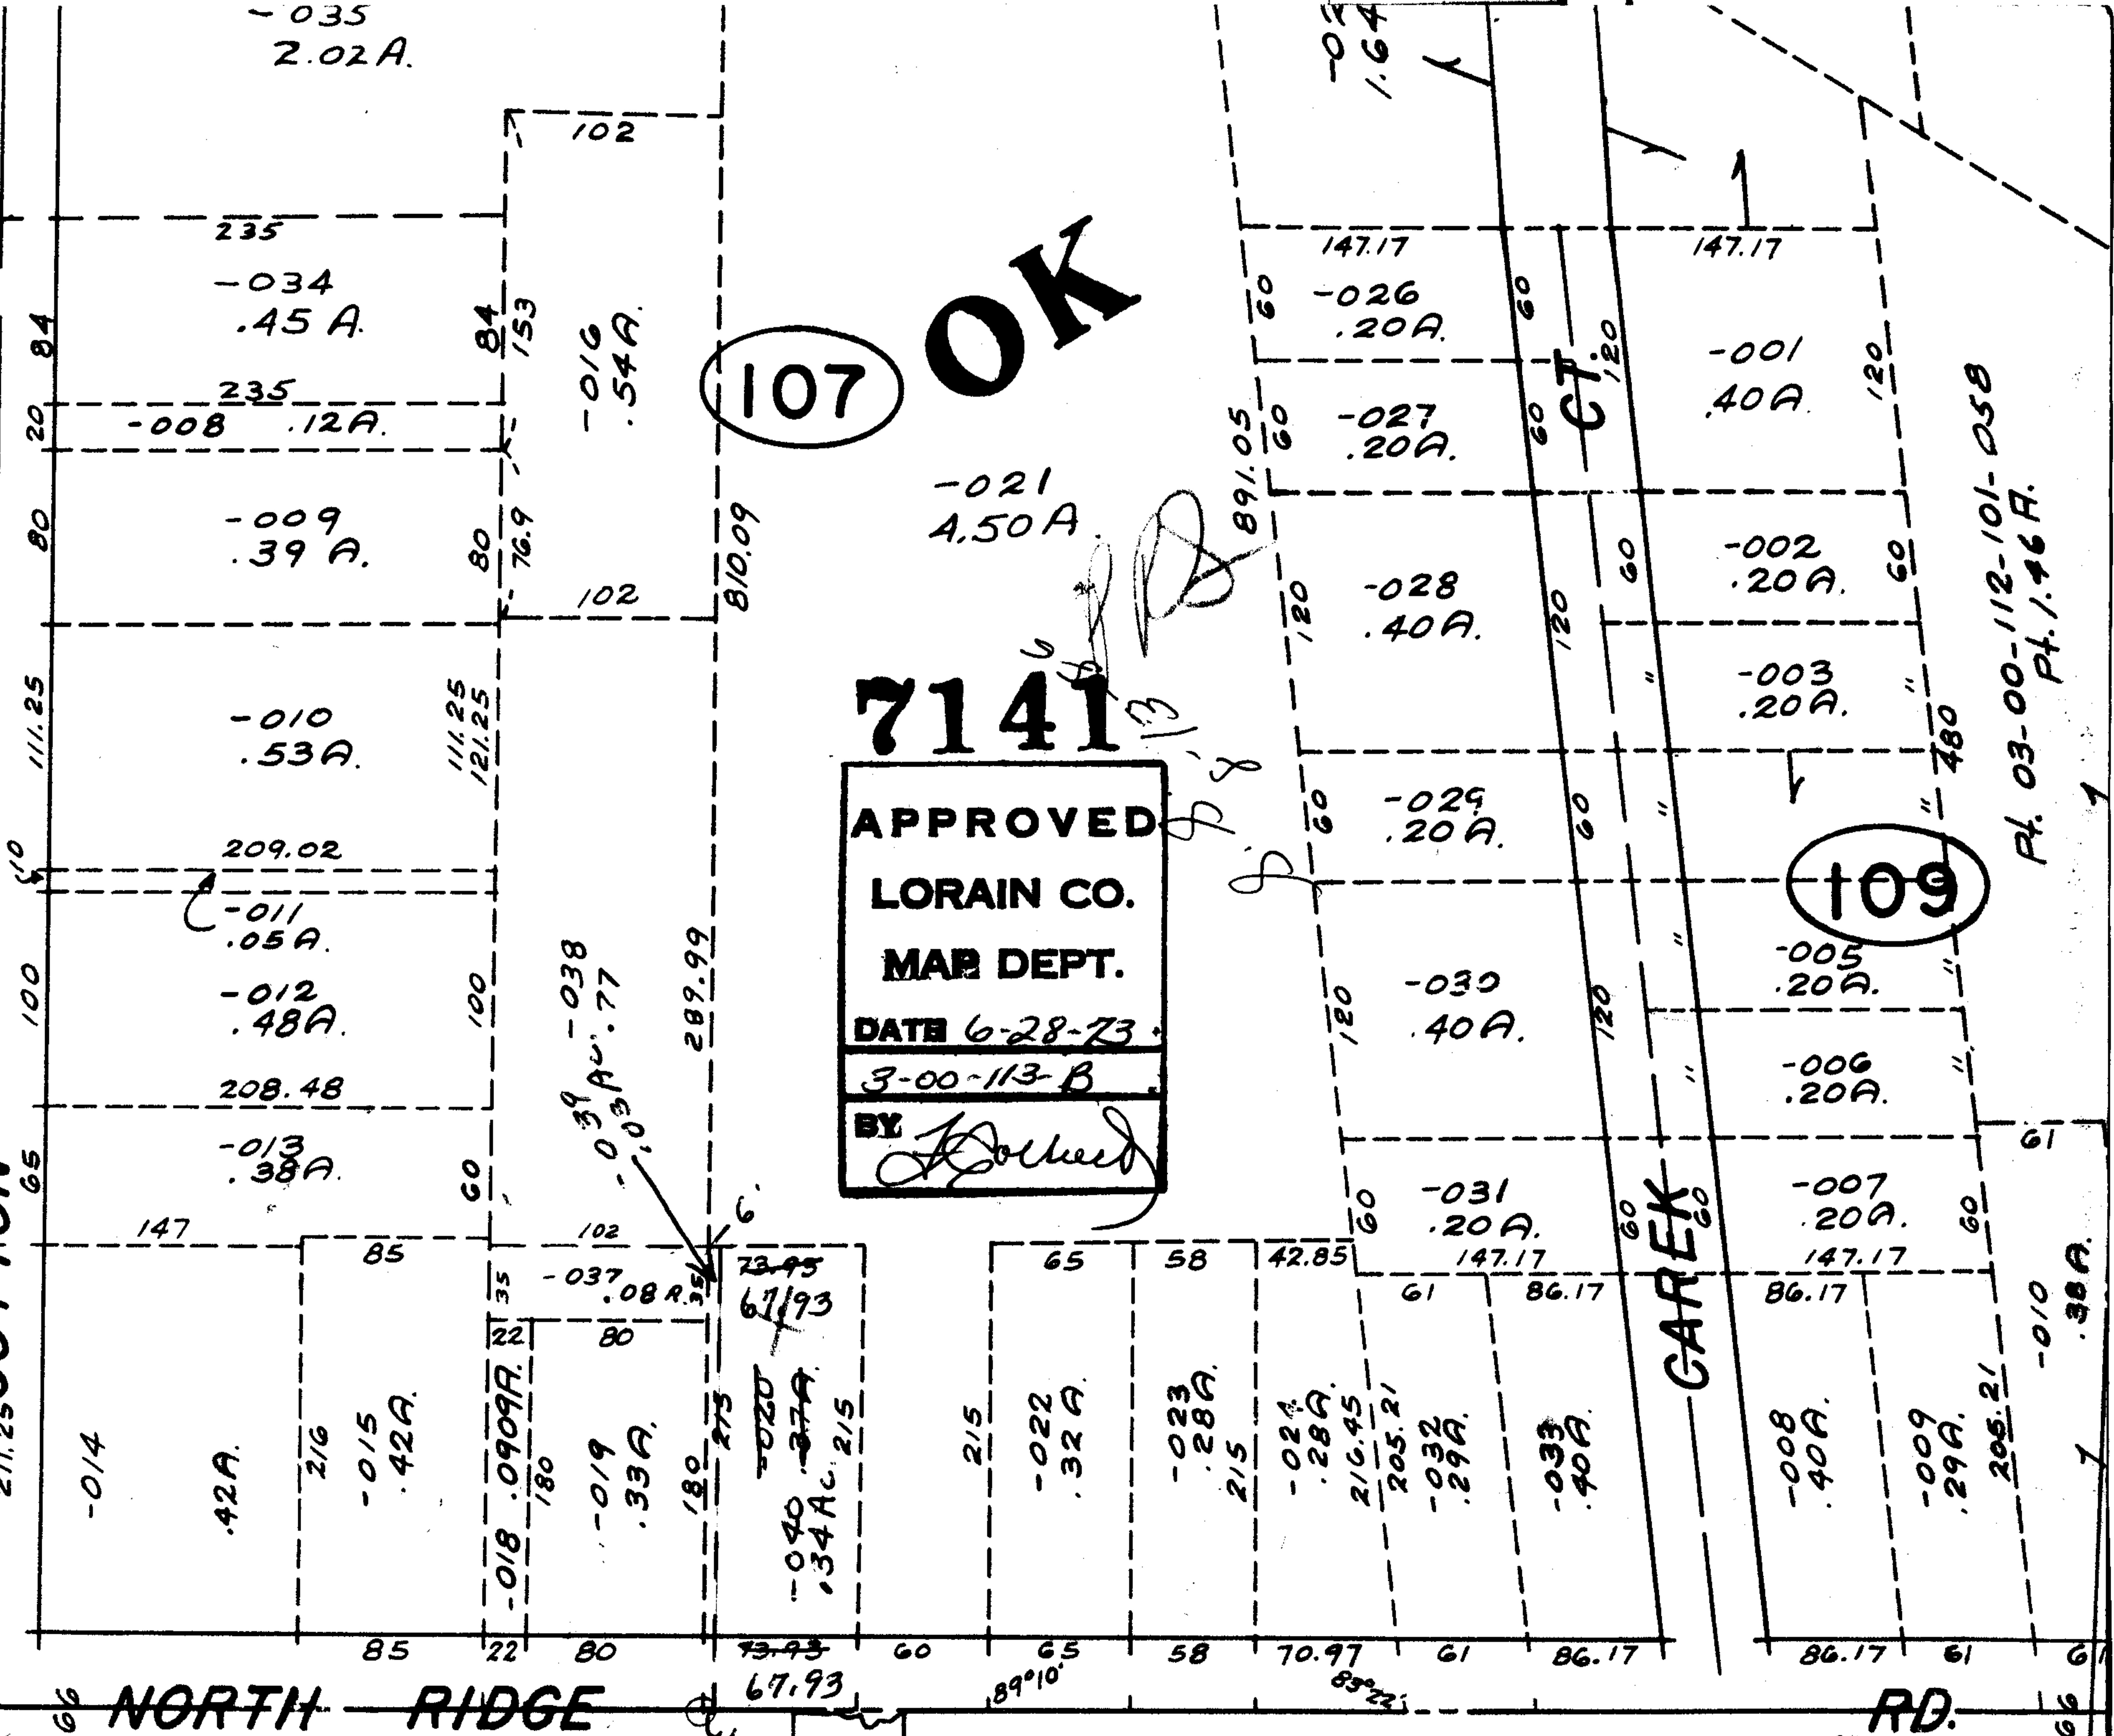

107

OK

7141

APPROVED
 LORAIN CO.
 MAR DEPT.
 DATE 6-28-73
 3-00-113-B
 BY *[Signature]*

109

Pl. 03-00-112-101-05B
Pt. 1.46 A.

NORTH RIDGE

RD.

254

SEE 6-2