


7159

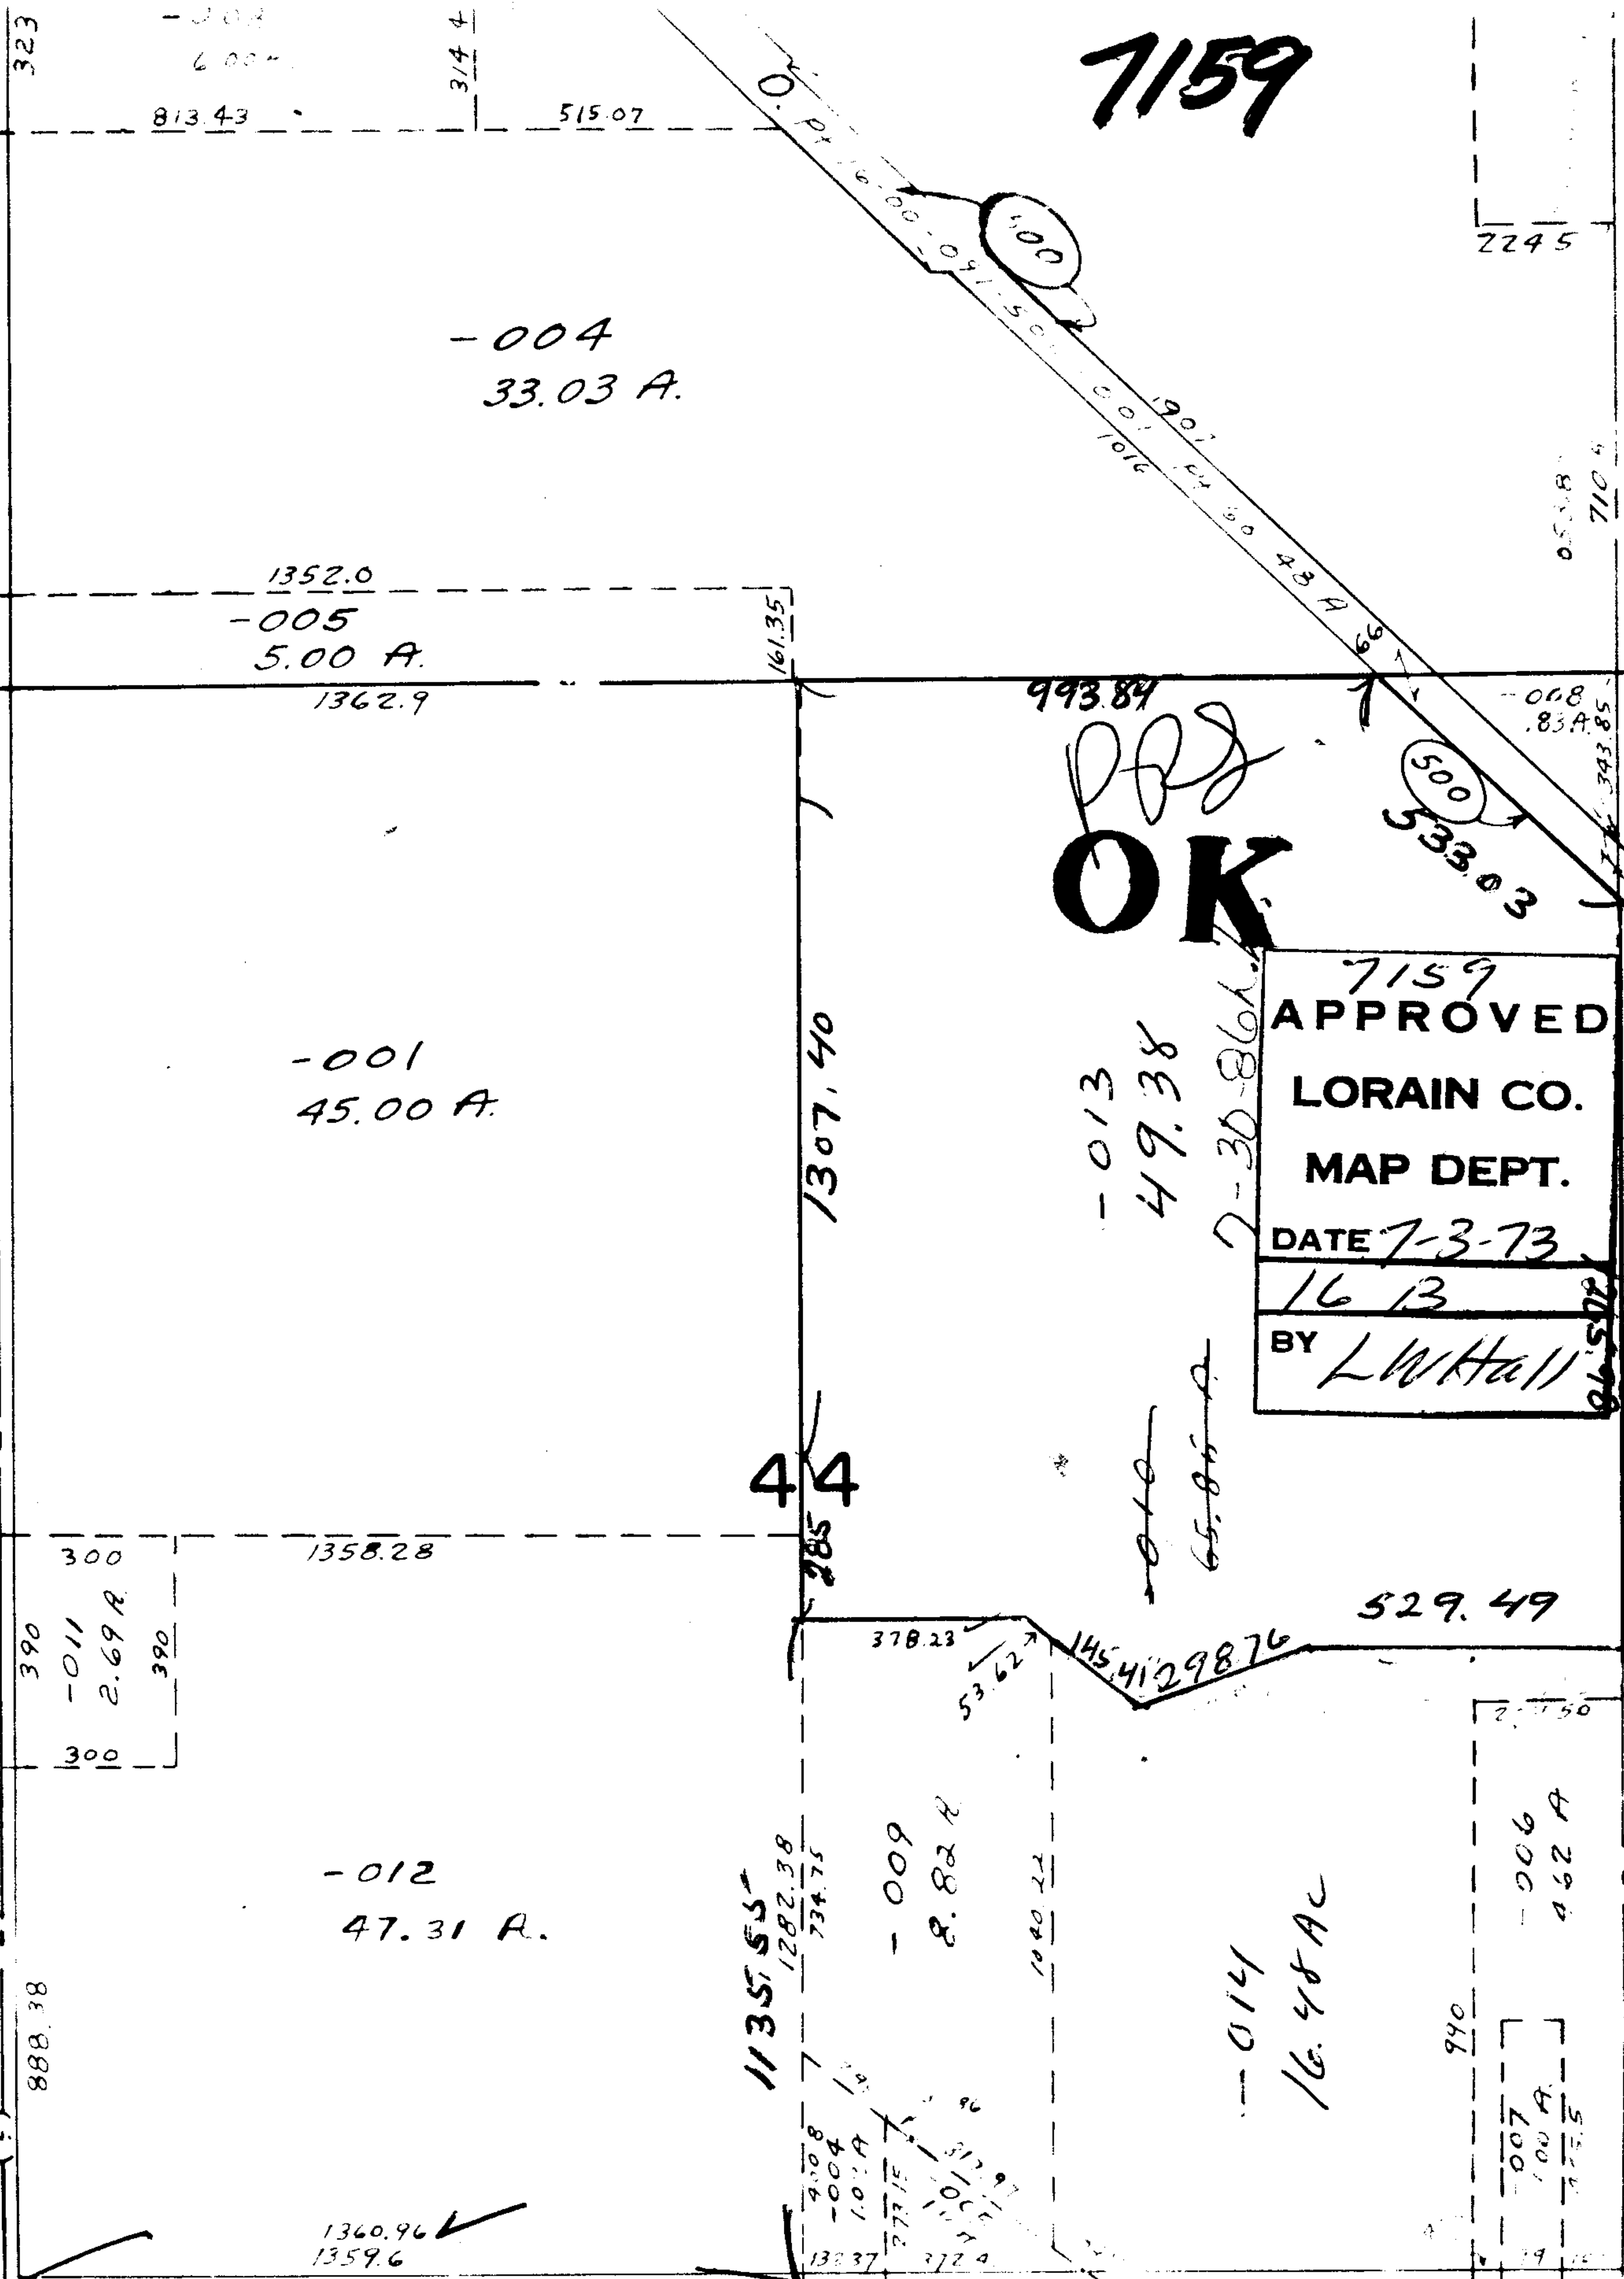

7159  
 APPROVED  
 LORAIN CO.  
 MAP DEPT.  
 DATE 7-3-73  
 16 13  
 BY L.W. Hall

MENNELL

WAKEMAN - LAGRANGE - RICHFIELD

GRAFTON TWP.

SCALE: 1" = 400'

LOTS

303

(603)

0.538  
710.5

2245

-004  
33.03 A.

1352.0  
-005  
5.00 A.

1362.9

-001  
45.00 A.

1307.40

993.84

OK

-013  
49.38

7-30-86

DATE 7-3-73

16 13

BY L.W. Hall

44

390  
 -011  
 2.69 A.  
 390

1358.28

-012  
47.31 A.

1135.55

-009  
8.82 A.

-014  
16.48 AC

-006  
4.62 A.

-007  
1.00 A.

1360.96  
1359.6

9.08  
 -004  
 1.00 A.  
 277.15  
 101.51  
 277.9

990

277.50

145.41  
298.76

529.49

378.23  
53.62

1040.22

813.43  
515.07

323

3/4 4

-003  
6.00 A.

-008  
8.85 A.

500  
533.83

0.538  
710.5