


7170

STOCKING

RD.

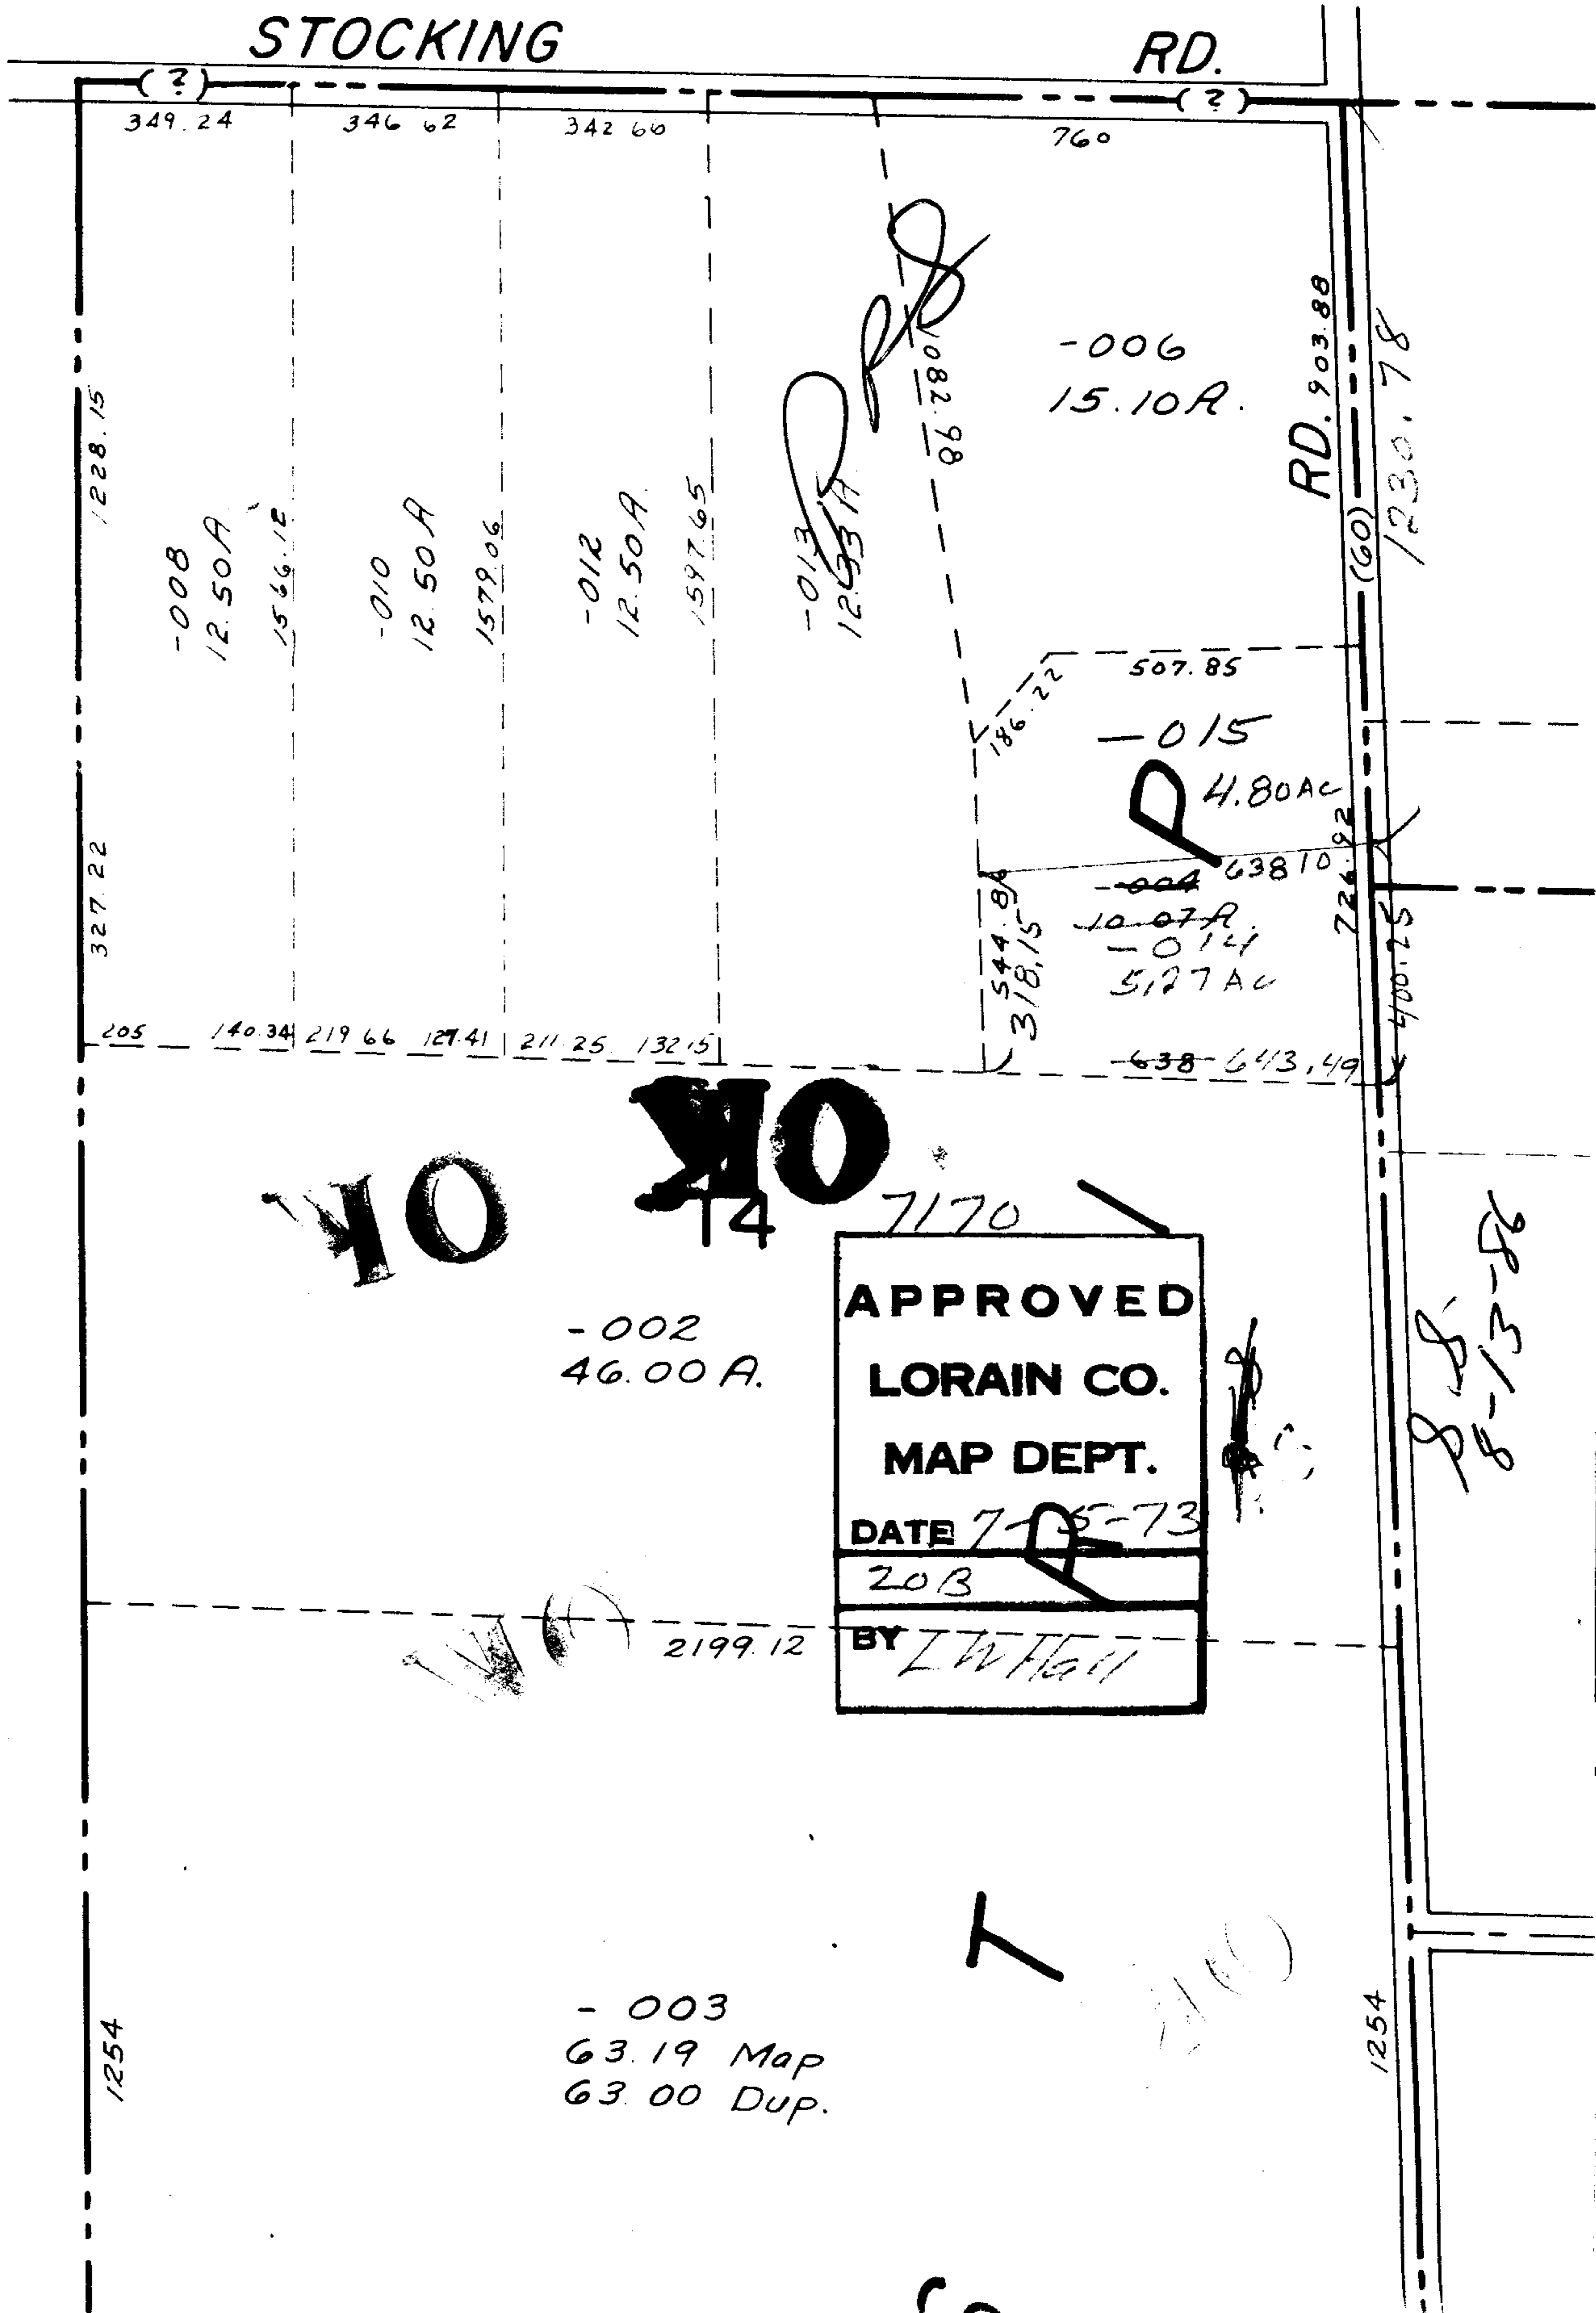

(?) 349.24 346.62 342.66 760 (?)

1228.15
327.22

-008
12.50 A
15.66.12

-010
12.50 A
15.79.06

-012
12.50 A
15.97.65

-013
12.93 A
1082.98
86.780

-006
15.10 A.

RD. 903.88

(60)
1230.78

507.85
-015
4.80 AC

544.84
318.15
186.22
638.10
10.07 A.
-014
5127 AC

205 140.34 219.66 127.41 211.25 132.15

224.92
400.25
638-643.49

NO
NO

-002
46.00 A.

7170

APPROVED

LORAIN CO.

MAP DEPT.

DATE 7-5-73

203

BY L.W. Hall

8-13-86

2199.12

-003
63.19 Map
63.00 Dup.

1254

1254

T