

7/179


SEE I-00-004-C

OK

7/79

(121)

SEE I-00-005-C

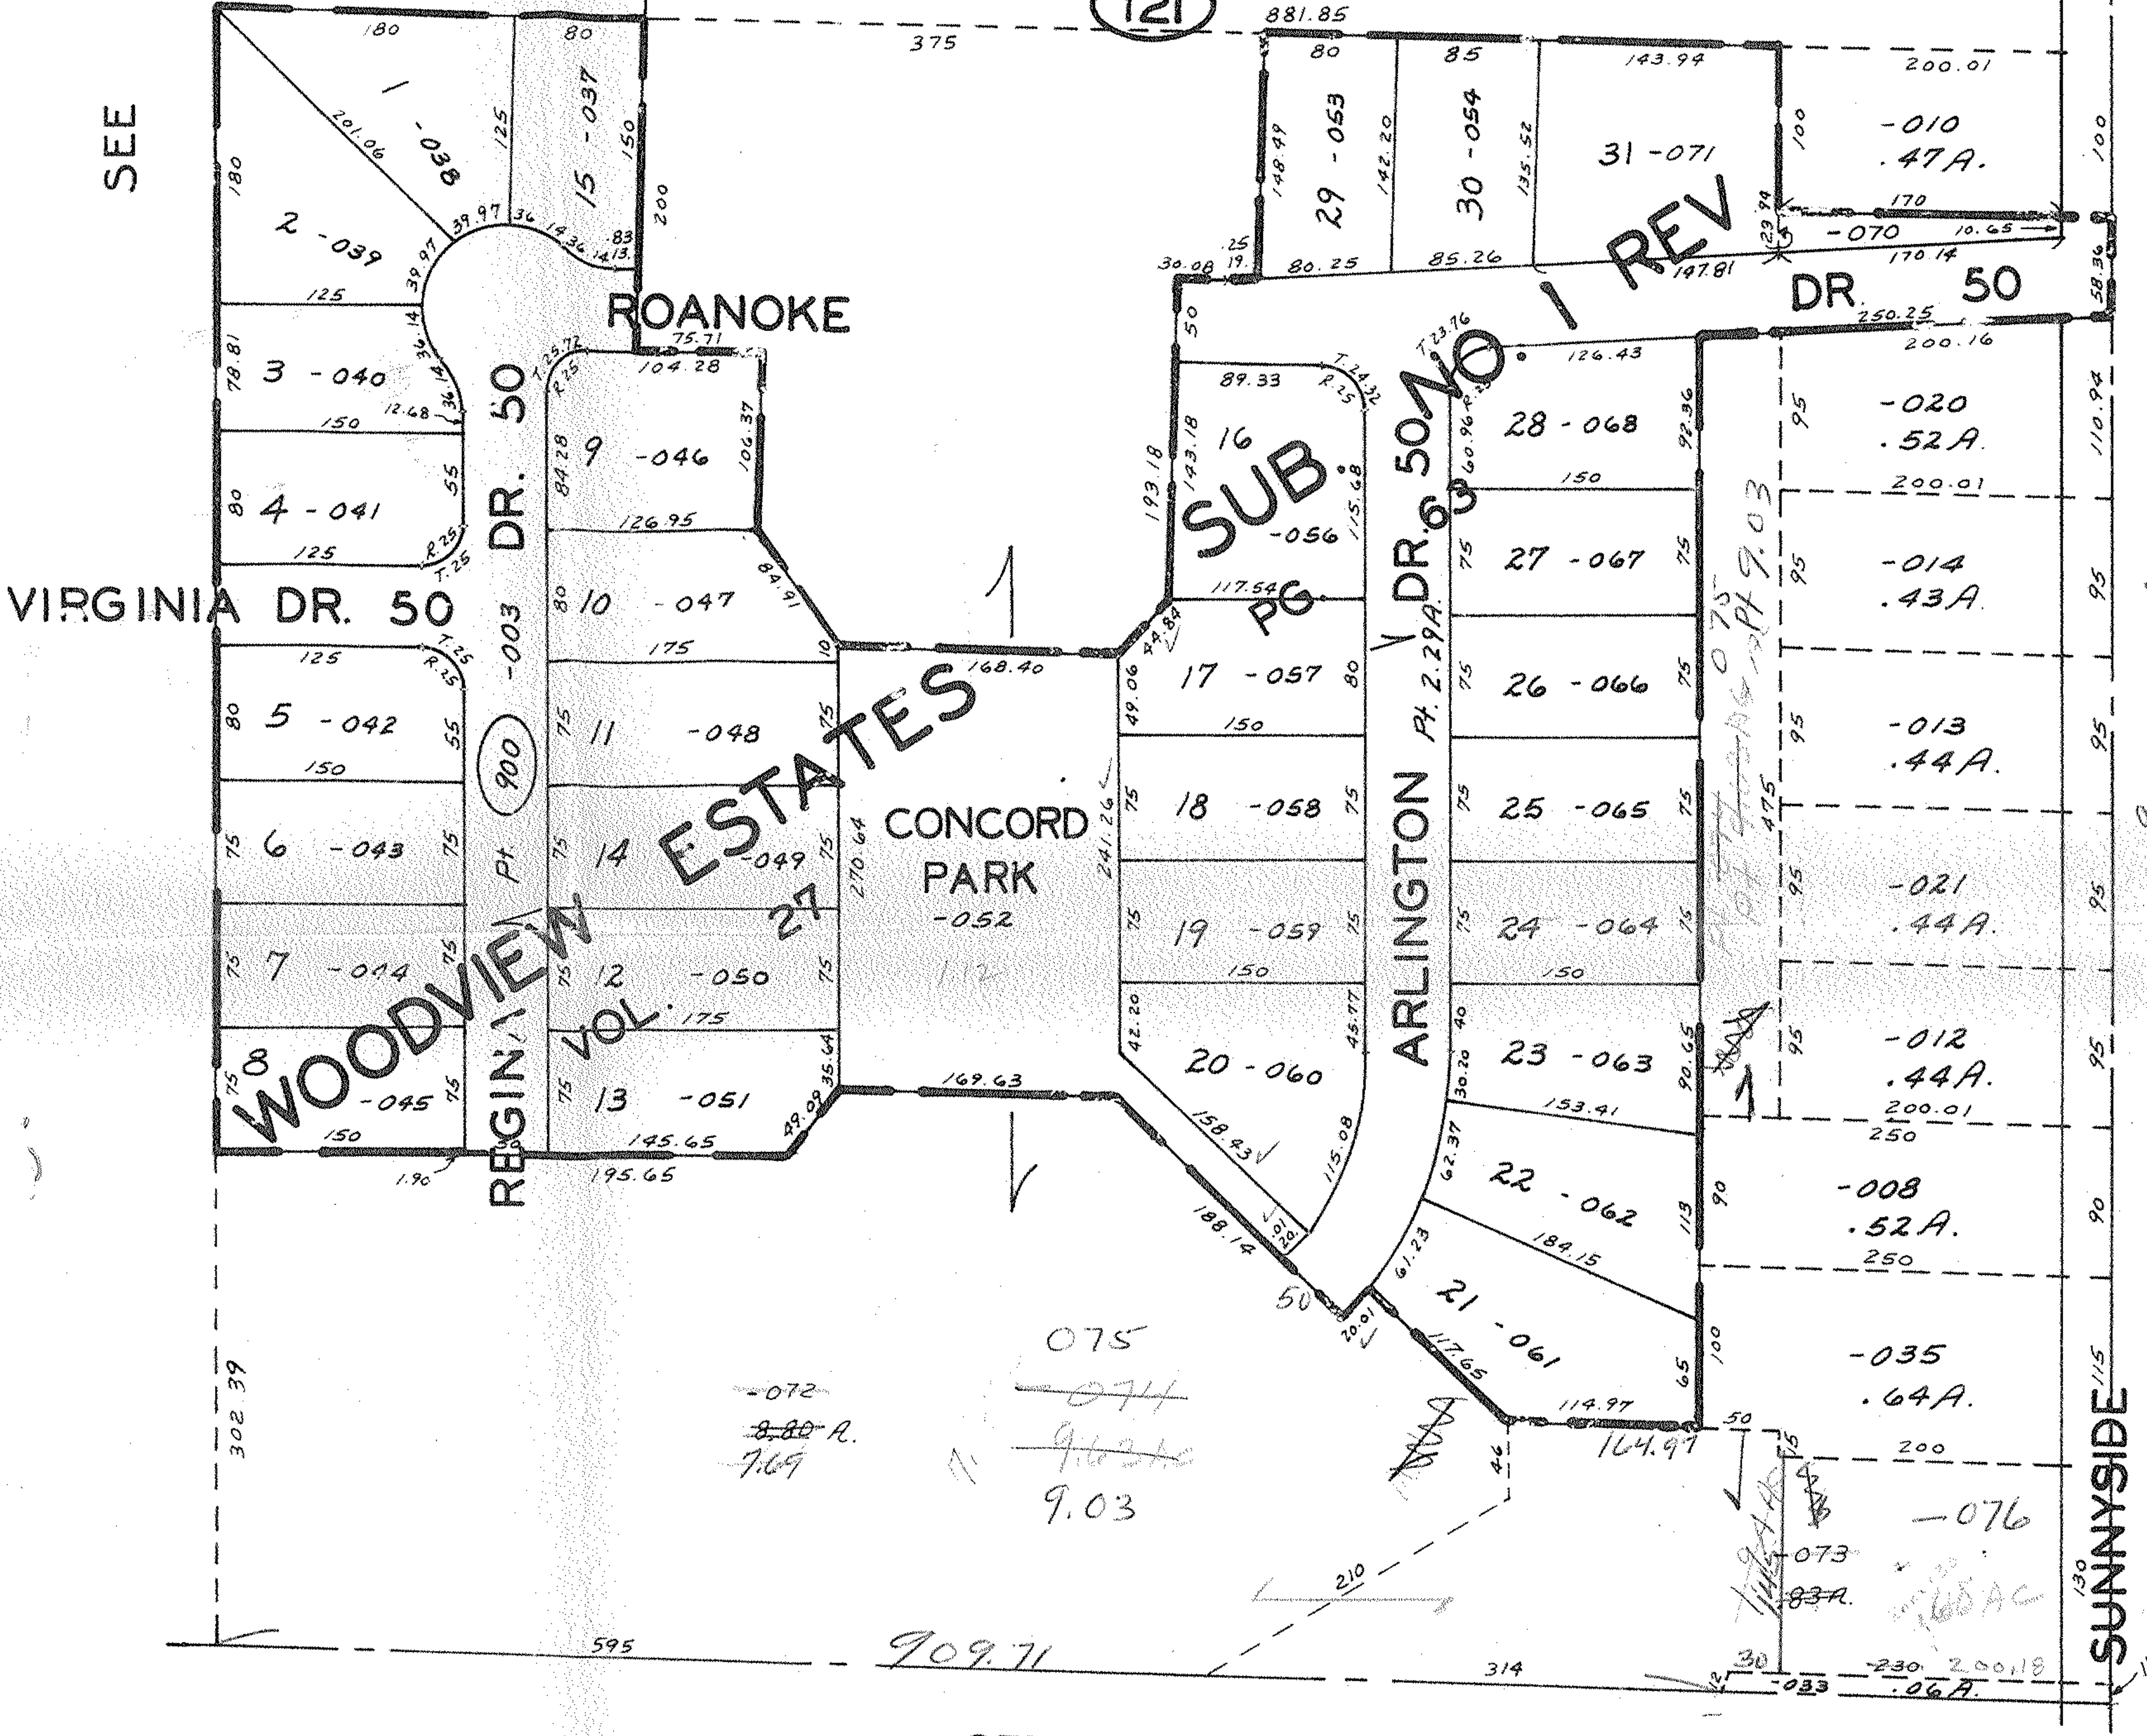

WOODVIEW
ESTATES
CONCORD PARK

SUB
PG

REV

075
~~074~~
~~9.62~~
 9.03

7.69
 1.94
 9.63

9.03
 8.46
 11.59

SEE I-B

BROWNHelm TWP.

SCALE 1" = 100'

SE PT. LOT 4