

333.32

7184

Change
acres on
1-00-032 - A & B.

See 01-00-0216 A
a/50


029
PT. 1025
PT. 7172.9
71.92

-024
11.70A

OK

7184
APPROVED
LORAIN CO.
MAP DEPT.
DATE 7-11-73
01-00-026B
BY L W Hall

S.S.
8-14-86

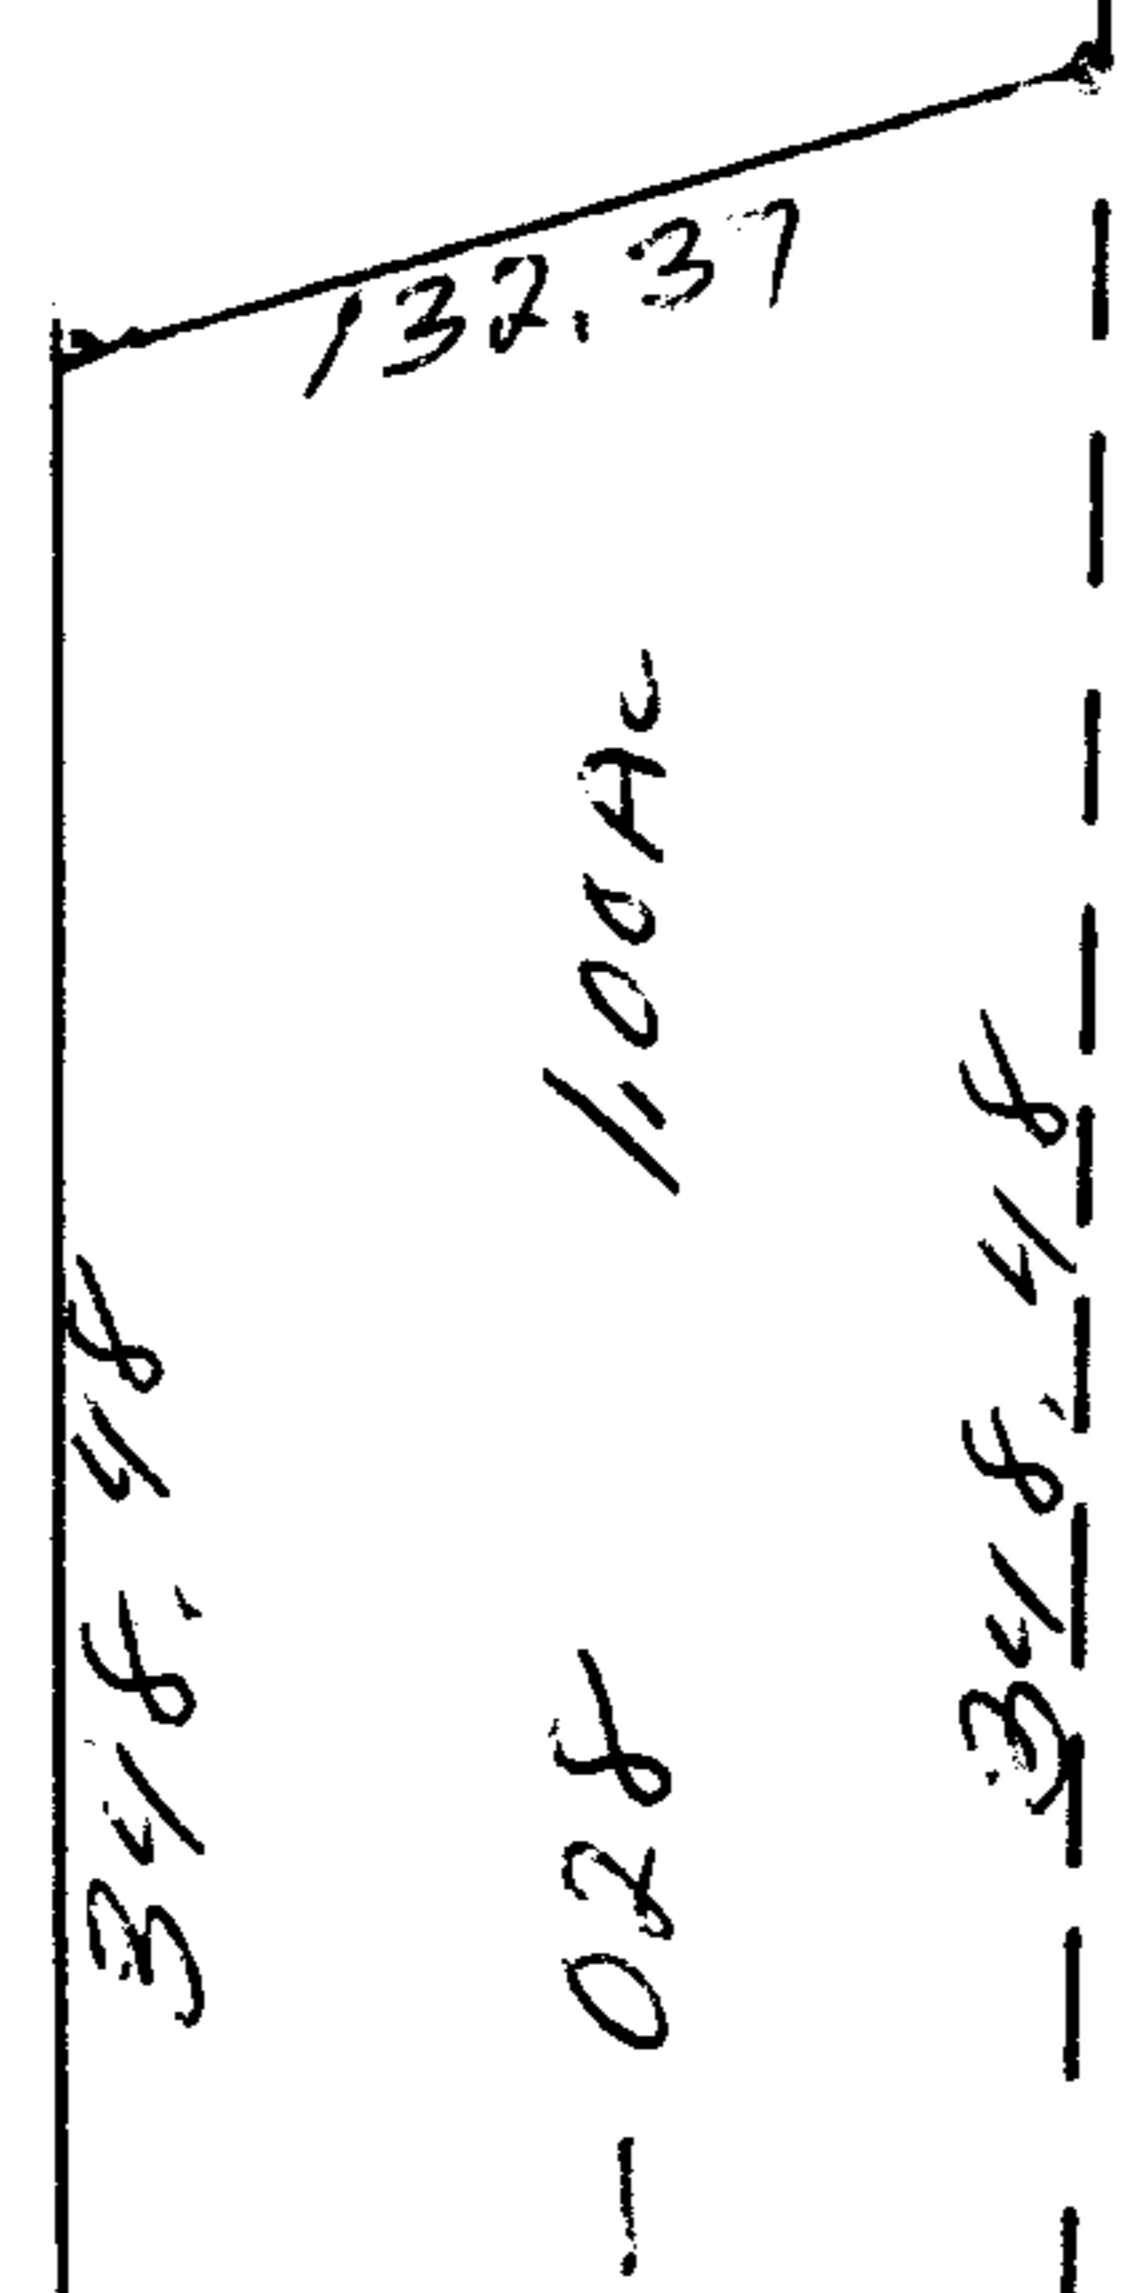

1036.20
215
132.37
COOPER FOSTER PARK
343.70
641.04
30.66
367.38
-010
.93A
402.81
64-705
4-29-69
111.92

-008

211.50
94

21
8A.

440