


Russia

7198 7198

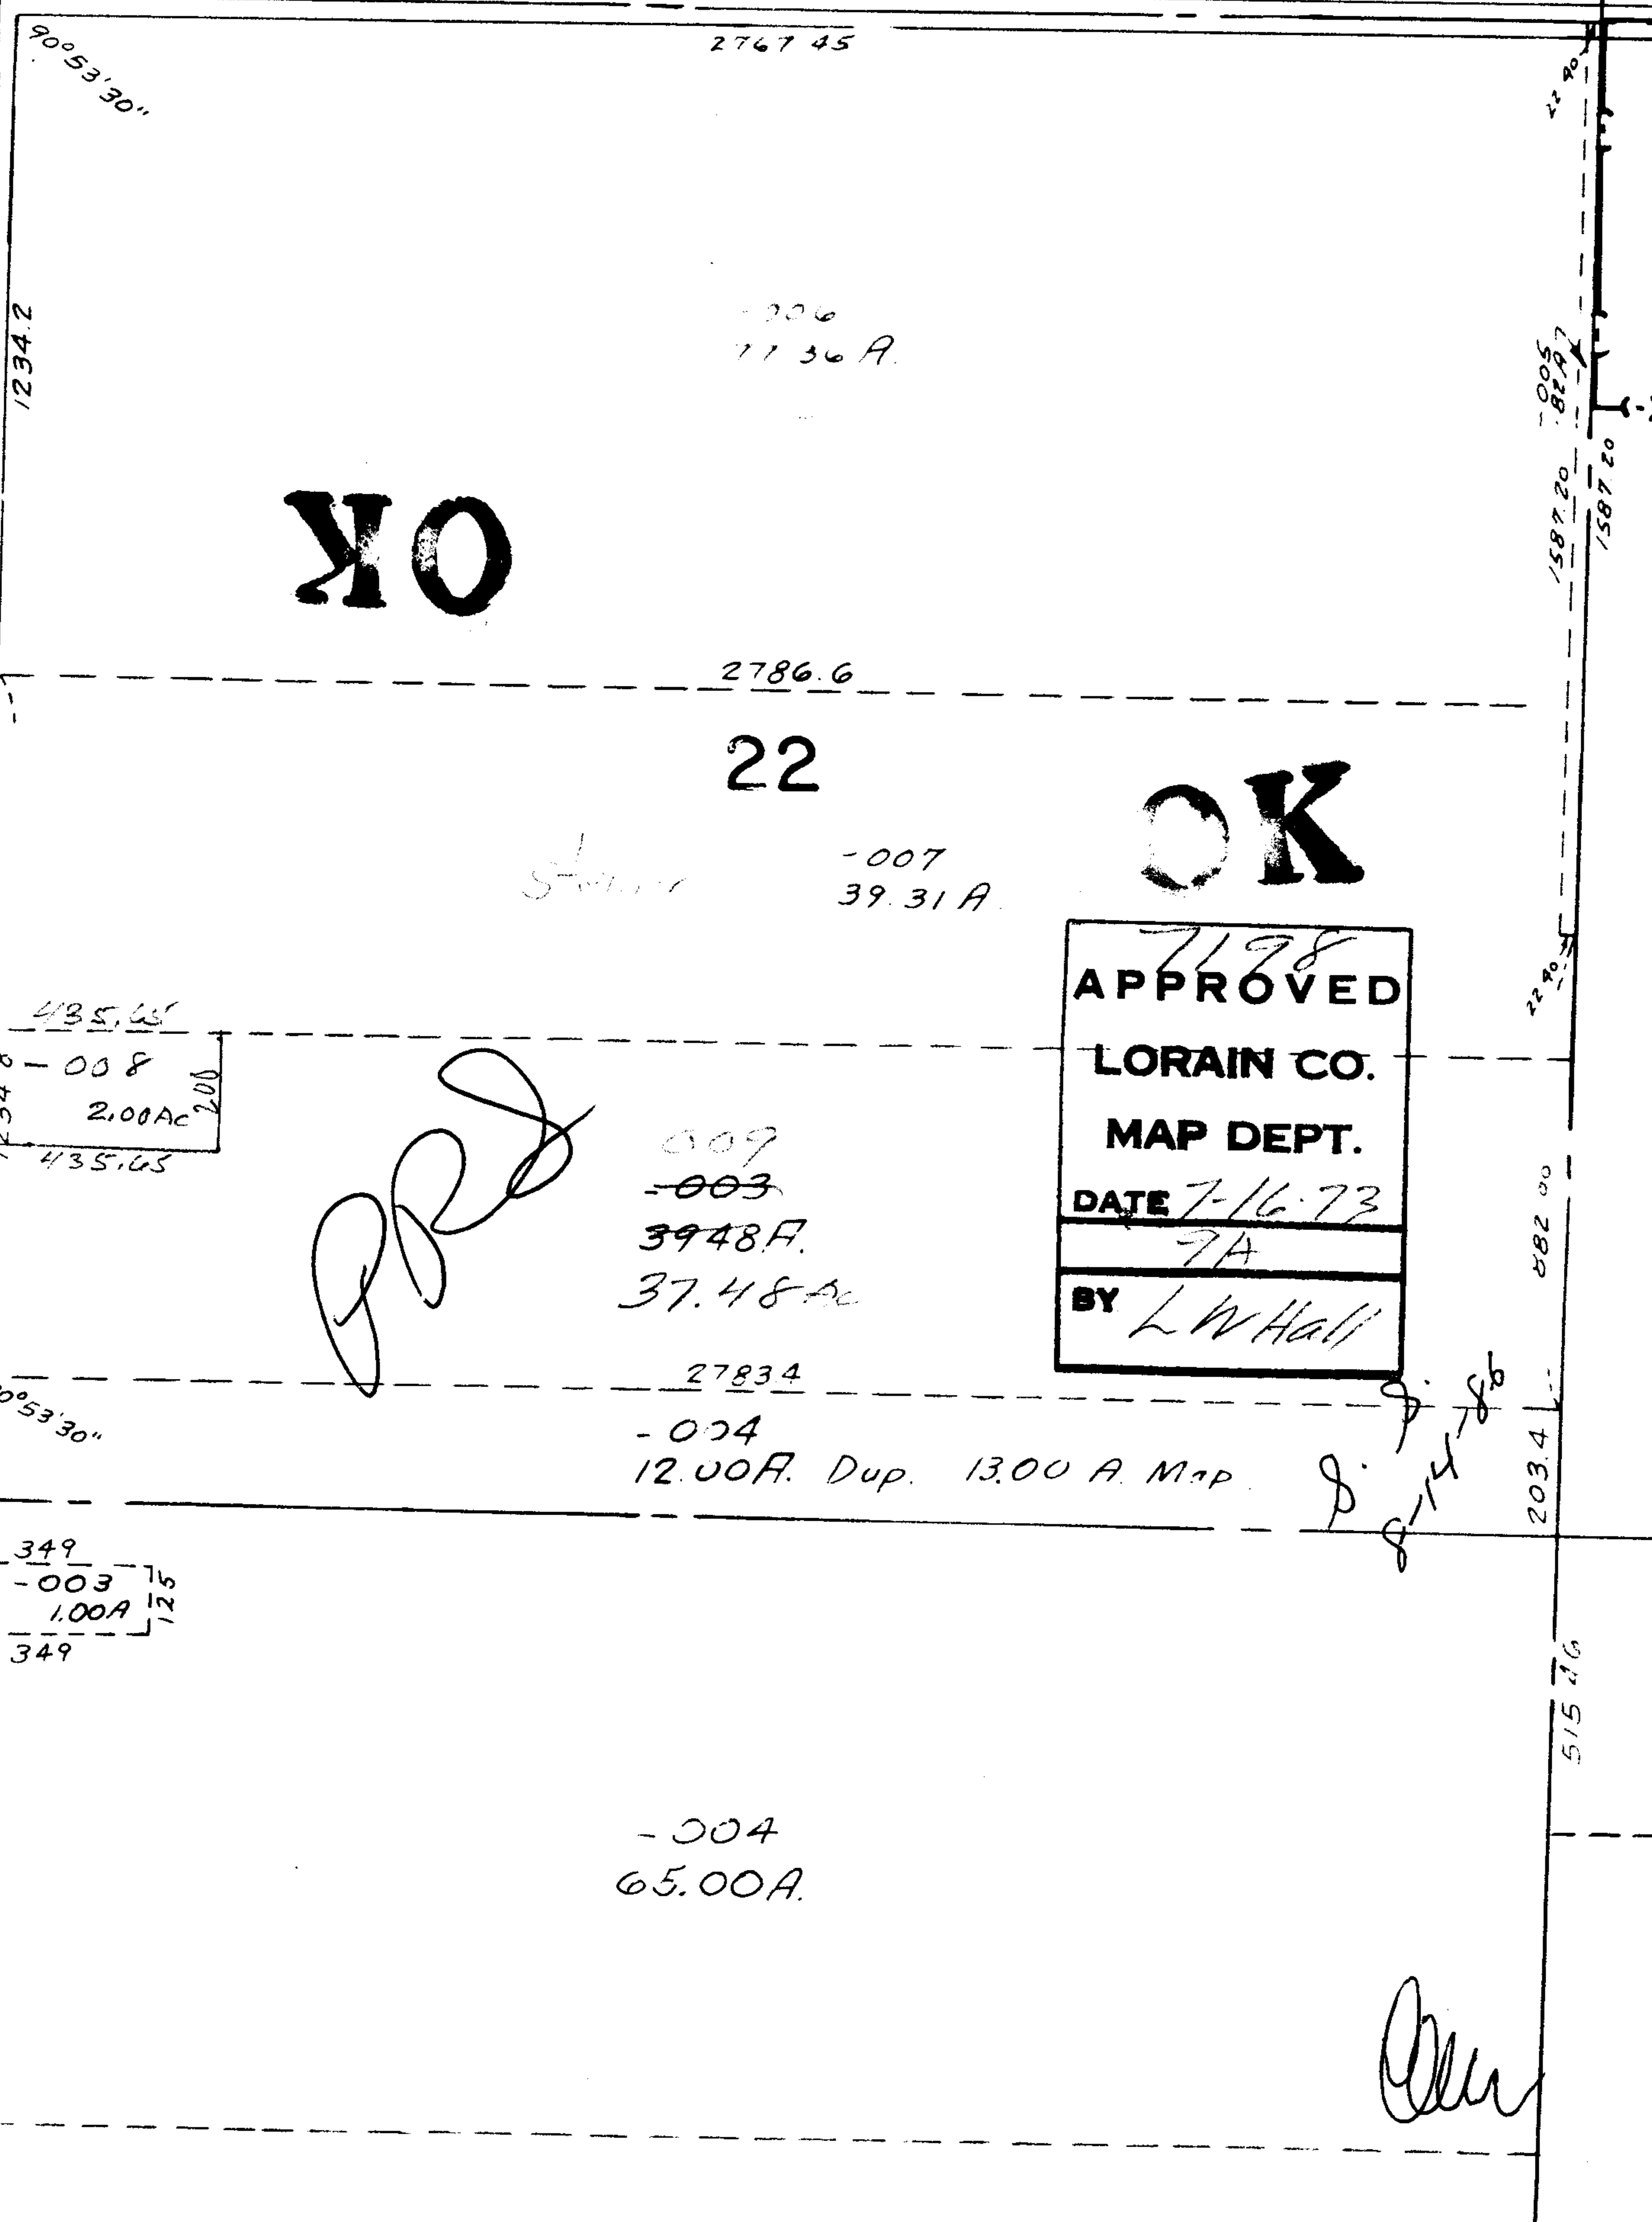

OK

2786.6
22

OK

7198
APPROVED
LORAIN CO.
MAP DEPT.
DATE 7-16-73
 7A
BY LWHall

009
~~003~~
 39.48 A.
 37.48 AC

27834
 -004
 12.00 A. Dup. 13.00 A. Map

-004
 65.00 A.

435.65
 -008
 2.00 AC
 435.65

349
 -003
 1.00 A
 349

003
 15 A.
 004
 70 A.
 178

Handwritten signature

8-14-86

Aller