

SEE 4-00-0-5

WASHINGTON

SQUARE

86 VOL

87 - 078

88

SUB

88

89 - 076

PG

90 - 074


91

NO

91

16

7203

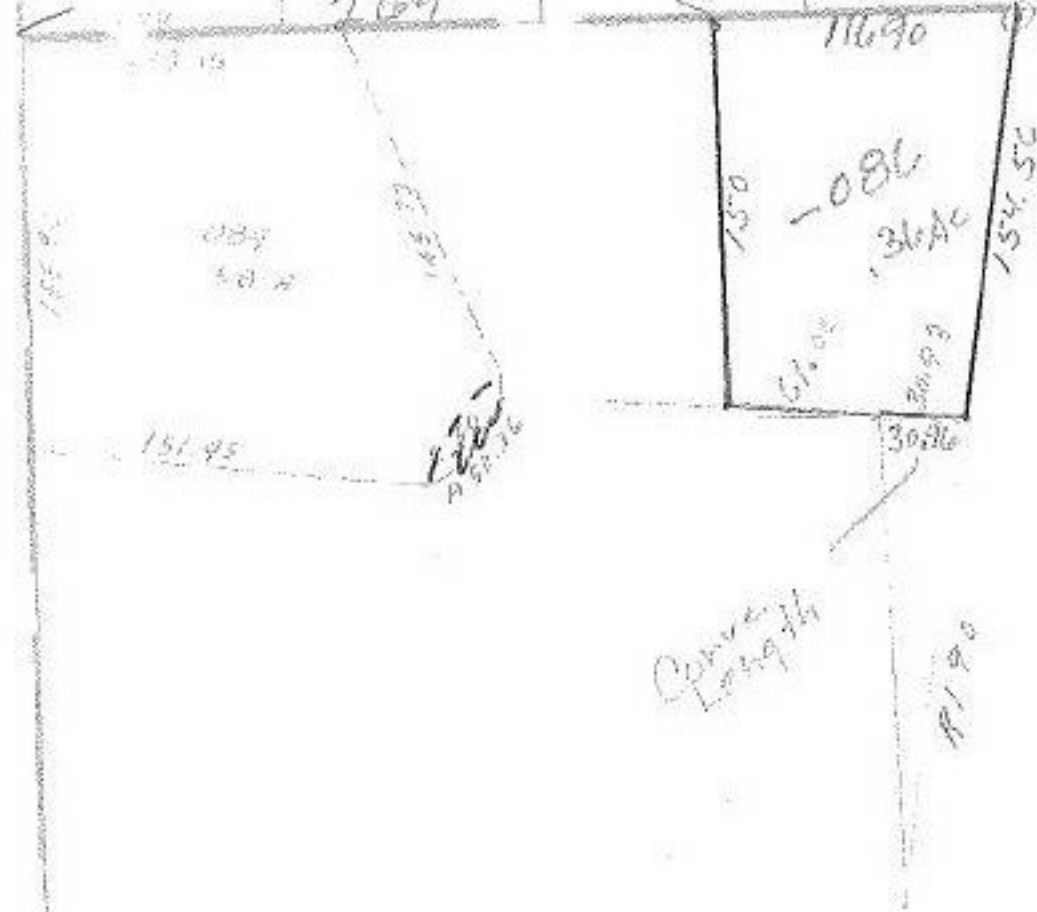

OK

7203

APPROVED
 LORAIN CO.
 MAP DEPT.
 DATE 7-17-73
 04-00-018F
 BY L. W. Hall

7.29.86 L.L.

087

~~083~~
24.06A
20.70AC

Washington Square

59.28

PPS

7203