


7207

OK

*[Handwritten signature]*

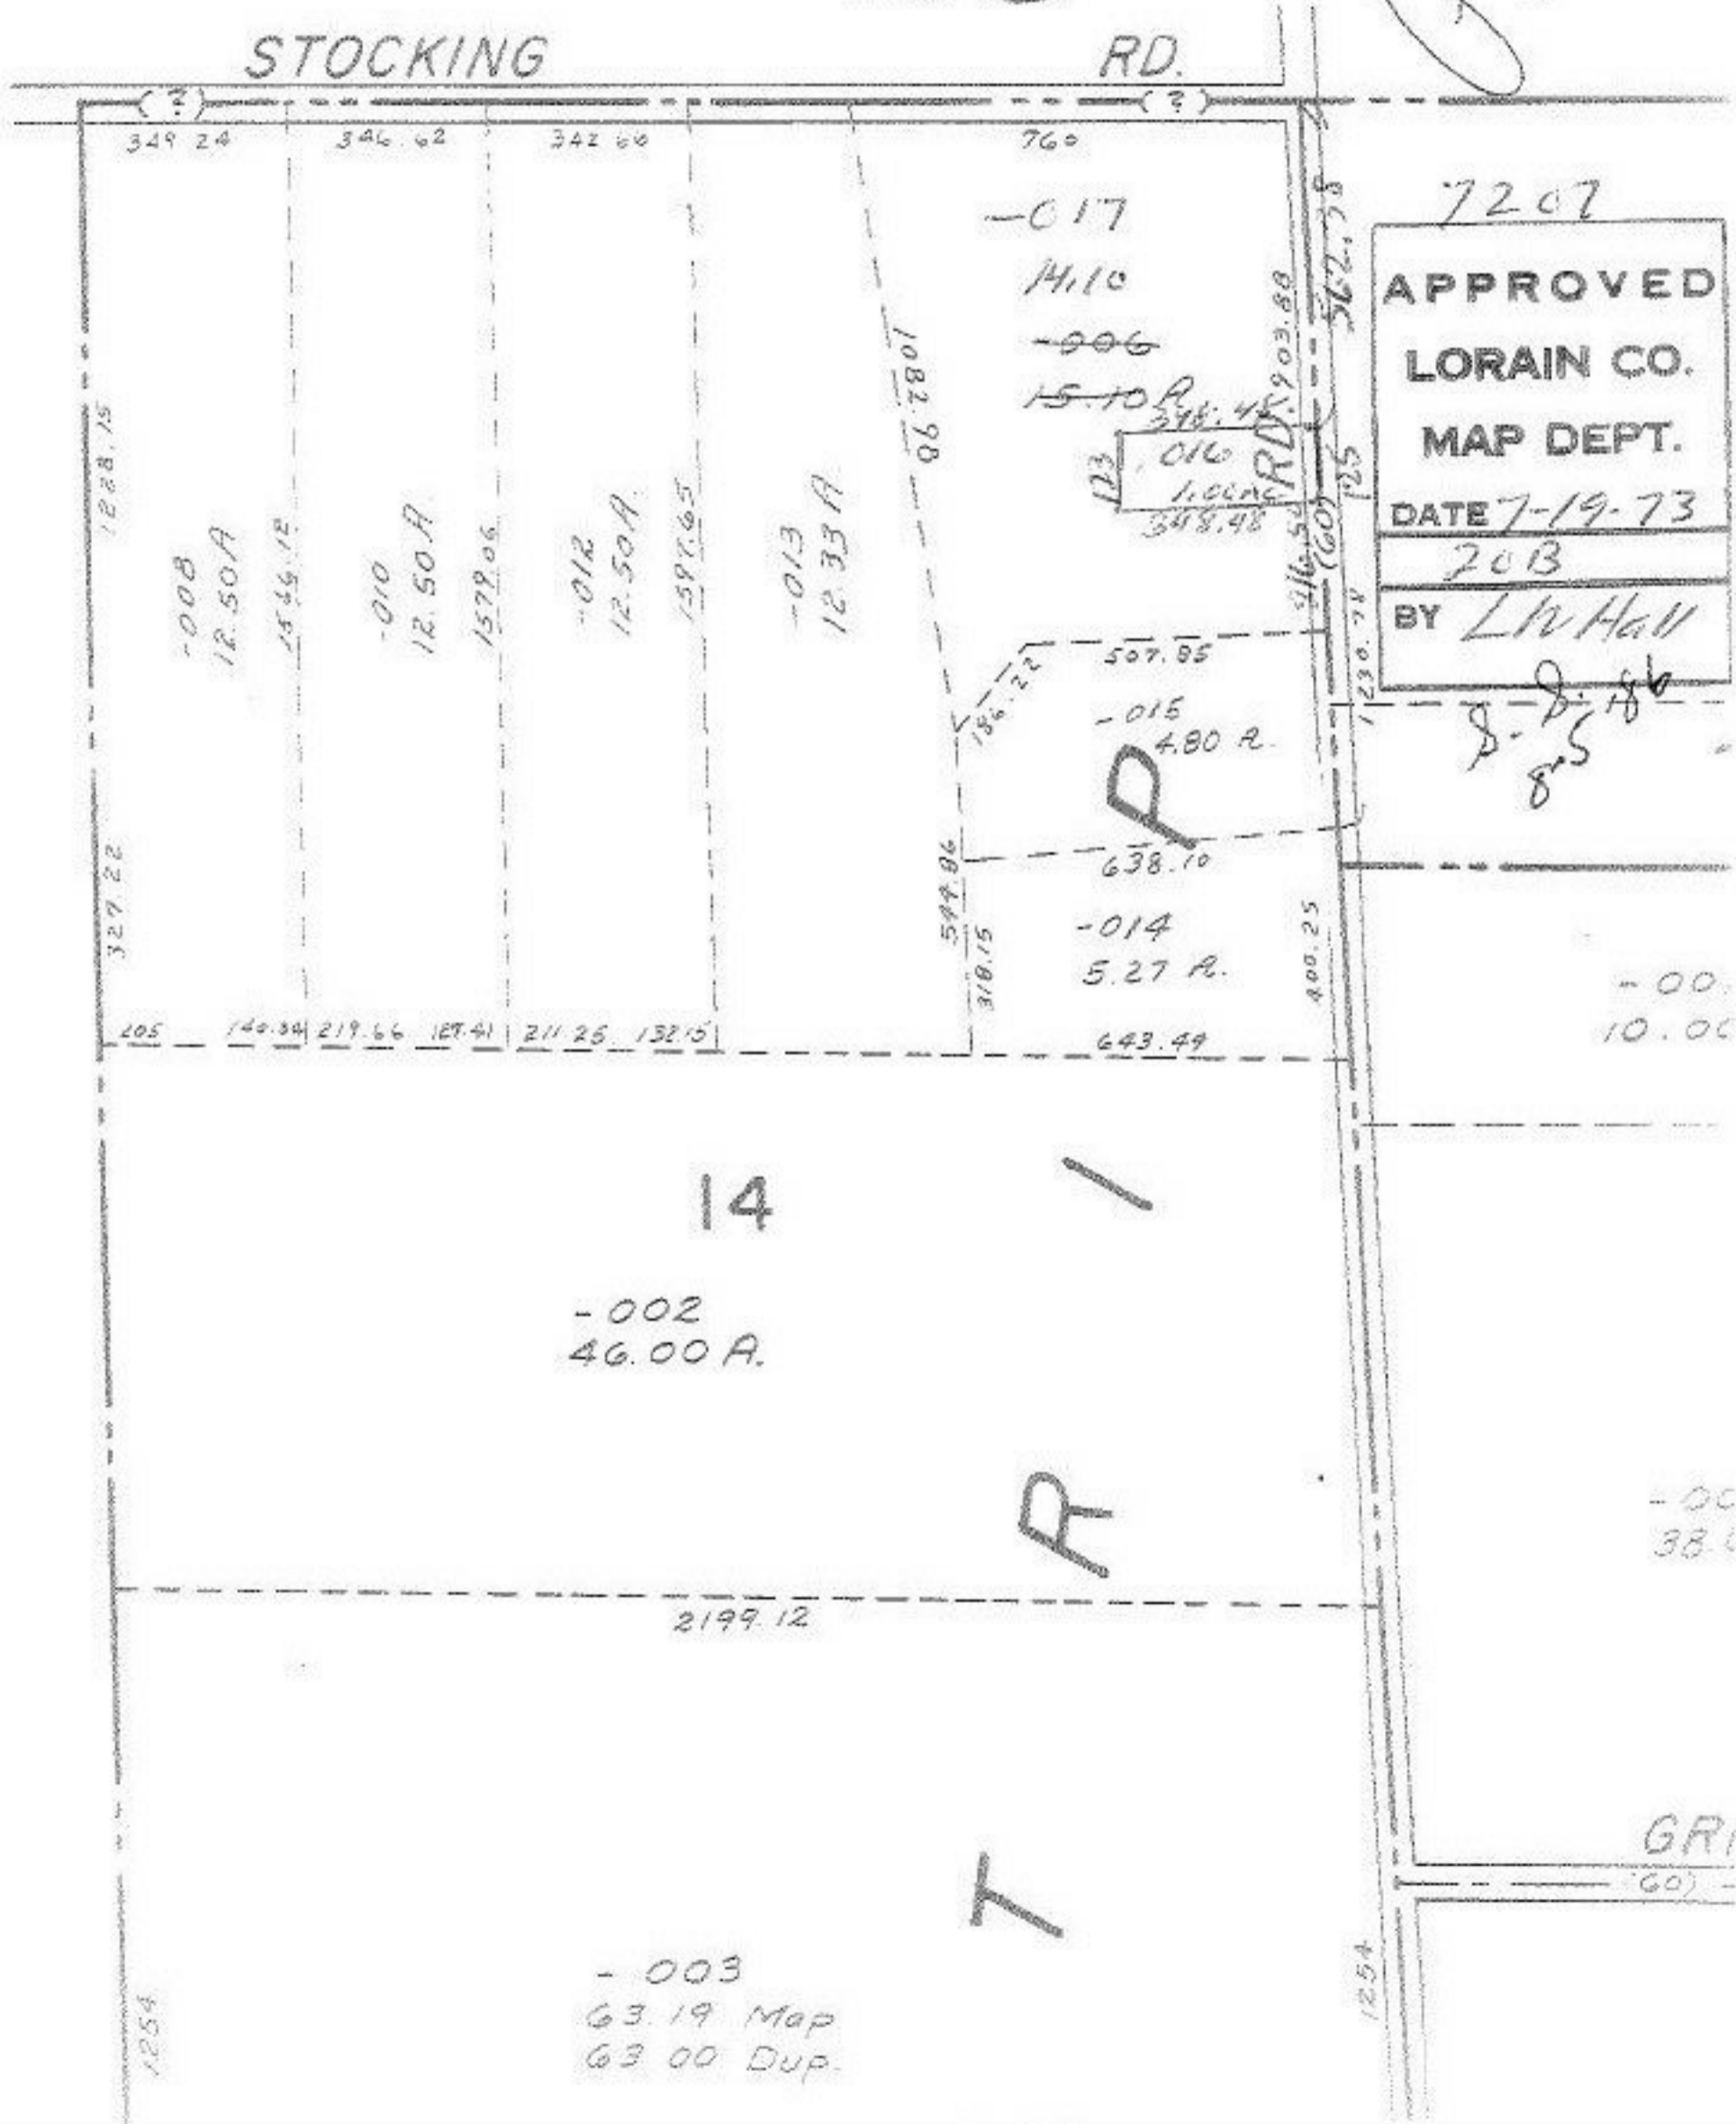

7207

APPROVED  
LORAIN CO.  
MAP DEPT.  
DATE 7-19-73  
203  
BY L. V. Hall

- 003  
63.19 Map  
63 00 Dup.

- 00  
10.00

- 00  
38.4

GR  
(60)