

7212

SEE 5-00 000-2


See Tax Map pg 009A

1.82 Ac  
- 38  
1.44

037  
~~037~~  
7.75 Ac

101

7-29-81/ok  
7212  
**APPROVED**  
**LORAIN CO.**  
**MAP DEPT.**  
DATE 7-26-73  
05-00-010A + 009A  
BY L.W. Hall

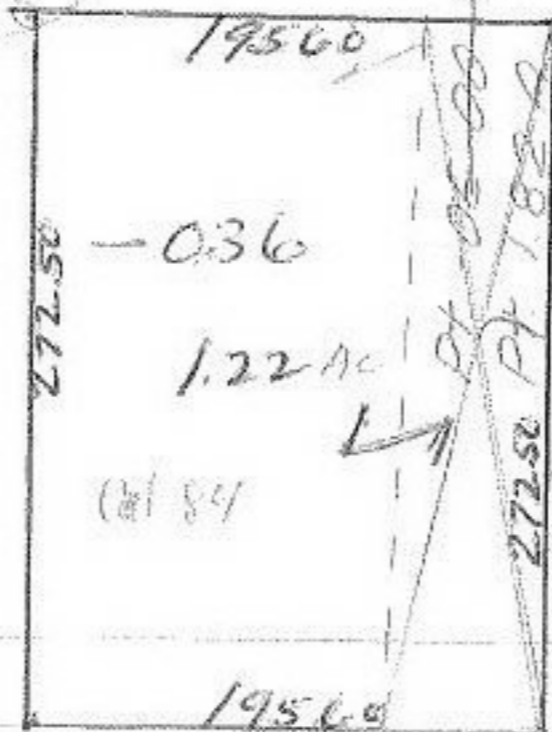

OK

*[Handwritten signature]*

272.50  
60

3,350.00  
4125.00 = 38A

.84 A  
38  
122 Ac

272.50  
-0.04  
-73A

RD 140

7212

MILAN ELYRIA