


7214 2/2

SEE 4-00-022-H

830

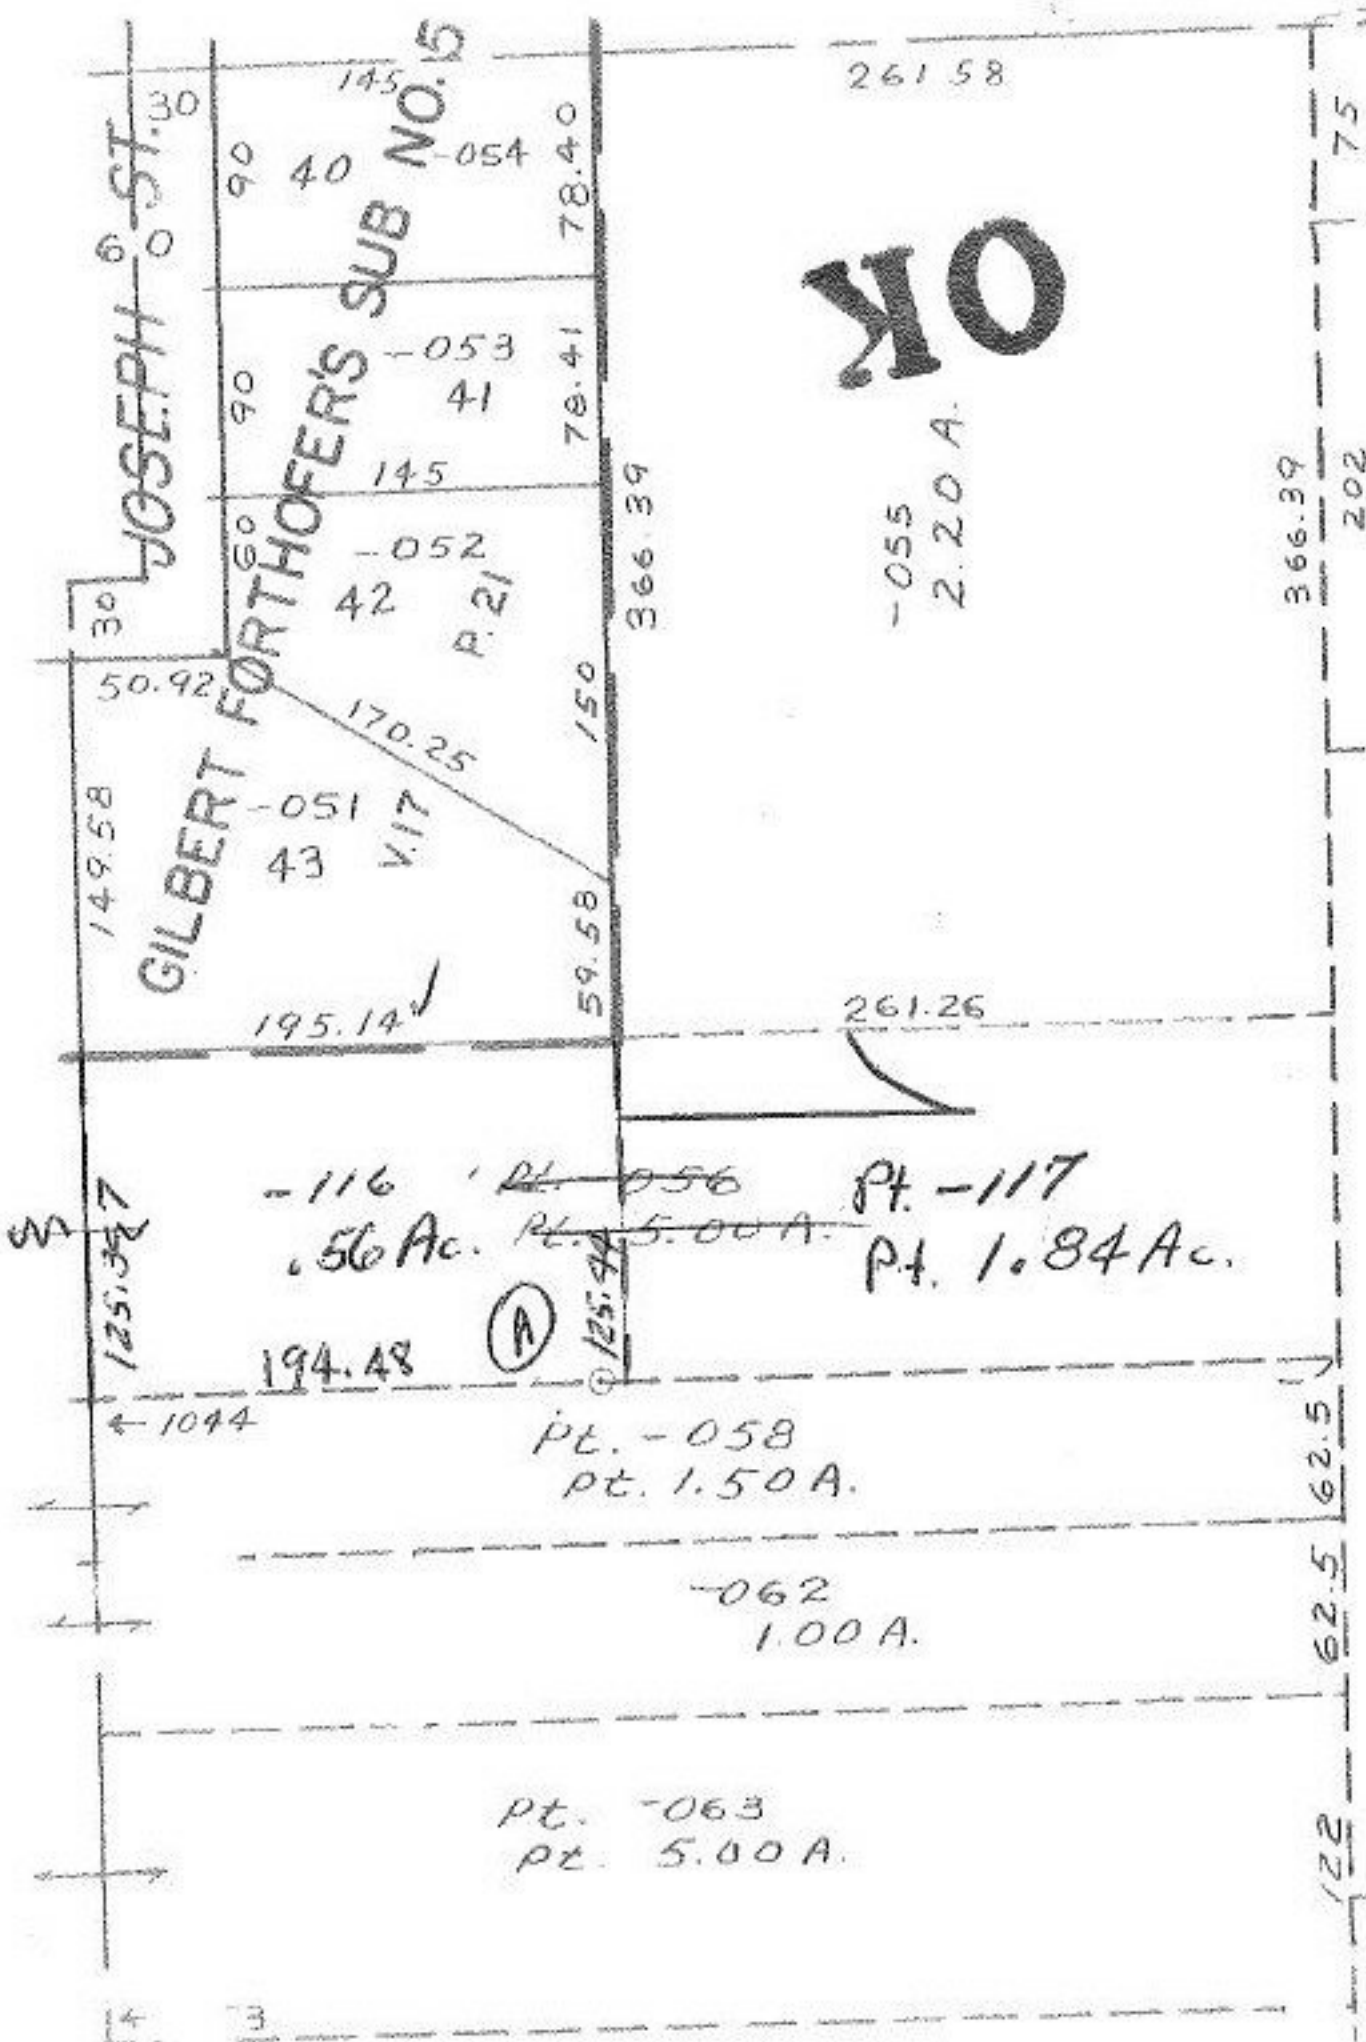

OK

7214

APPROVED  
 LORAIN CO.  
 MAP DEPT.  
 DATE 7-20-73  
 4-00-023-C4D  
 BY *[Signature]*

-069  
1.13 A.

825

-071  
3.85 A.

*[Handwritten mark]*

-083  
6.97 A.

833.62