


7217 + 7205

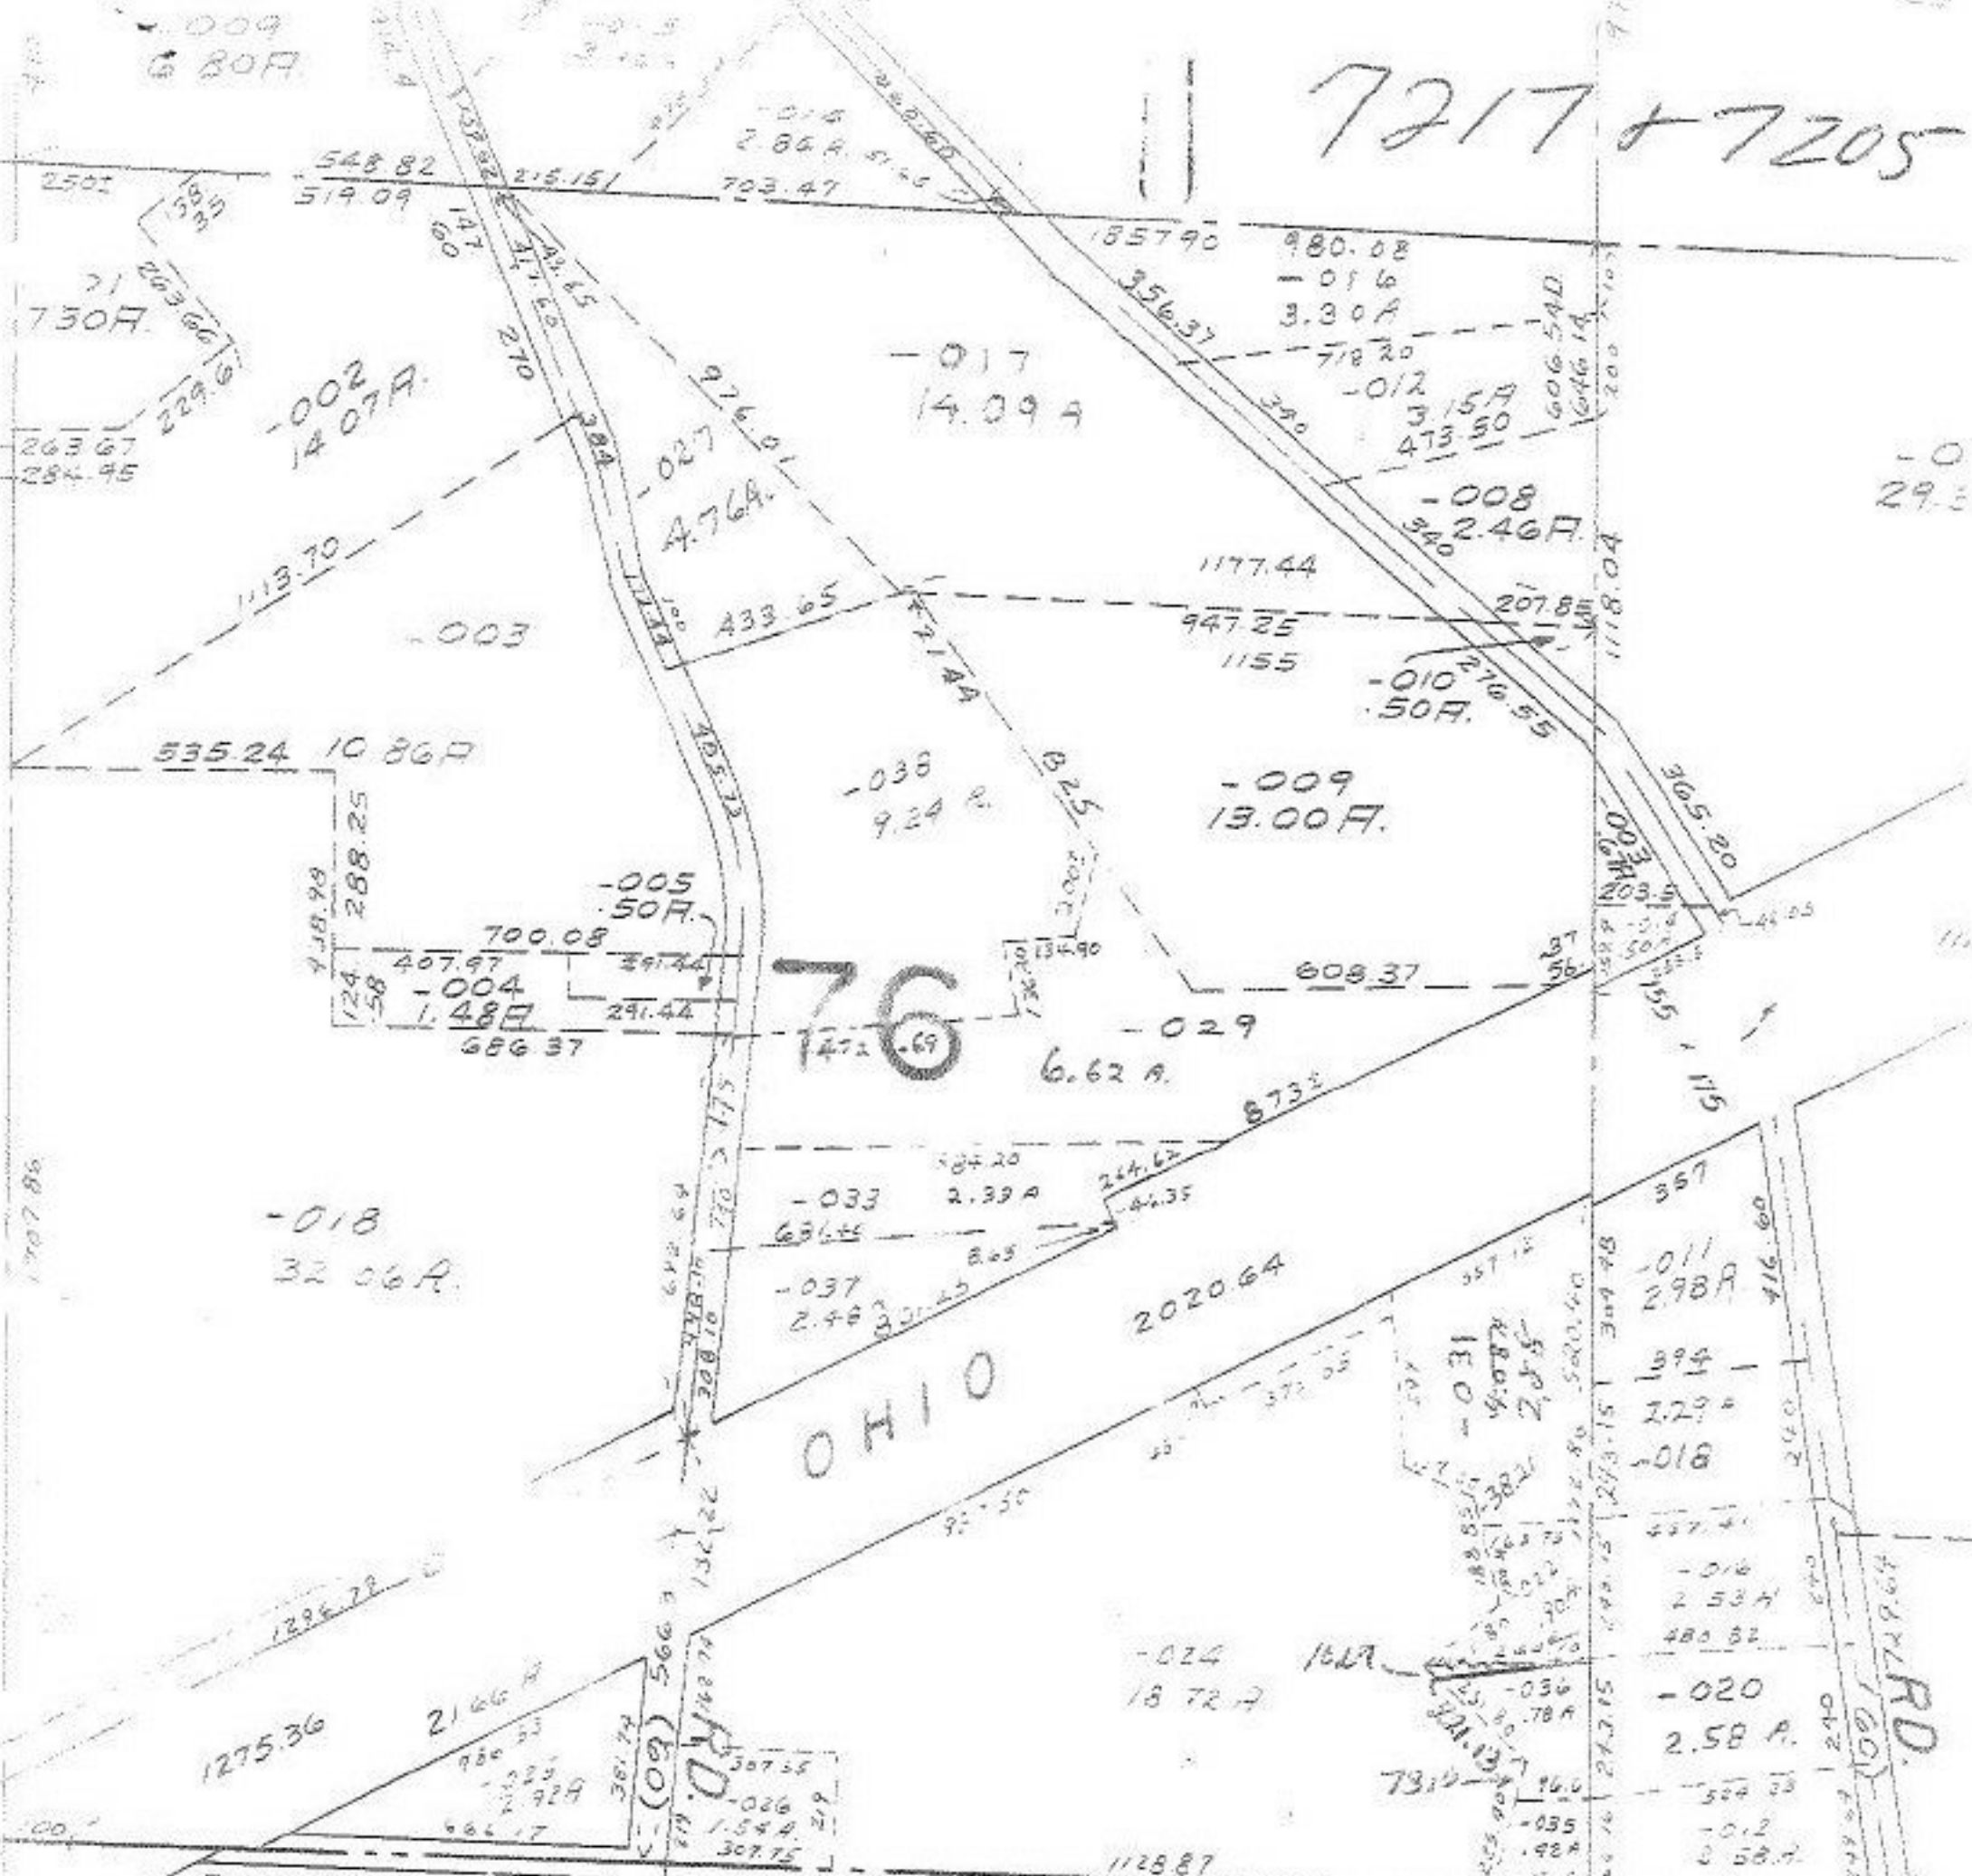

7217
APPROVED
 LORAIN CO.
 MAP DEPT.
 DATE 7-20-73
 IK
 BY L.H. Hall

OK

PRD

BROWNHELM TWP.

SCALE: 1" = 400'