

7221


OSTER

RD.

RD.

*Handwritten signature*

*Handwritten signature*

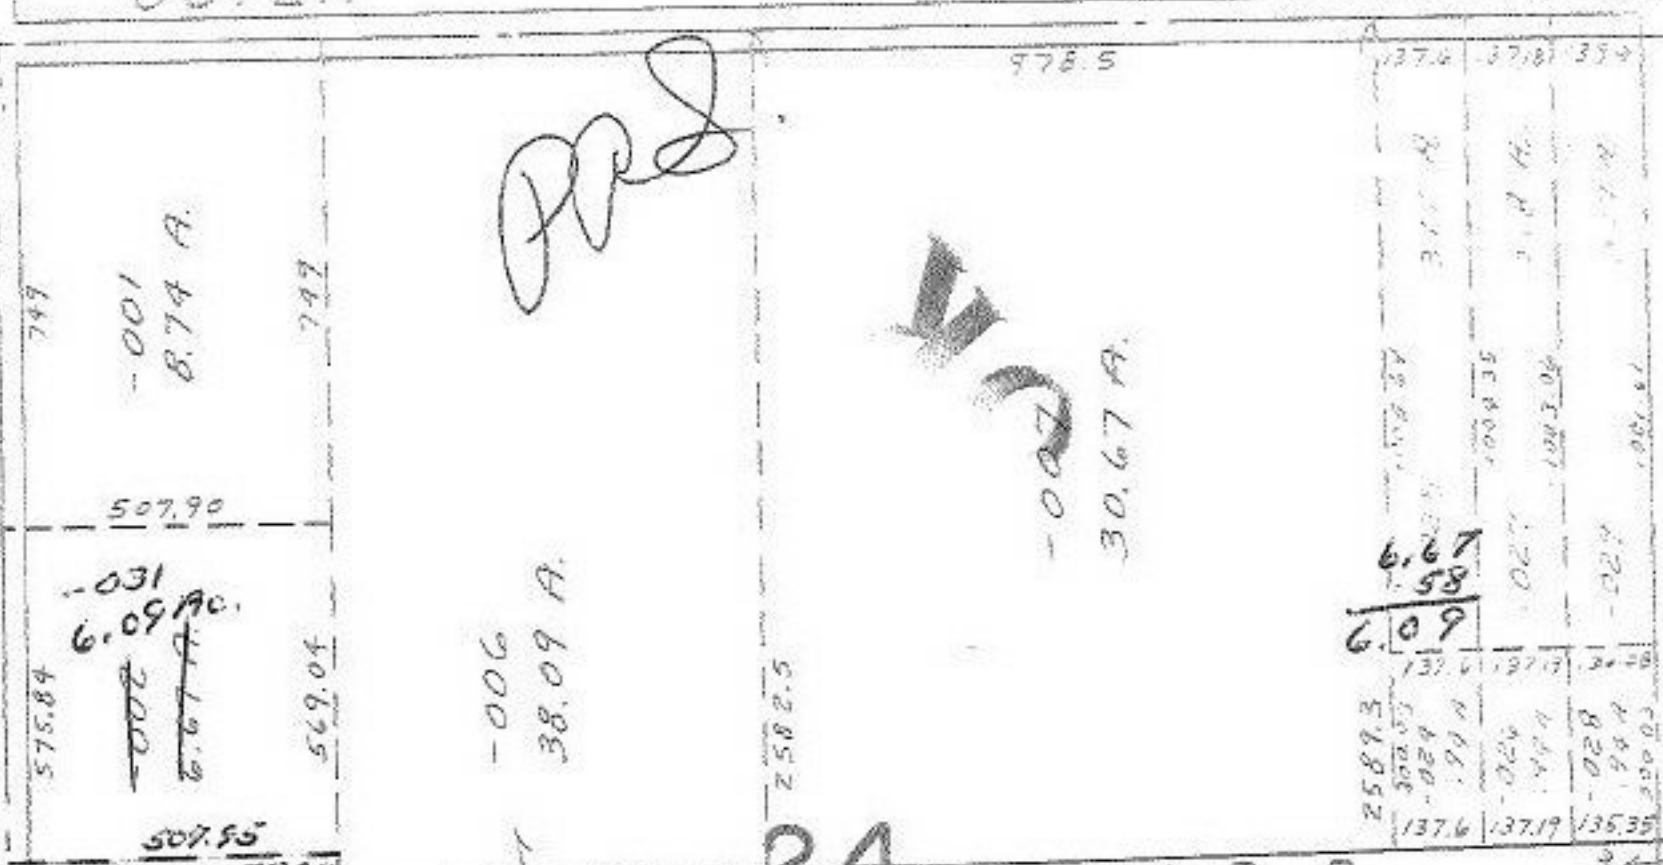

PL - 001 24 PL. 7.752 A. R. R.

7221

APPROVED  
 LORAIN CO.  
 MAP DEPT.  
 DATE 7-25-23  
 3-G  
 BY *Handwritten signature*

*Handwritten signature*  
 P. D.  
 8-5-23

500

