


*Handwritten scribbles and numbers in the top left corner.*

001  
00 A. D.  
50 A. DUP.

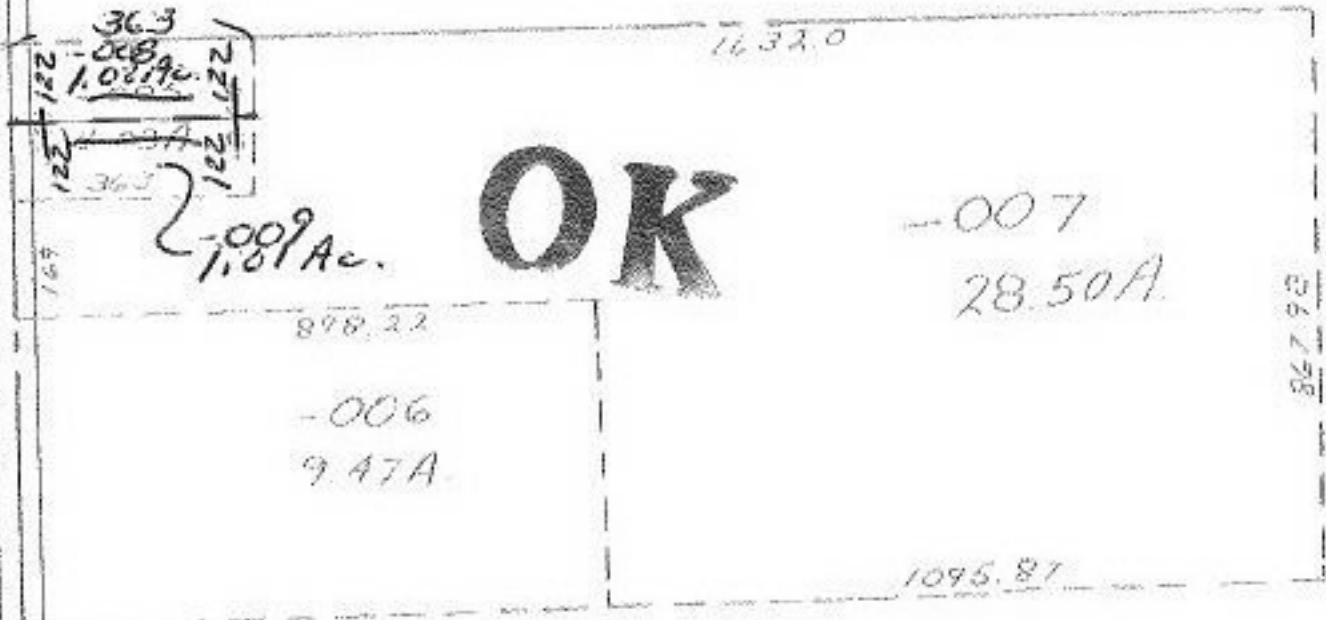


DIAGONAL

PLATE

792 NICKLE 775

(60)

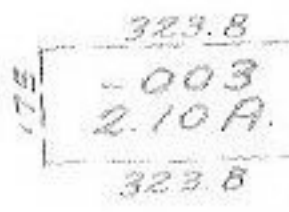

*Large handwritten signature or scribble.*

42

-002  
113.00 A.

**7227**

APPROVED  
LORAIN CO.  
MAP DEPT.

DATE 7-25-73

15-A

BY *Kadler*

7-29-85 L.L.

LAGRANGE - RICHFIELD

1627.80

7227