

7239

85

96

105

RD

RL

-011  
27.31F.

-002  
89F.

-008  
775.52  
1.20A  
452.25

1559.58  
789.53  
-004  
4.66F.  
565.03

-009  
14.34F.

-007  
35.25F.

1065.29  
470.65  
595.14  
-001  
1.28F.  
415.62  
273.24  
207.24  
1589.28

012  
1.25A  
015  
3.0A  
016  
11.89AC  
248.67  
4127.14  
443.69

HALLAUER

Corrected to  
Read

~~017~~ 021  
11-1-73  
~~008~~  
79.73F.  
67.84

7239  
APPROVED  
LORAIN CO.  
MAP DEPT.  
DATE 7-31-73  
146  
BY LW Hall

-004  
28.00F.


-005  
52.00F.

1628.22

646.80

1061.28

-001  
6.00F.

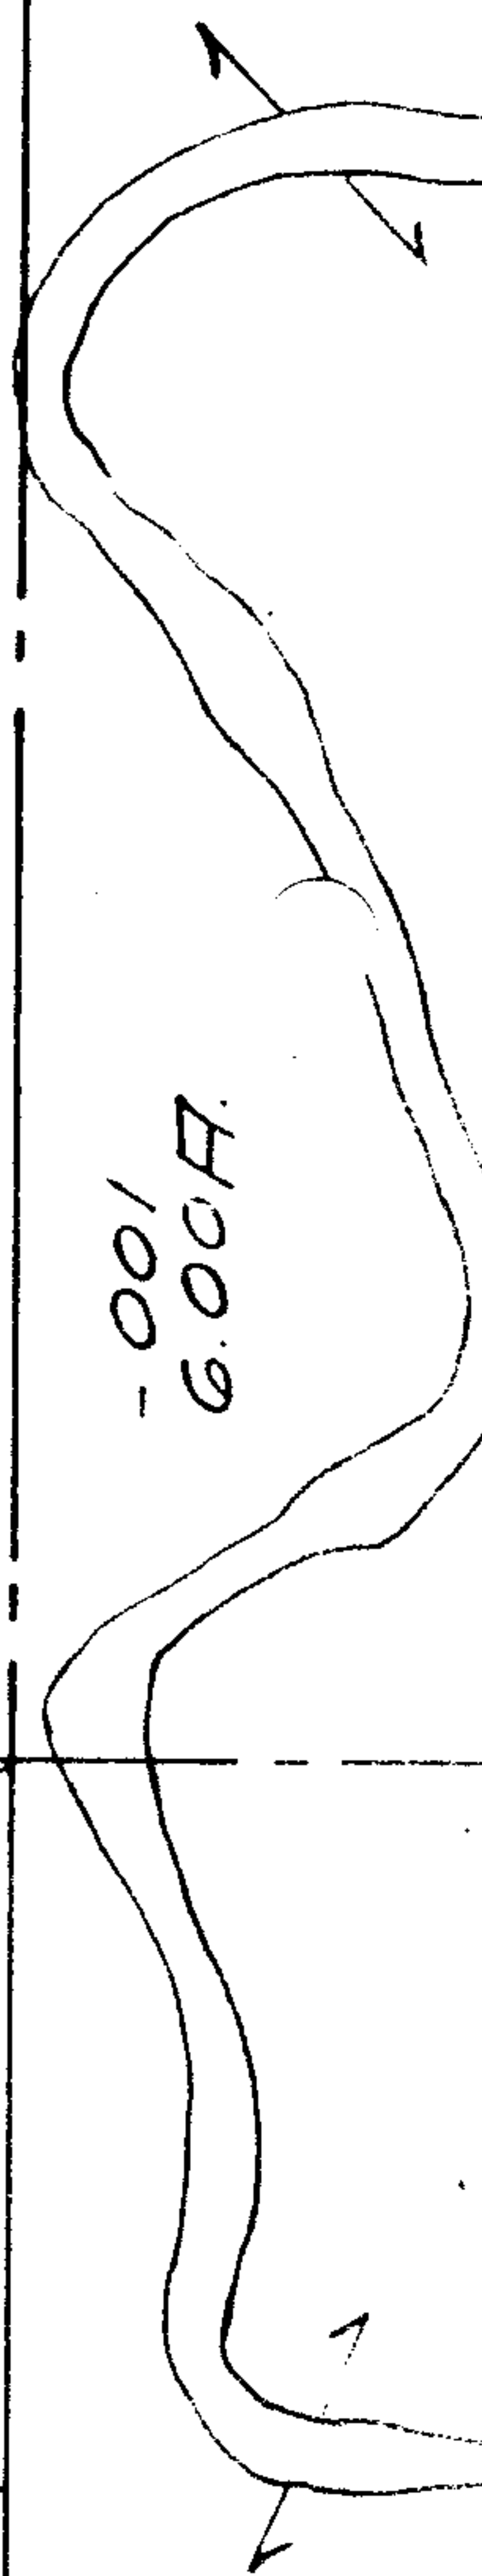

OK  
PLD