

7241
+ 7242

-002
50.00 A.

-004
49.00 A.

OK

see
survey.


400

-002
68.00 A.

8

ROWELL 1270.0

(69)

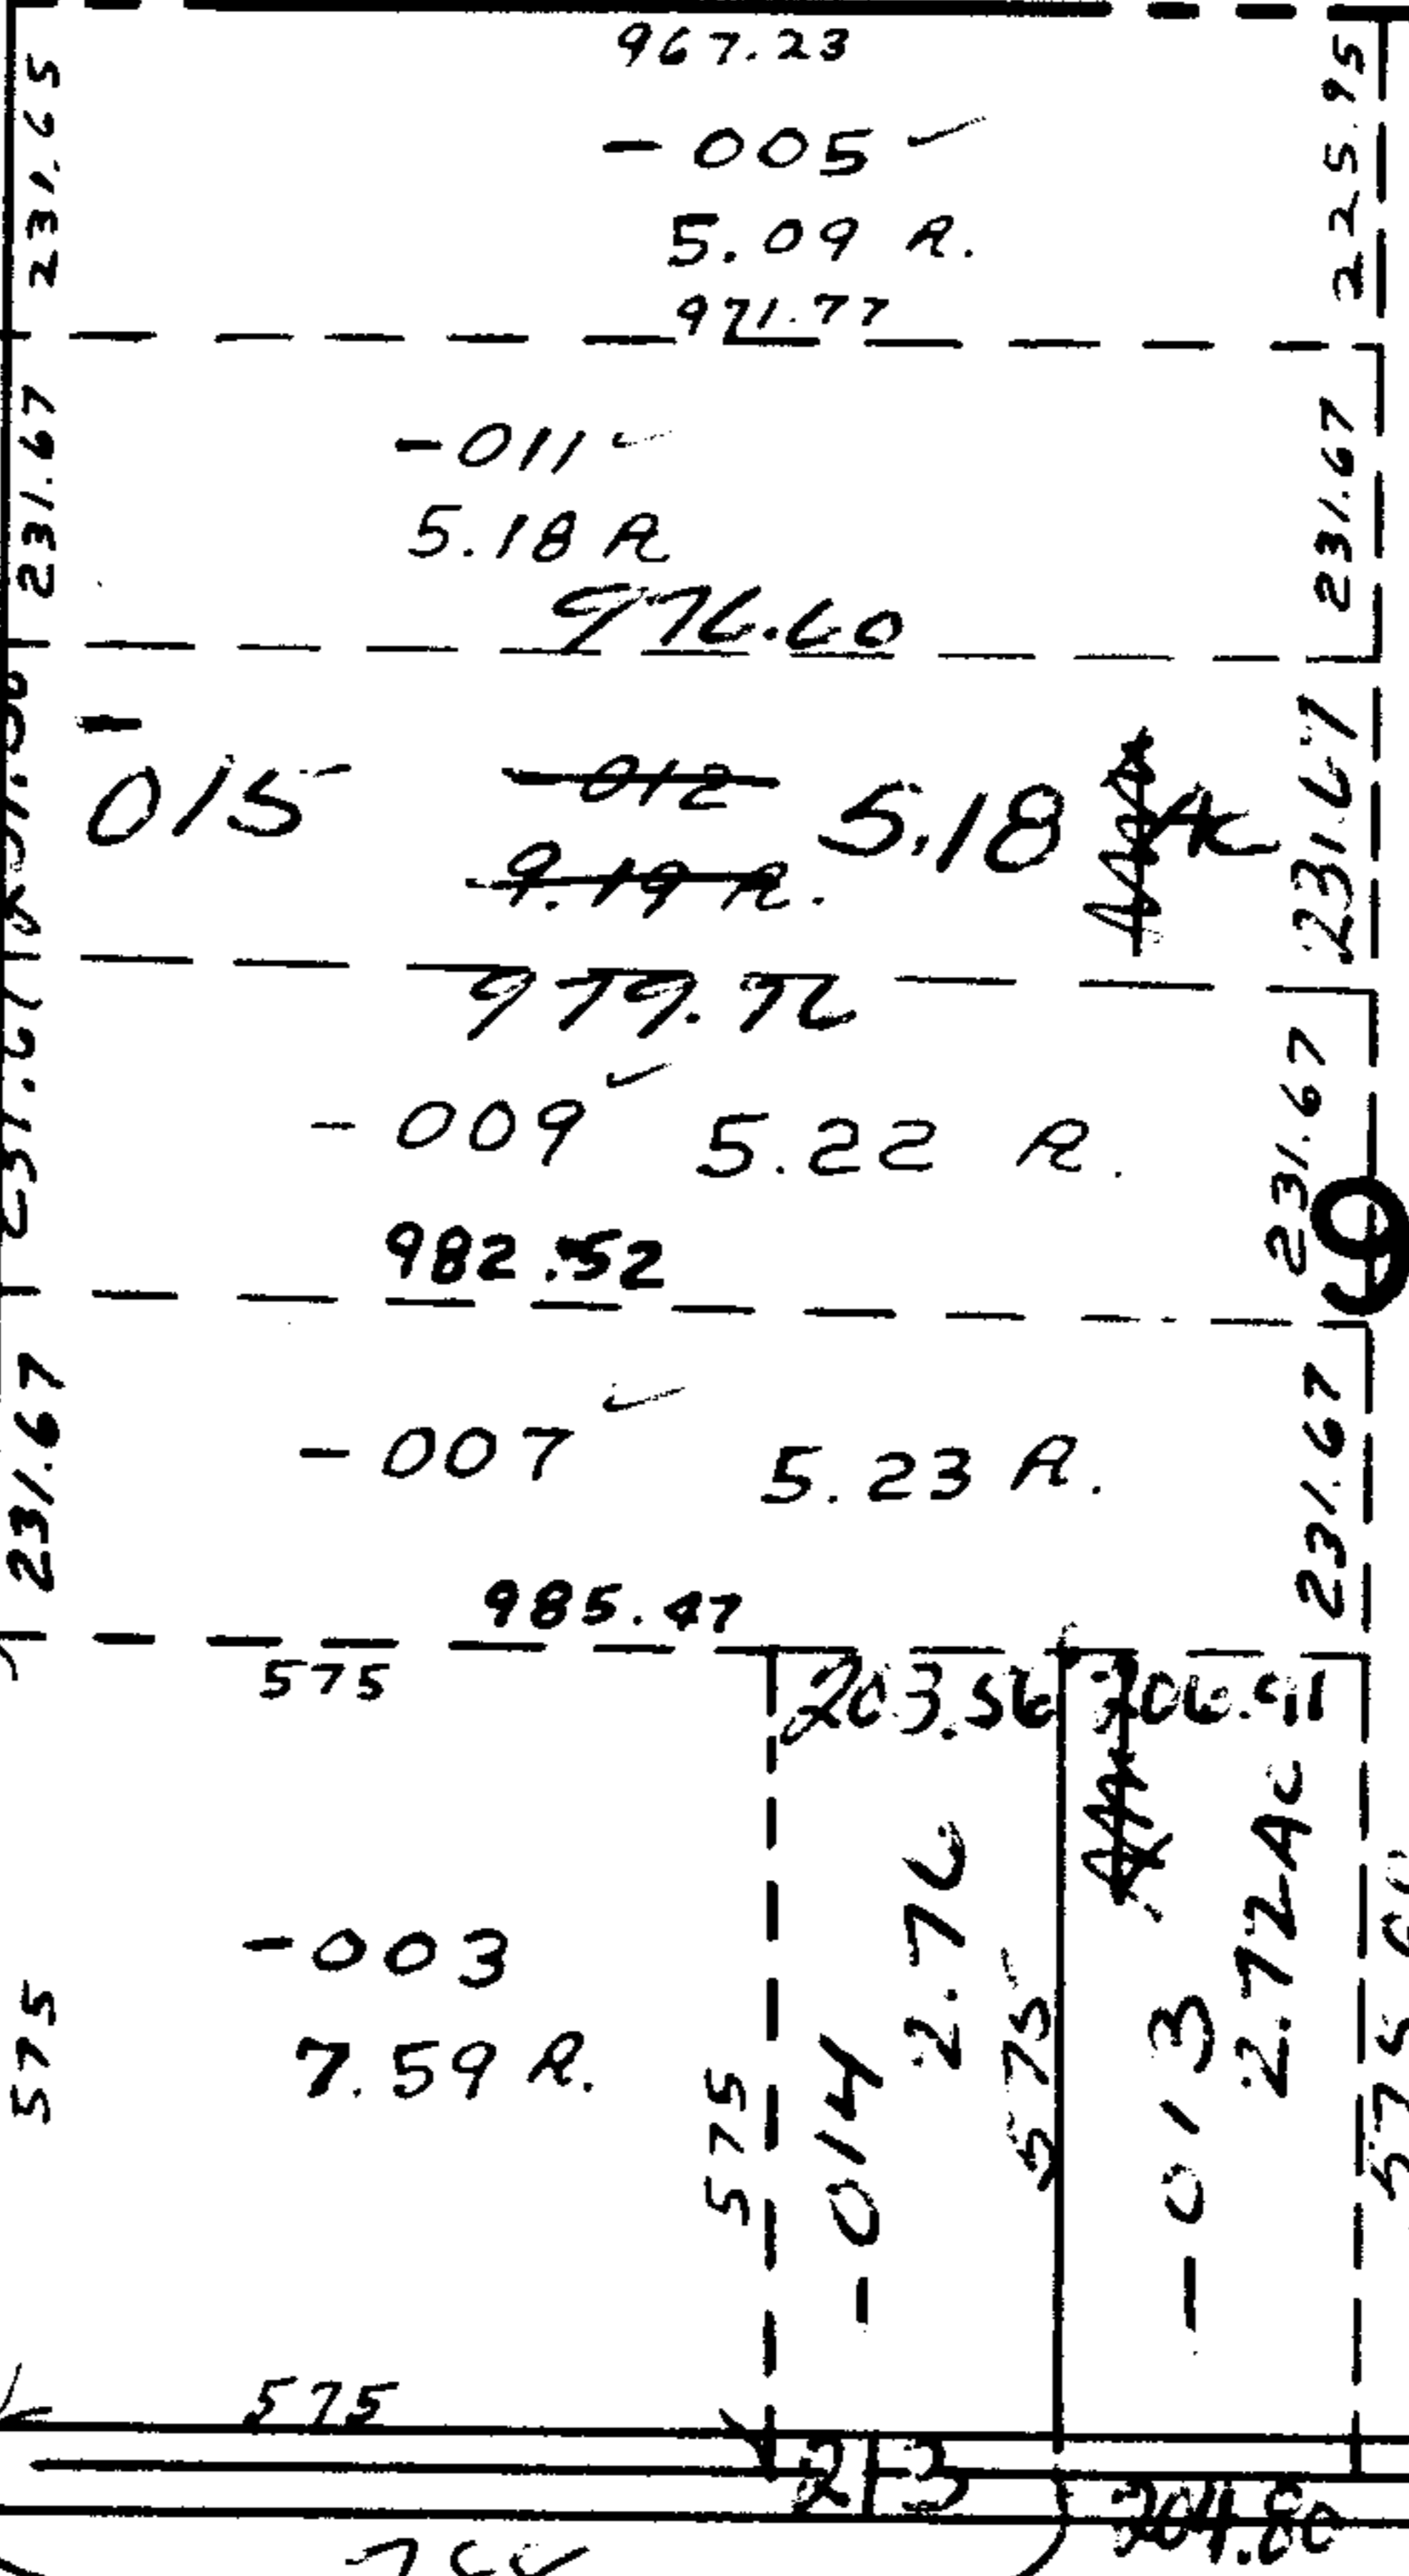

8

-002

39.00 A.

Austin

RD.

(60)

-002
73.00 A.

11

-001
70.00 A.

10

7242

APPROVED
LORAIN CO
MAP DEPT.
DATE 8-1-73
134
BY L. H. Hall

7798-62-6

[Handwritten signature]