


7252

108

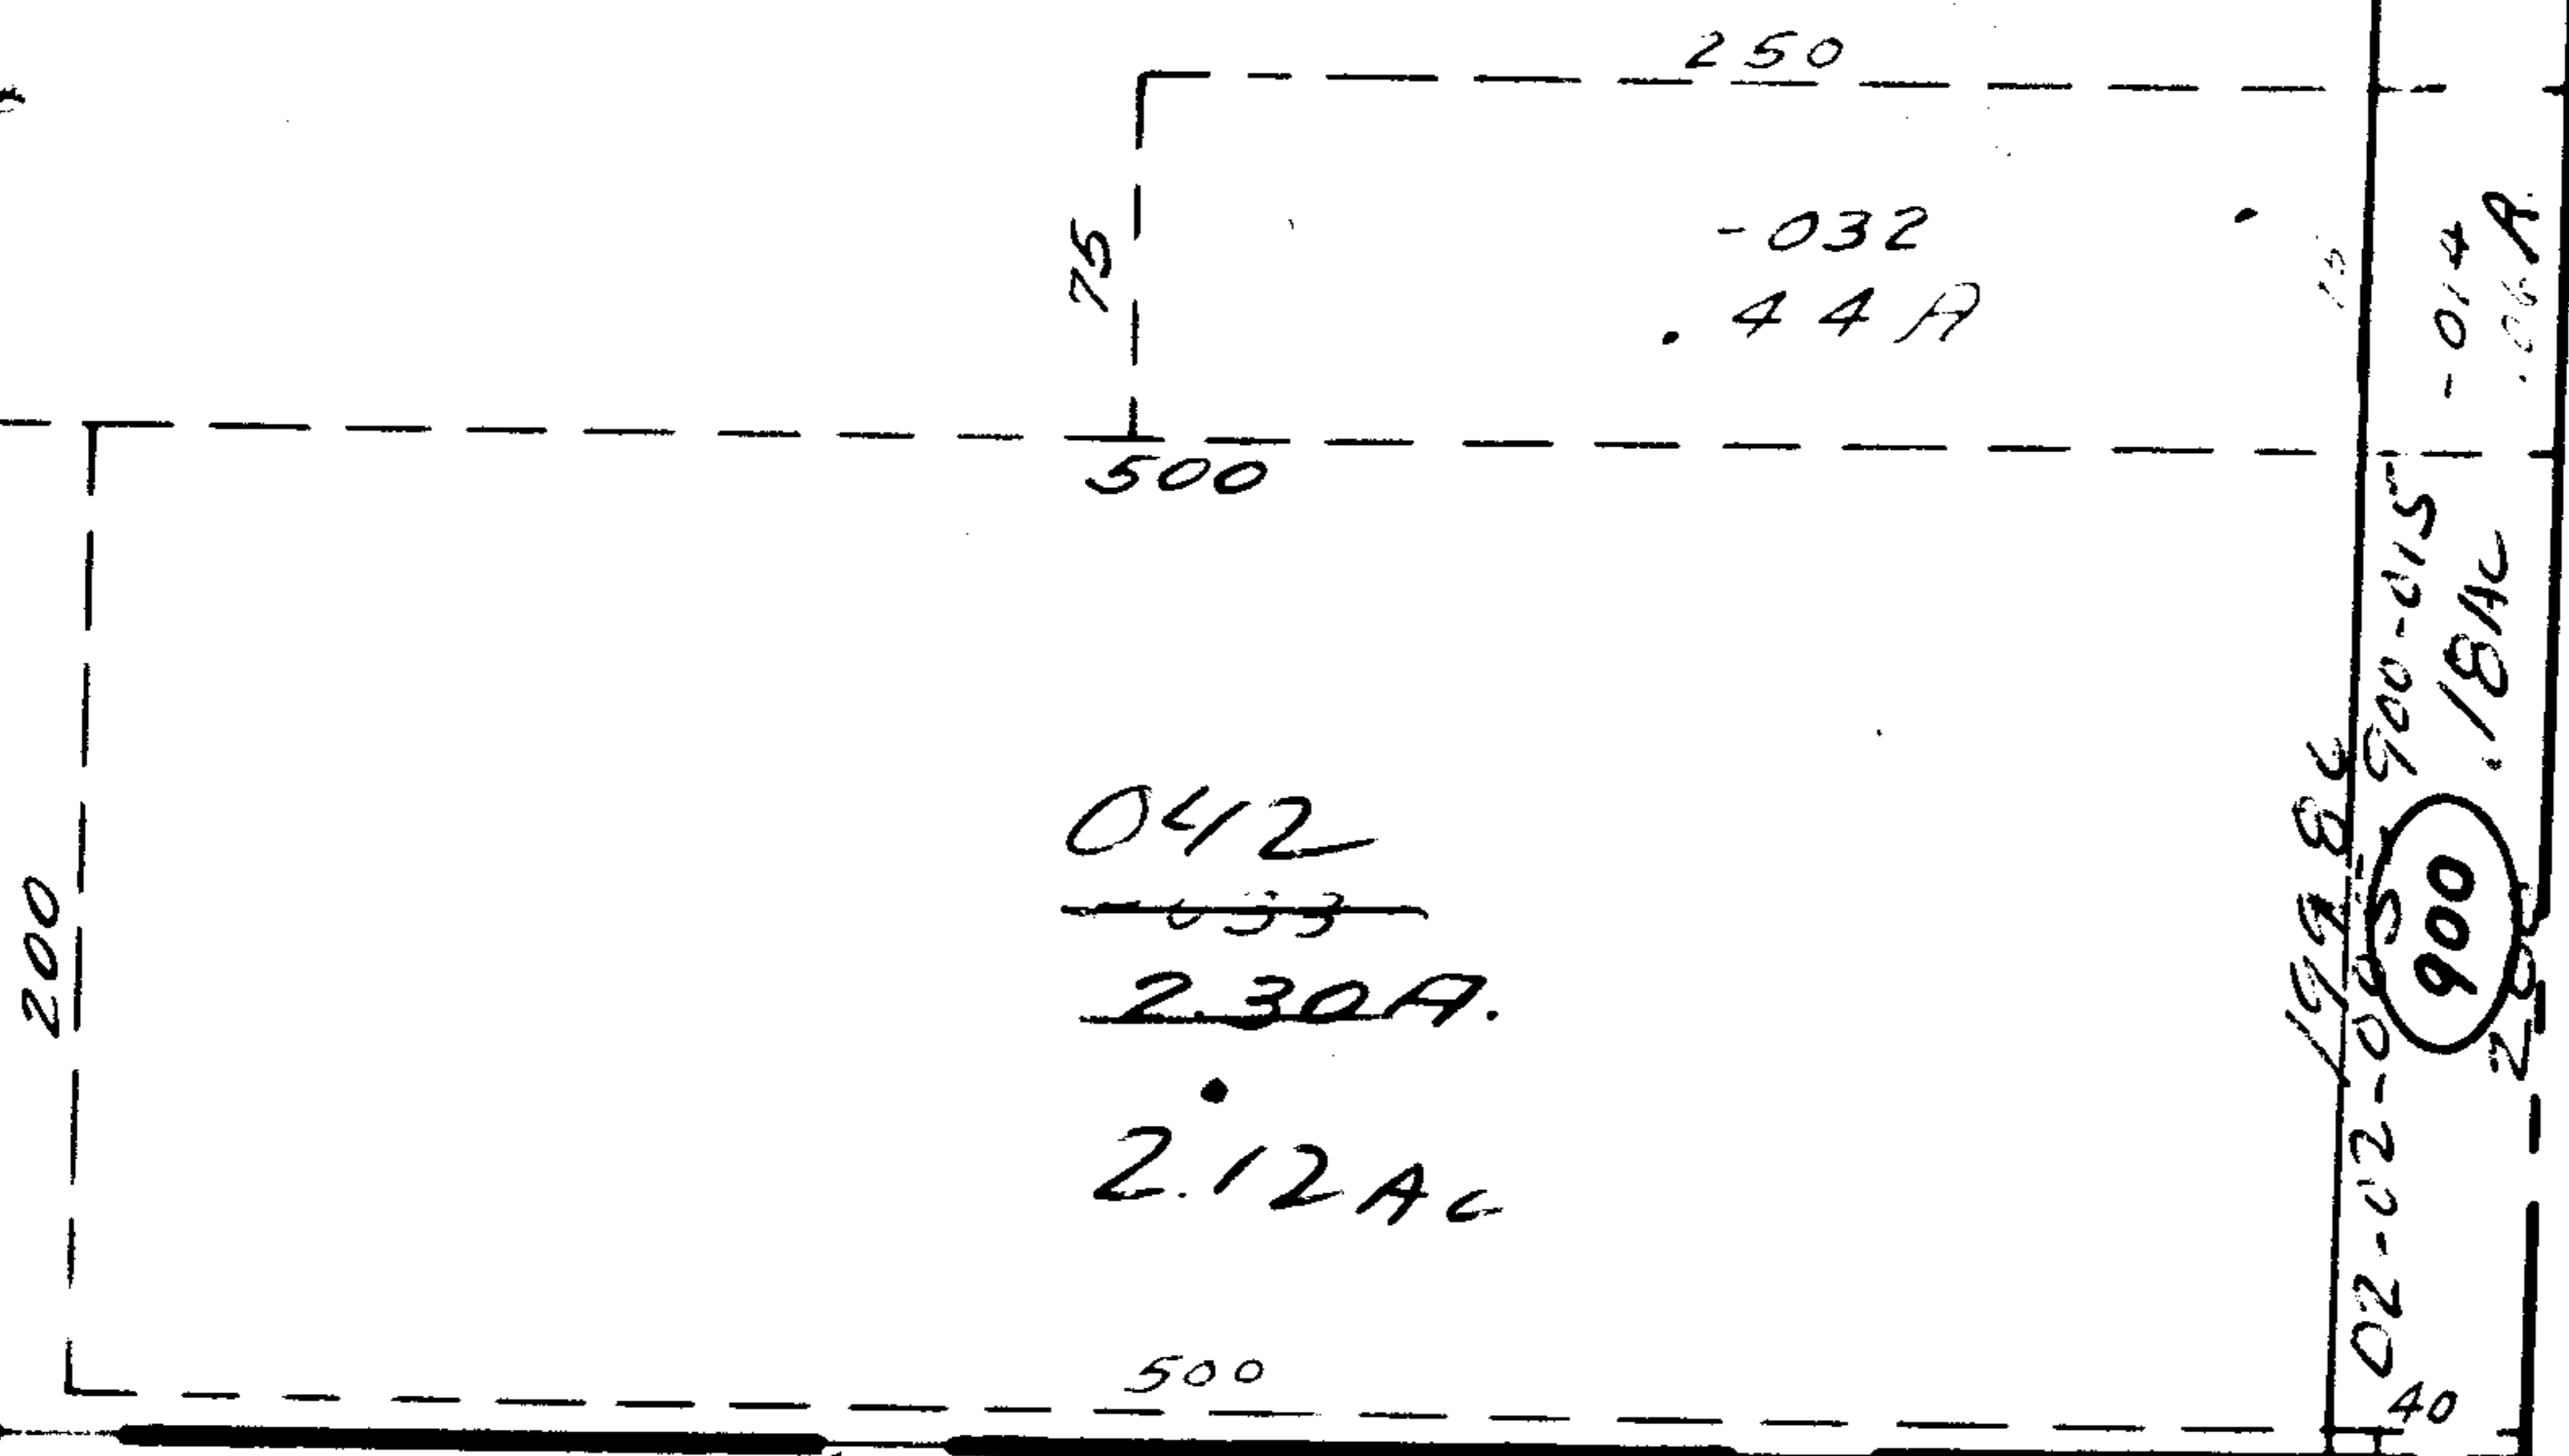



[Handwritten signature]

DICATION PLAT V.27 P.61 DR. 60

OK

7252

APPROVED
LORAIN CO.
MAP DEPT.
 DATE 8-2-73
 02-02-005B
 BY L W Hall

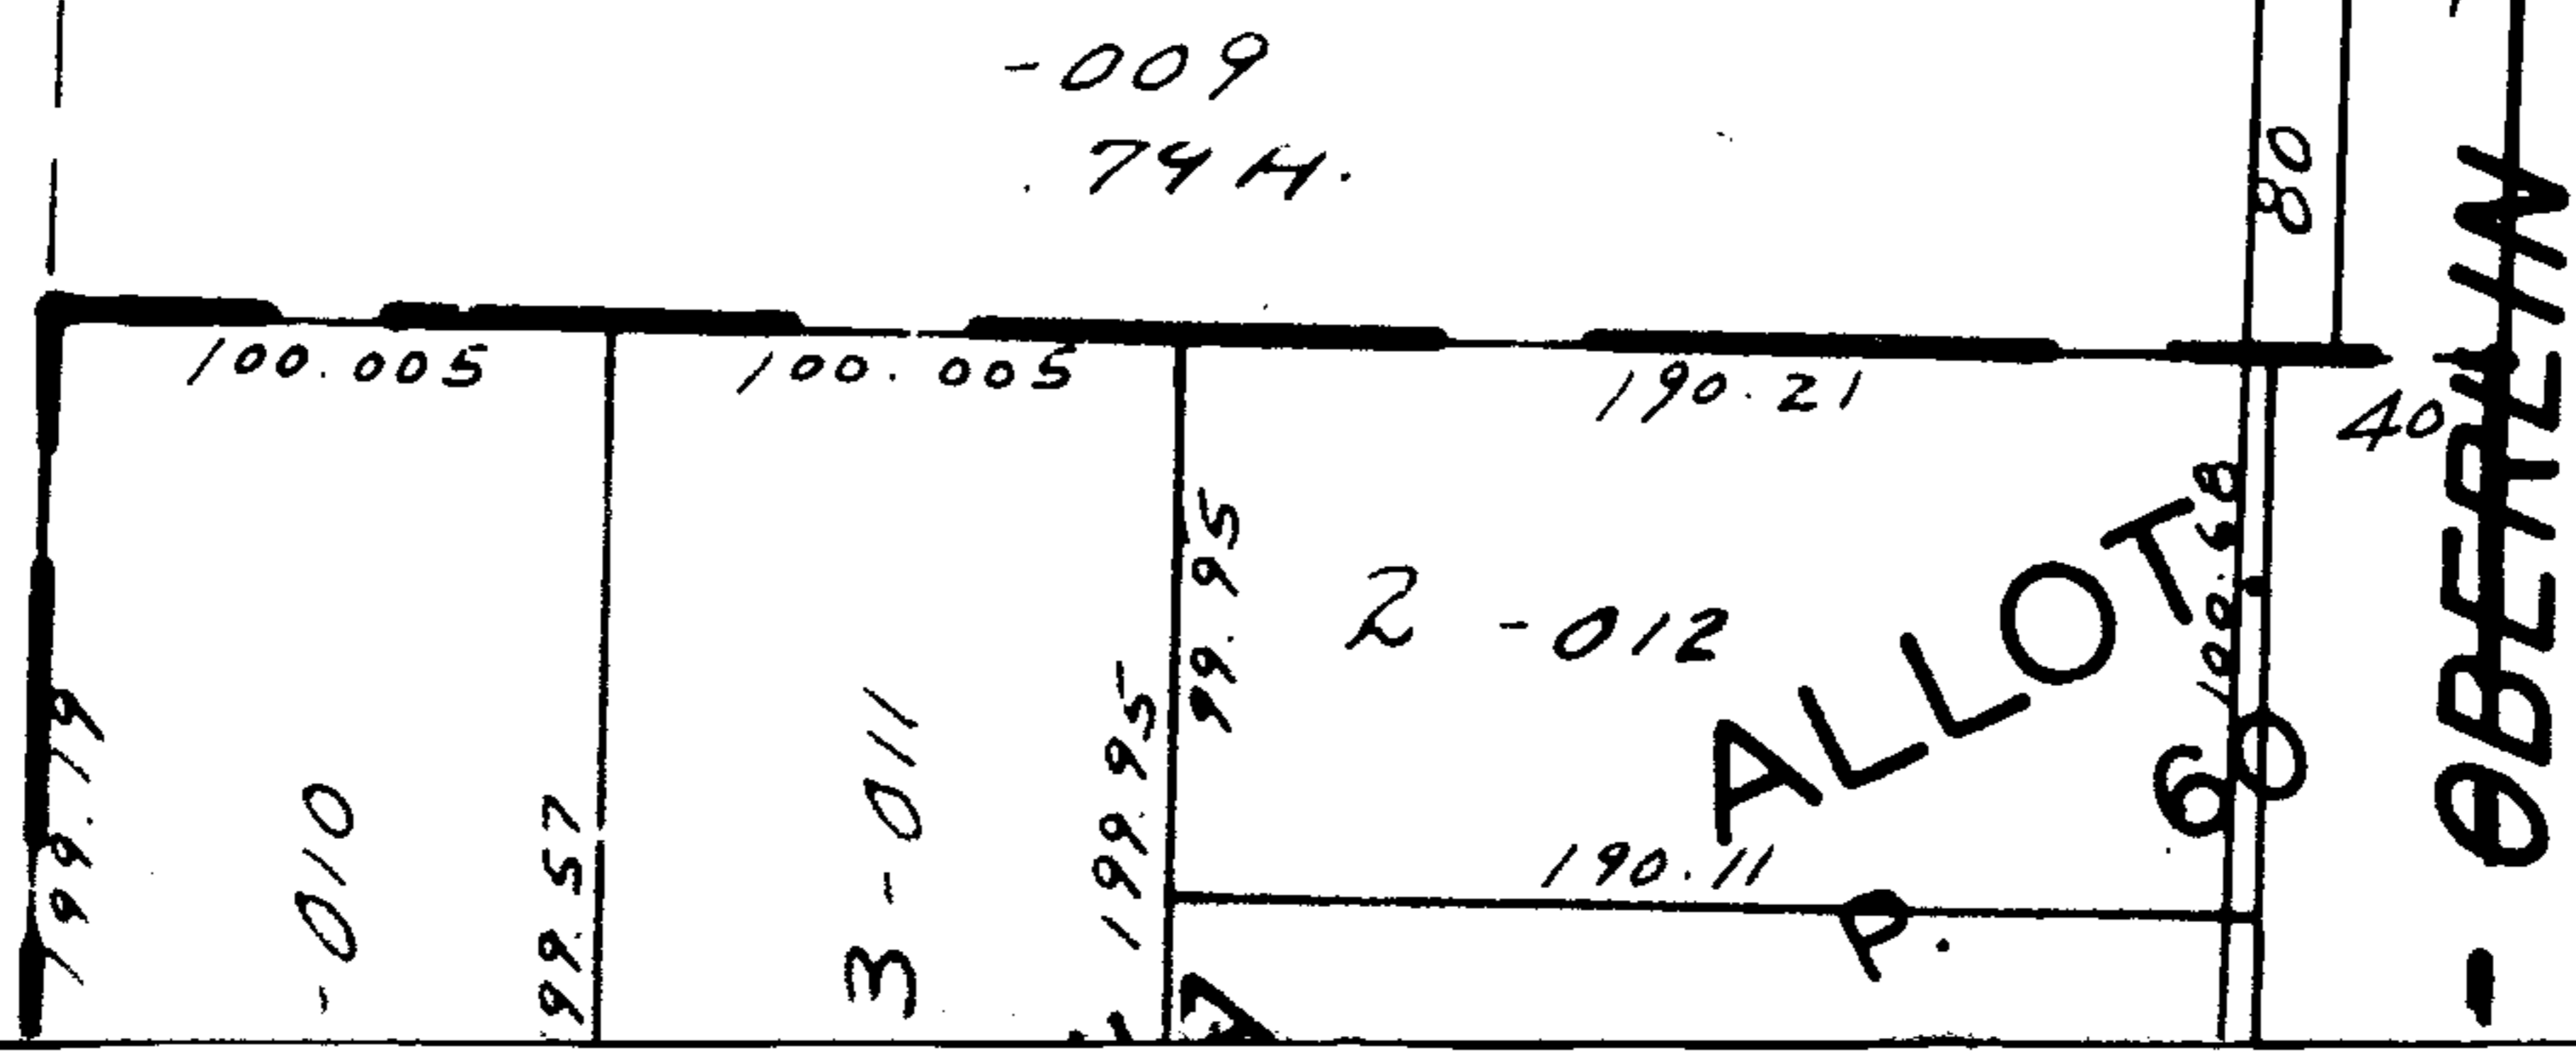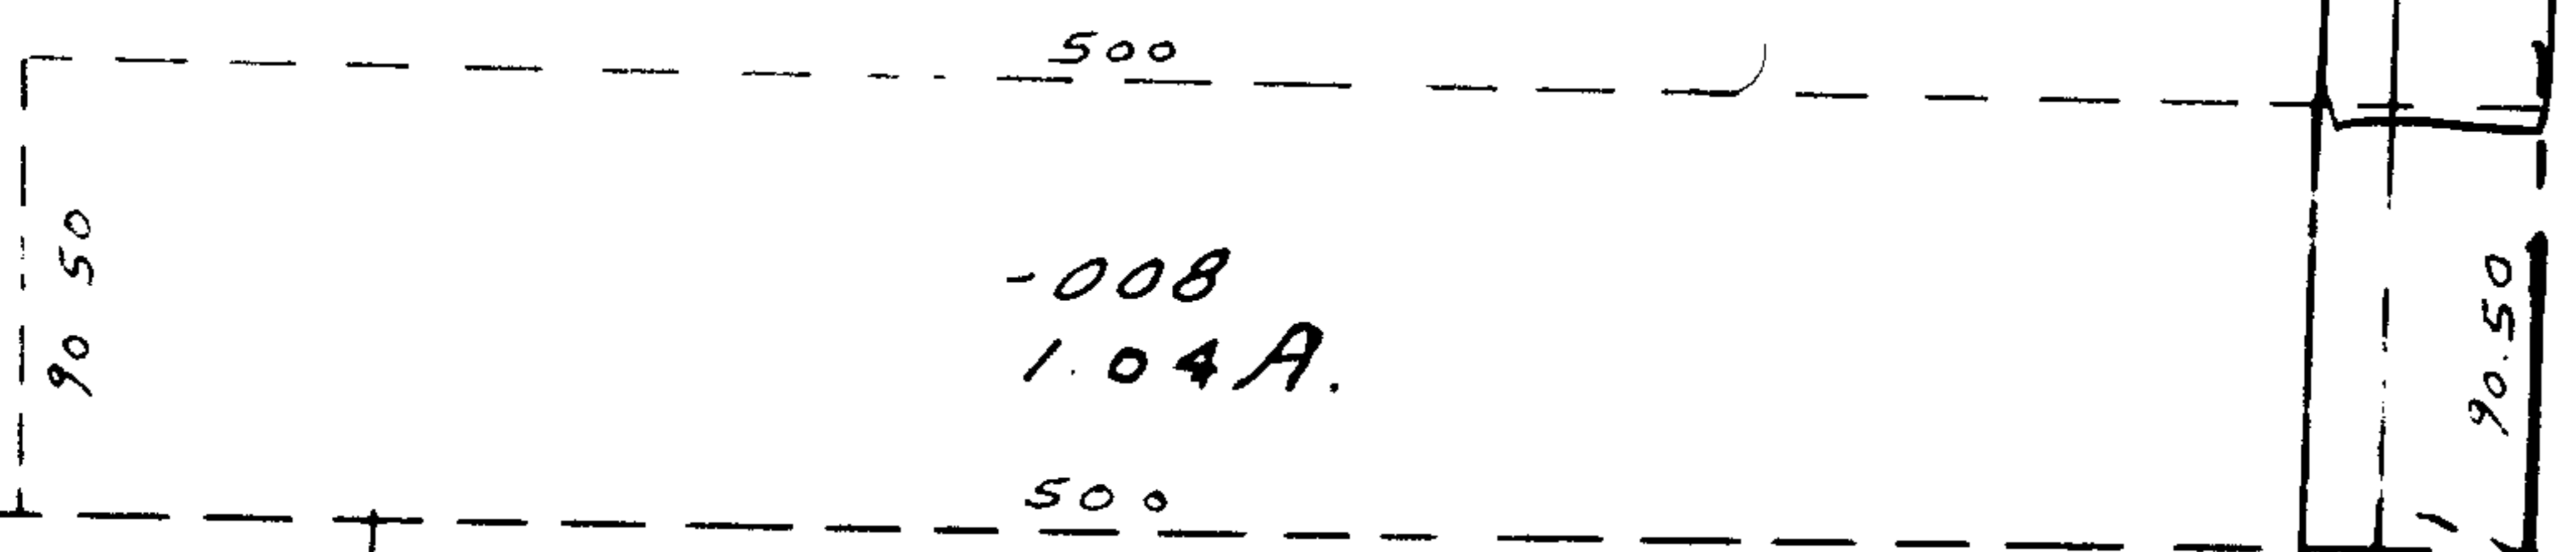

- OBERLIN