

7256


OK

*Handwritten scribble*

7256

APPROVED  
 LORAIN CO.  
 MAP DEPT.  
 DATE 8-2-73  
 10-00-005-D  
 BY *[Signature]*

*p. 8*

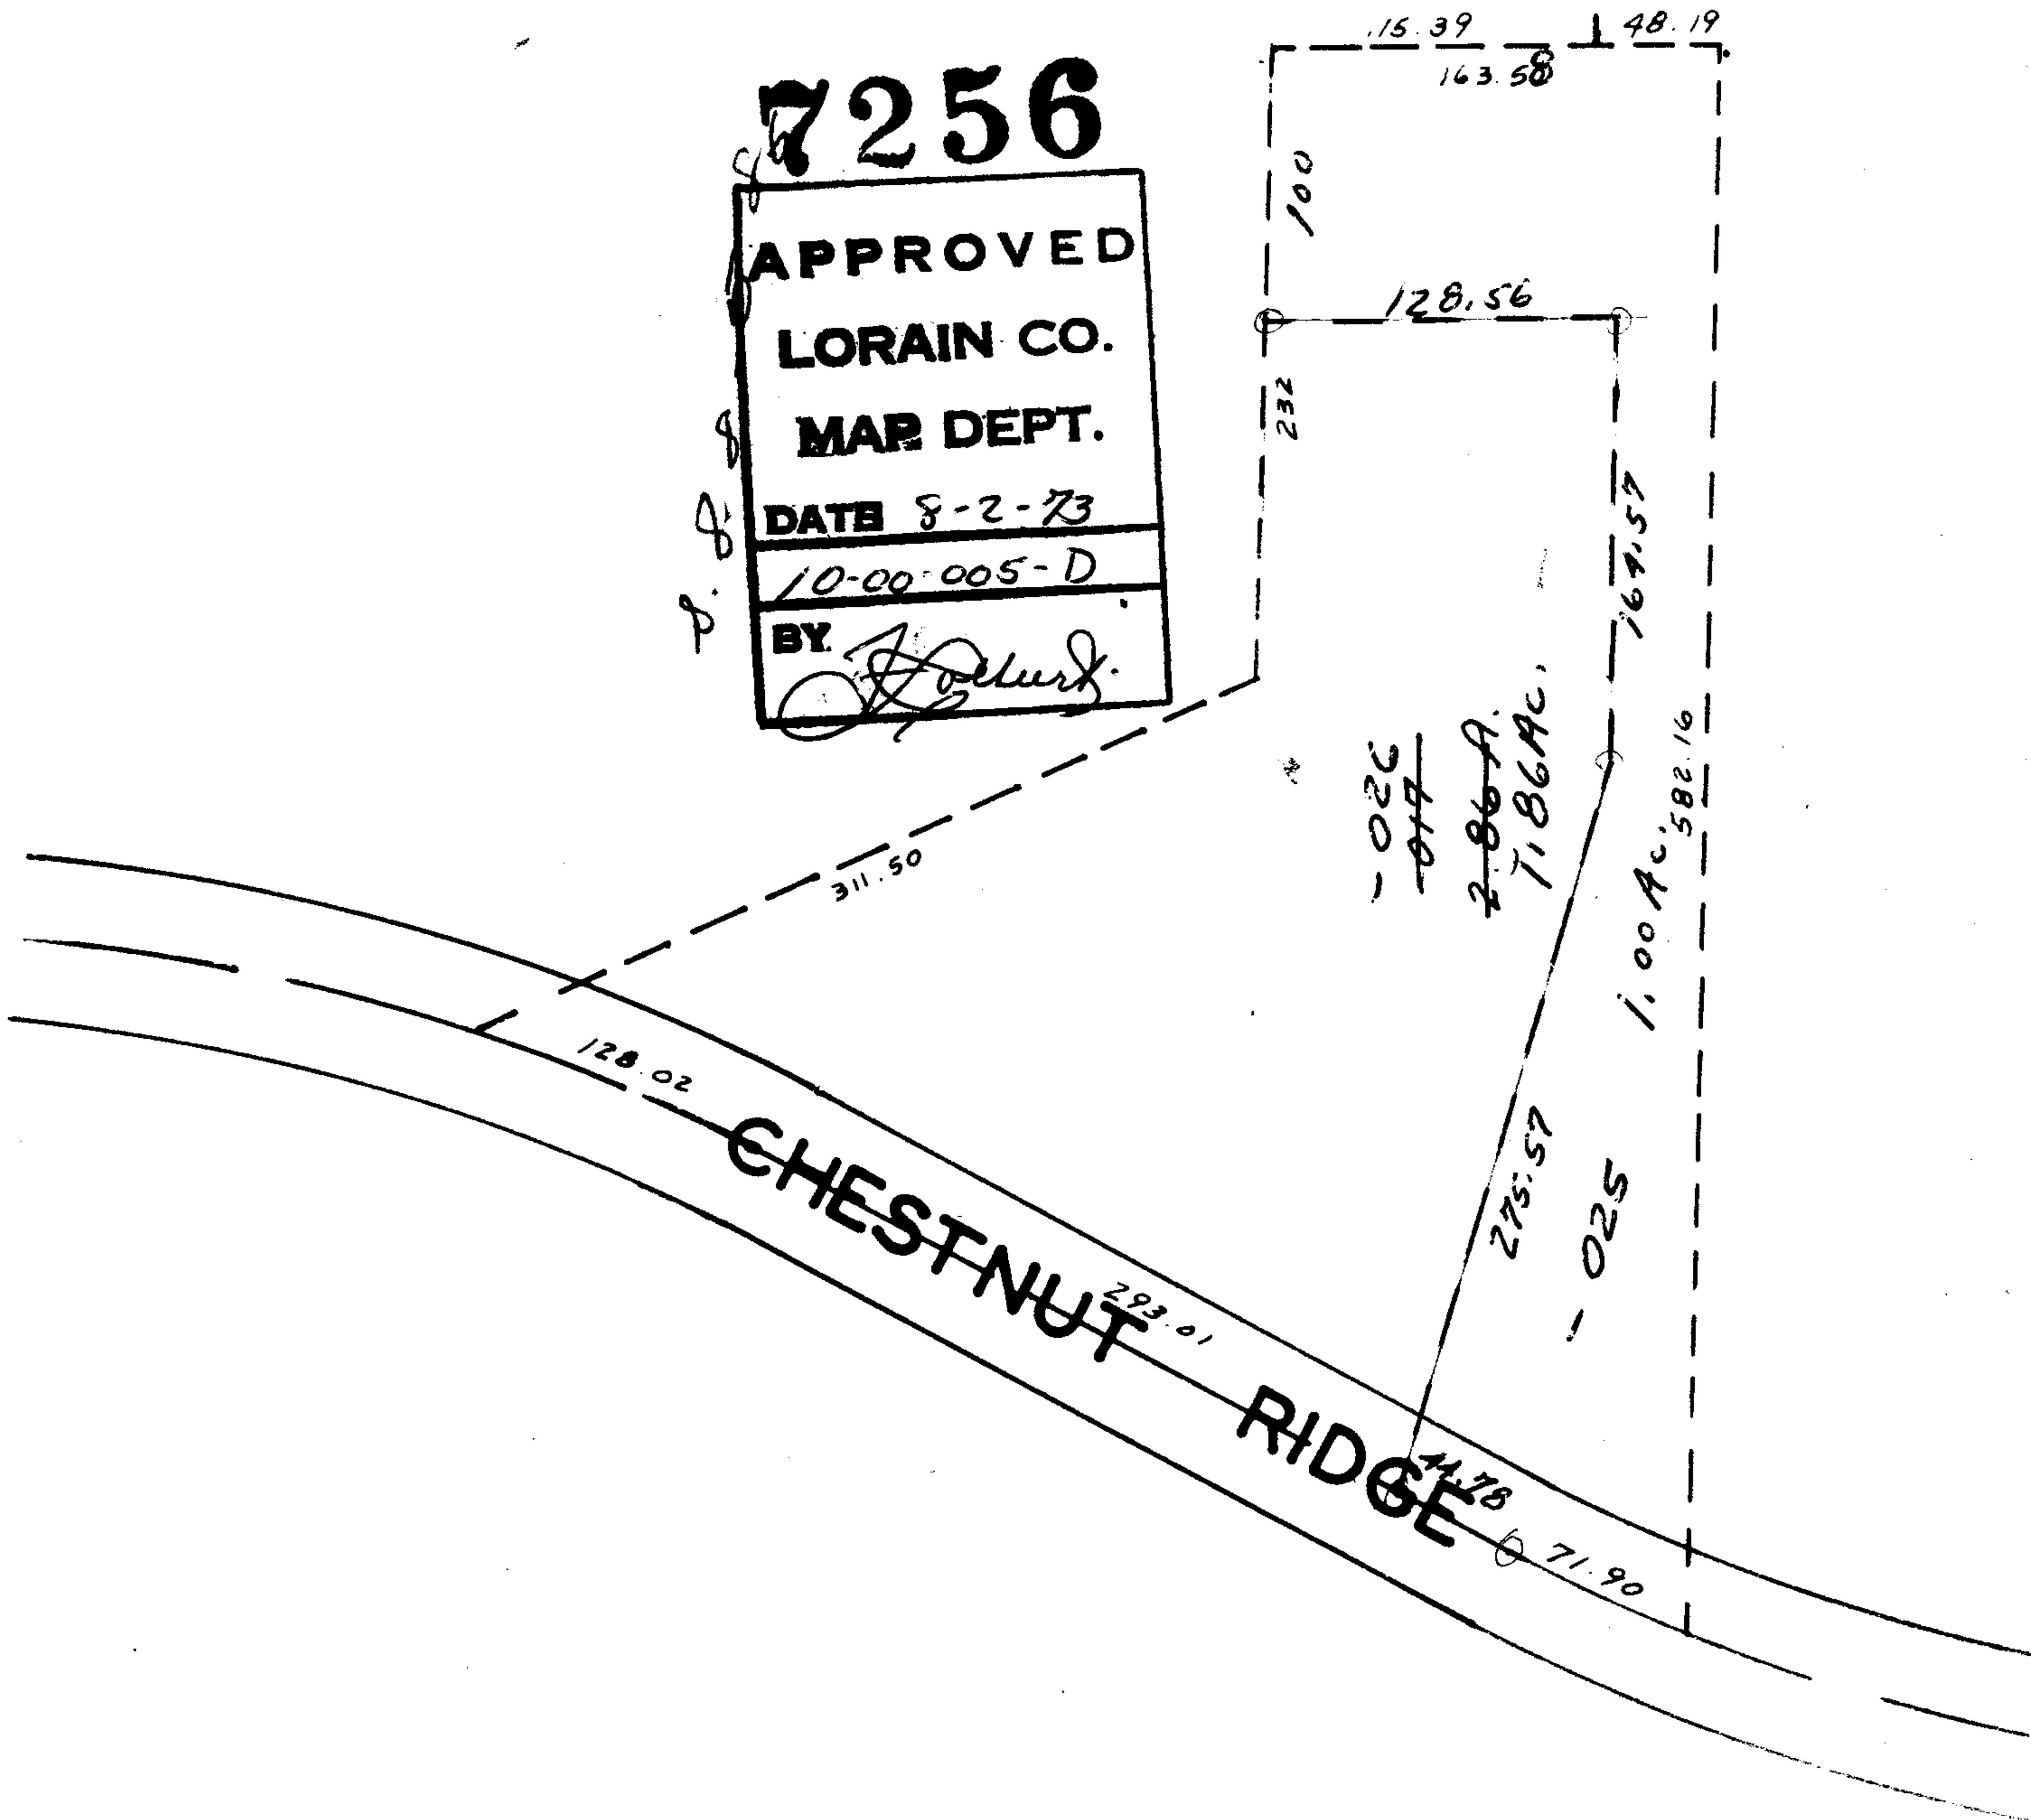

CAP