

7259

SEE 7-00-027-A

72
2/2

OHIO

PT. -034

PT. 17.47A.

-003
.92A.

1234.19

263.80

55.54

53

see
SURVEY

-023
1.83AC

See
Survey.

OK

7259

APPROVED
LORAIN CO.

MAP DEPT.

DATE 8-16-73

07-00-027C


BY

L. W. Hall

024

~~-002~~
18.54F.

110.71AC

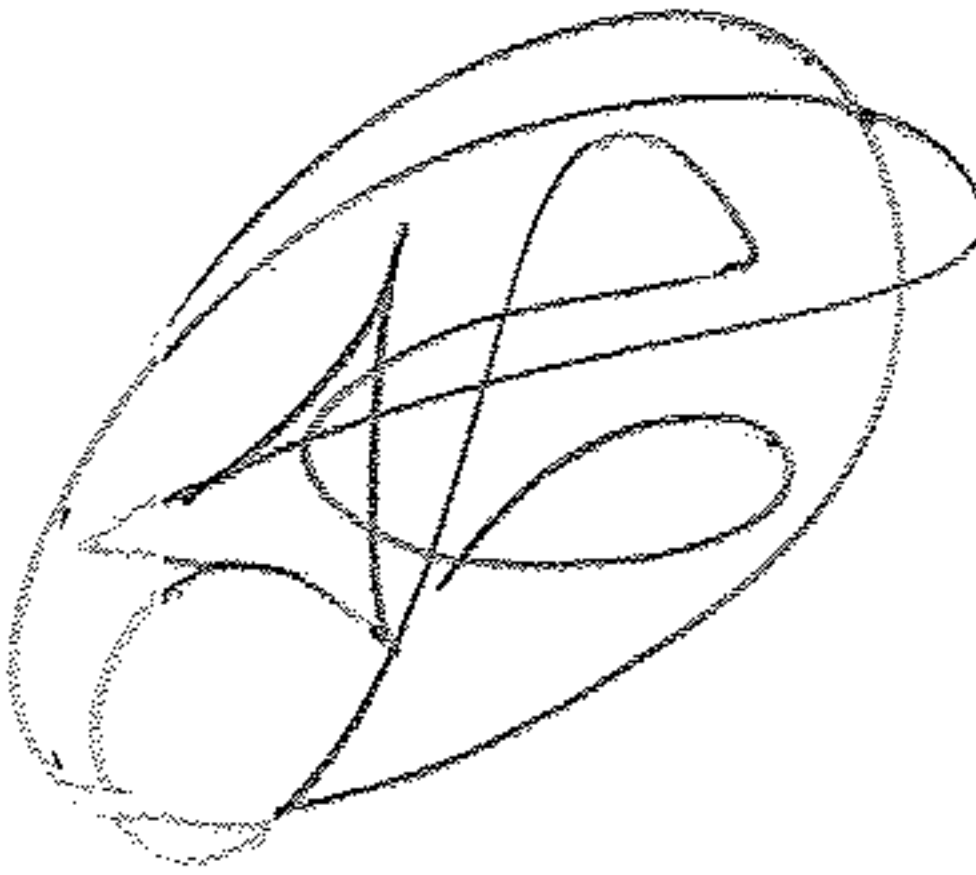

109

220.40

-004
.55F.

220.40

1232.77

018
3.73A.

1232.77

RD.

312.55

007 Delele
227.75

48.05

158.53

64.70

29.816

SEE 7-00-034-D

108

108

131.78

679.59

131.78

1689.0
1681