

76.15 H. Map 9 U.
93.00 A. Dup.

7272

R

3995±

885

2313.96

T

-002
38.00 A.

-001
12.00 A.

OK

23

7272

APPROVED
LORAIN CO.
MAP DEPT.

DATE 8-10-73


ZIH

BY

L.W. Hall

ZIH


P-5-86

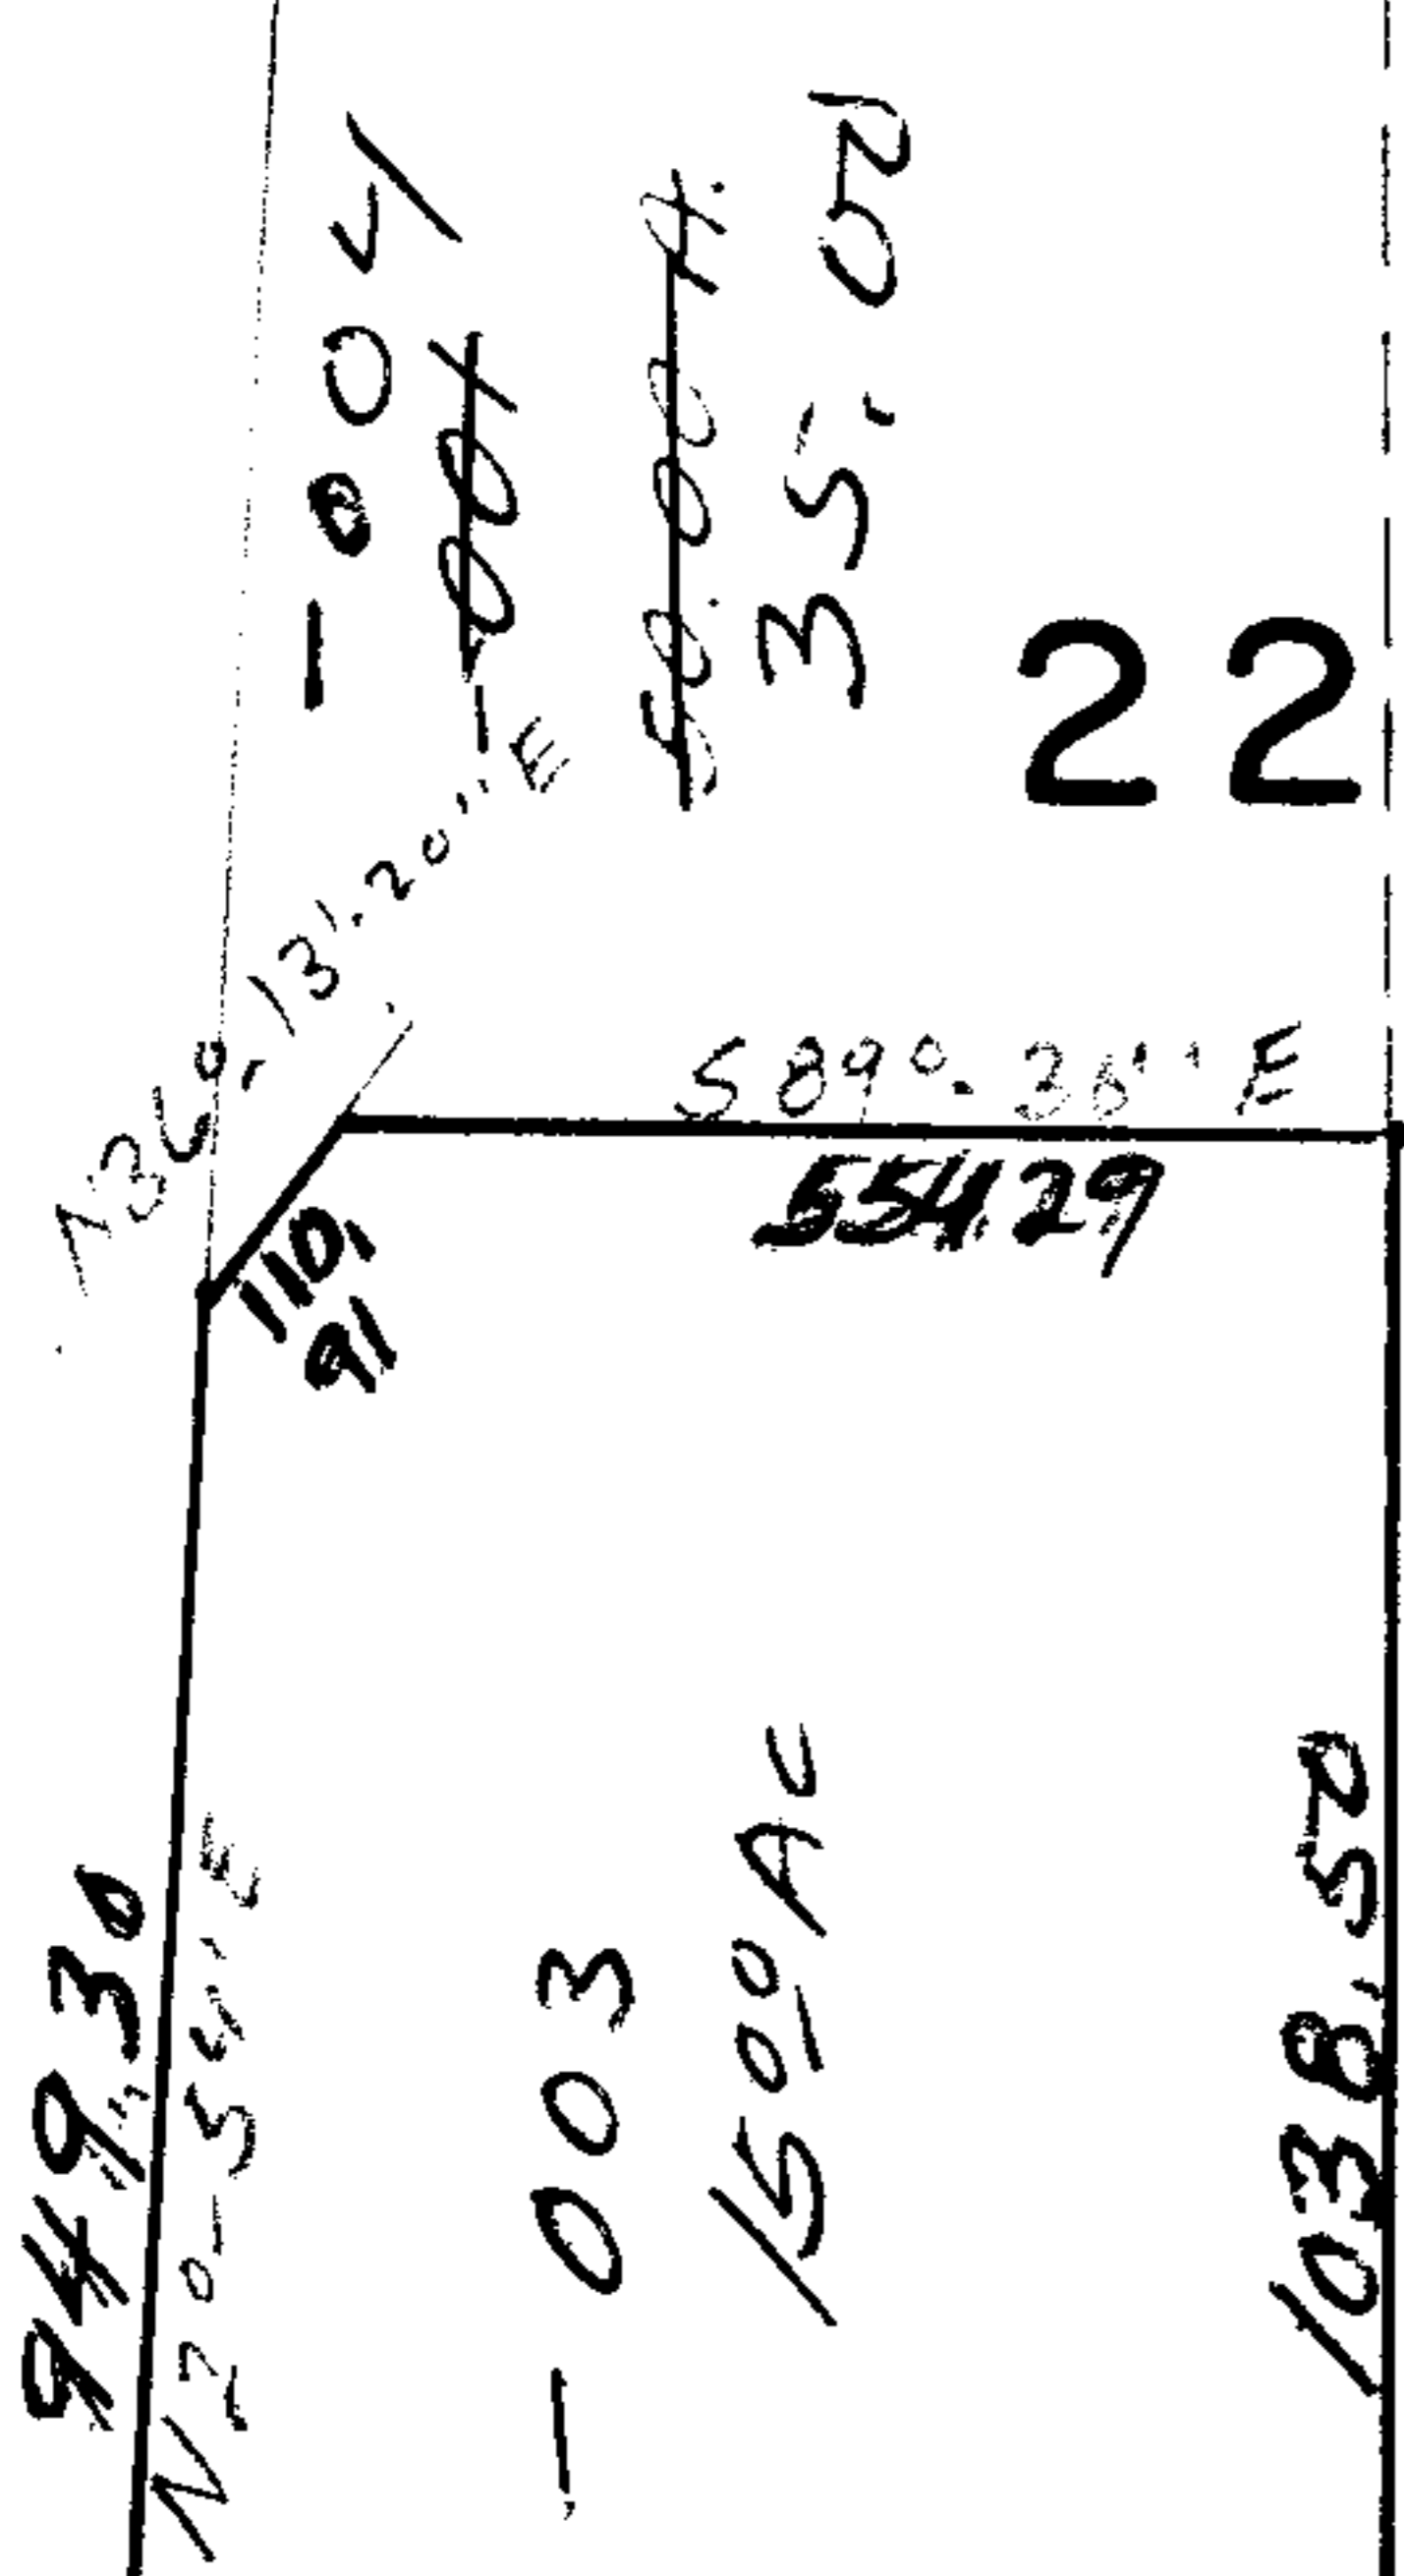

EASTERN

885

2317.26

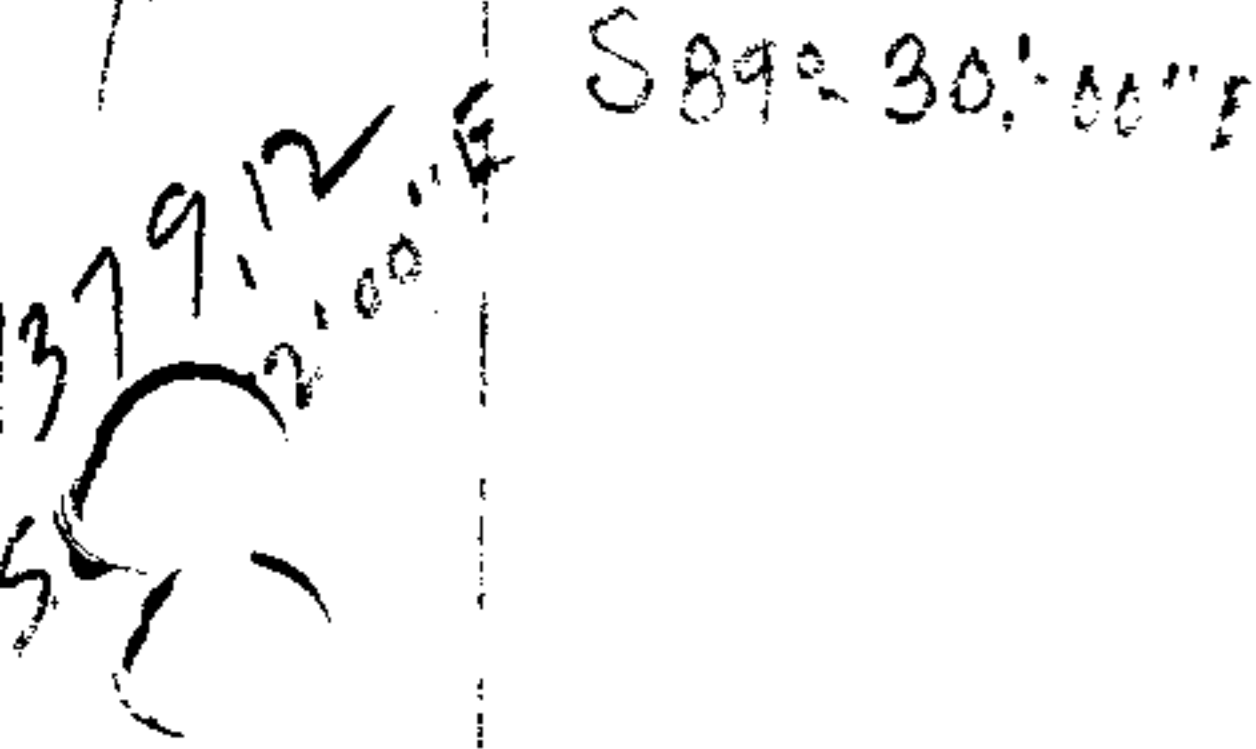

3

-003
36.00 A.

-009
12.24 A.

-007
12.43

-008
11.19 A.

4

