


7282
7297
7306

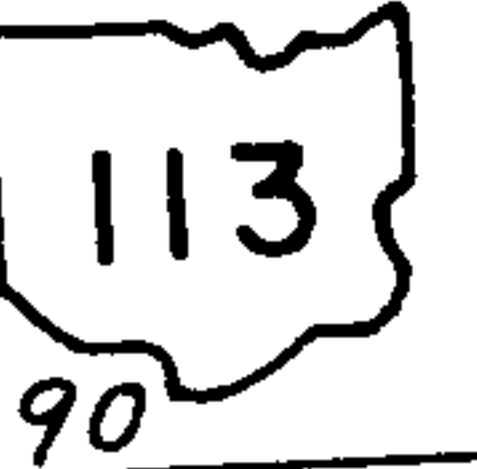

MILAN - ELYRIA

7306
7297
7282

OK

APPROVED
LORAIN CO.
MAP DEPT.
DATE 8-15-73
5-G 45-00-049-000-022
BY *[Signature]*

PT. 18.72 A.

PT. 05-00-049-000-022

532.63

-046
1.10 A.

590.58

89.64

-039
1.00 A.

272.78
271.93

66.98

90

66
102.22

107

139.93

94°15'

373
187-20-873
-049
-032
477A
92 Ac.
191-80
191-80
191-80

373
-047
1.00 Ac.
175

PT. 05-00-049-000-009
PT. 20-82A

107

145

198

Pt 05-00-049-000-022

Pt. 19.82 Ac
19.37 Ac.
-024
19.37A

SEE CORR
#15738
8-9-84

2339.95

SEE 5-G

CHANG NUMBER ON 5-G